


0.48A 0.09A 0.L.100  
0.38A 0.2. 1

ELYRIA  
MEDINA  
RD

SEE II-00-100-B

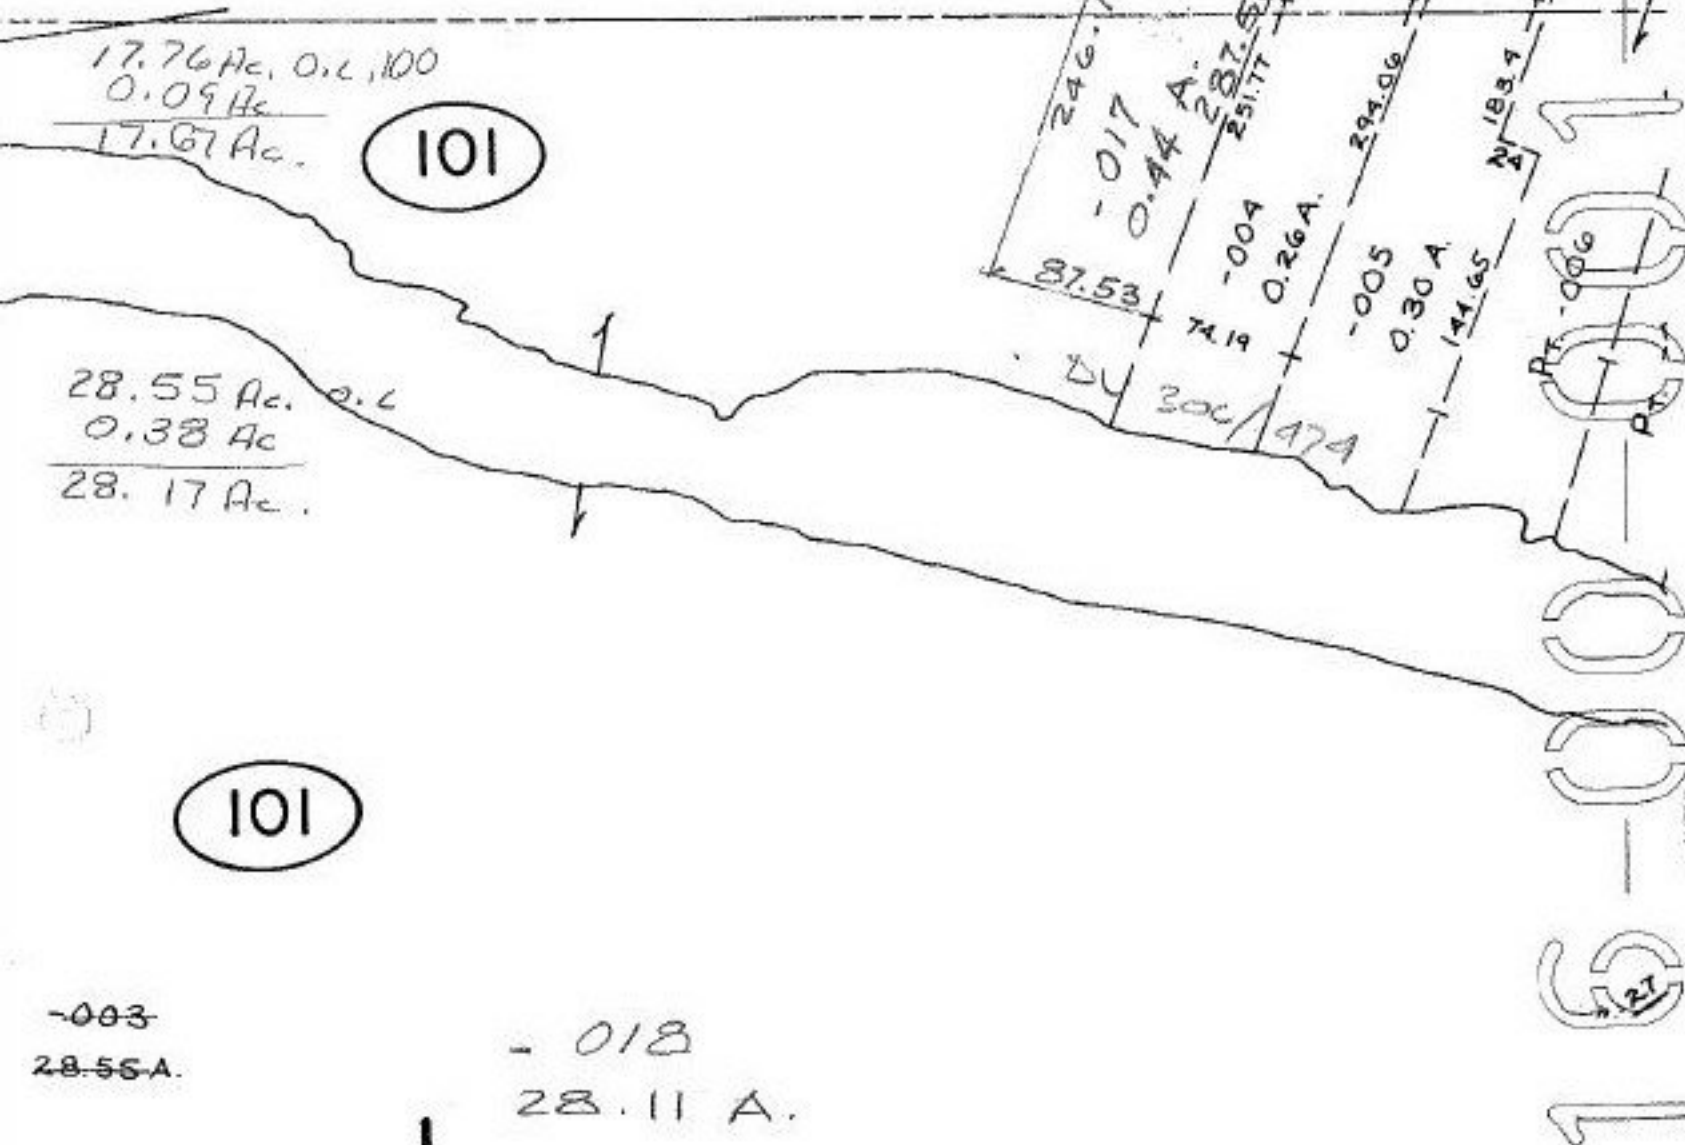

-003  
28.55A.

- 018  
28.11 A.

P.P.NO. 16-00-001-101-
PRIOR INST: DV. 306/474
DV. 1289/133
CLOSURE: C=1:96,611
SURVEYED BY: ROGER SIMON
XEROX REG. SURVEYOR

AUG 3 1994  
20684

APPROVED
LORAIN CO.
MAP DEPT.
DATE 1-11-94
PAGE 16-00-001-B
CAROLYN
BY FRANCIS
VOID
ENTER # 20684

-002  
A.18 A.