


ACREAGE
CORRECTION

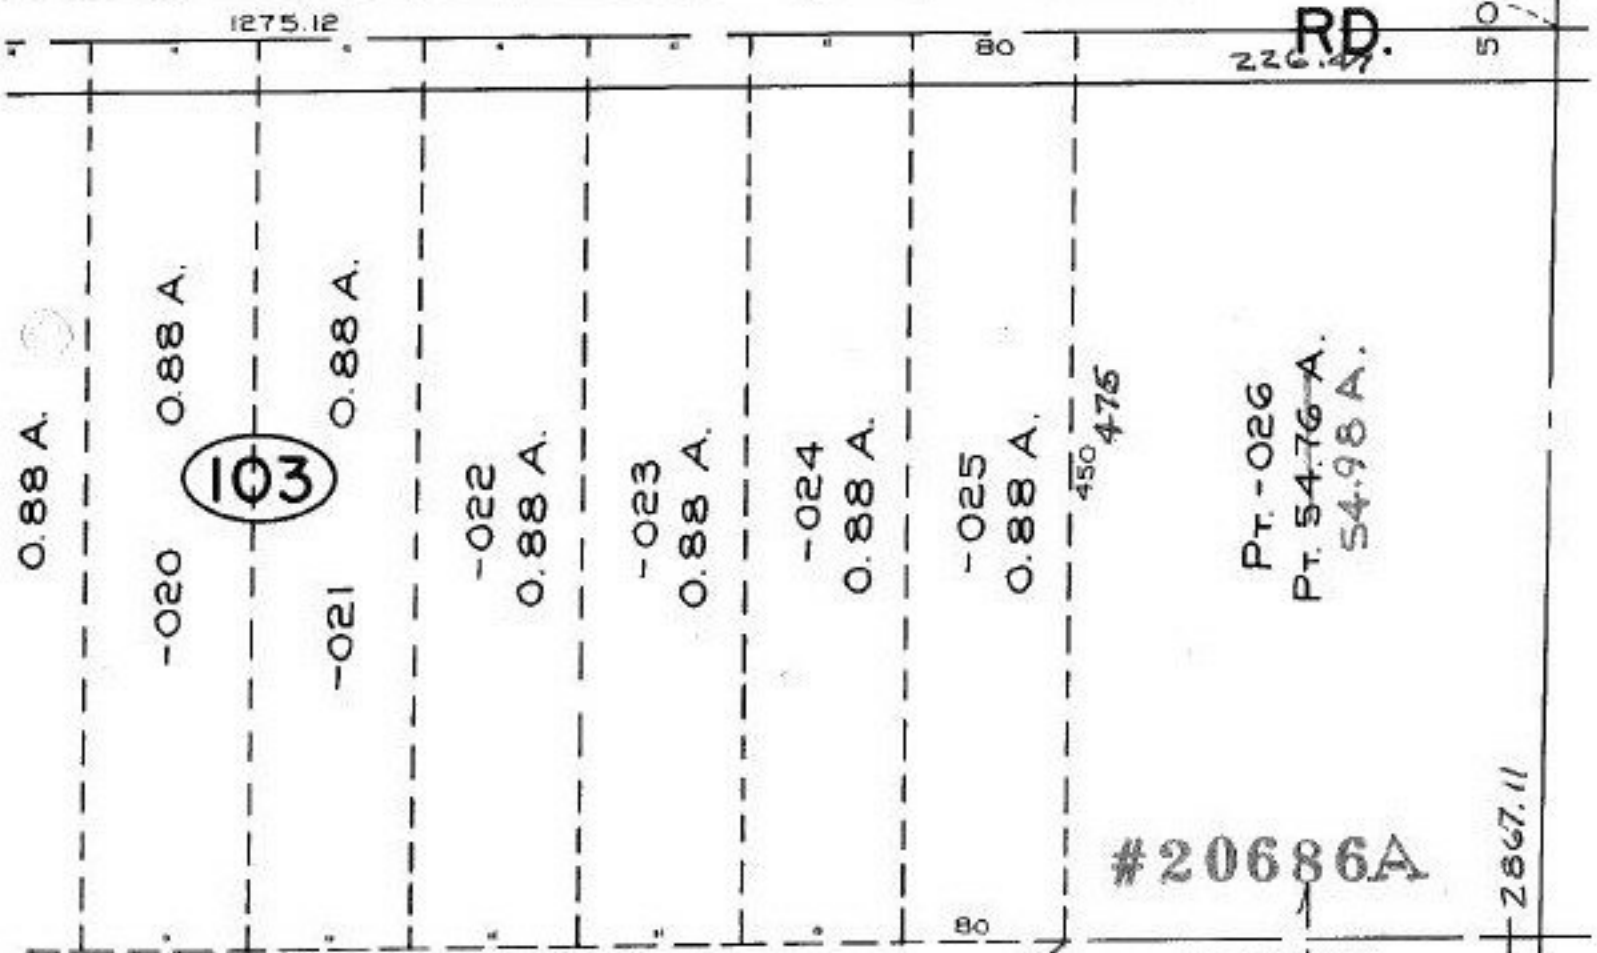

SEE 7-H

SM 2/8/94

MAP (5) OF (8)

APPROVED LORAIN CO. MAP DEPT.	
DATE 12-28-93	
PAGE 7-00-011-B	
BY	<i>F. J. [Signature]</i>
VOID AFTER	20686A