

SEE 11-00-089-B

2069

1932.72

Changed Lines As
Per Deed Vol.
965/118

12-2-87

-028
.57A.


~~215.80~~ 195.80
195.80

-030
.50A.

143.00

128.92

RD.

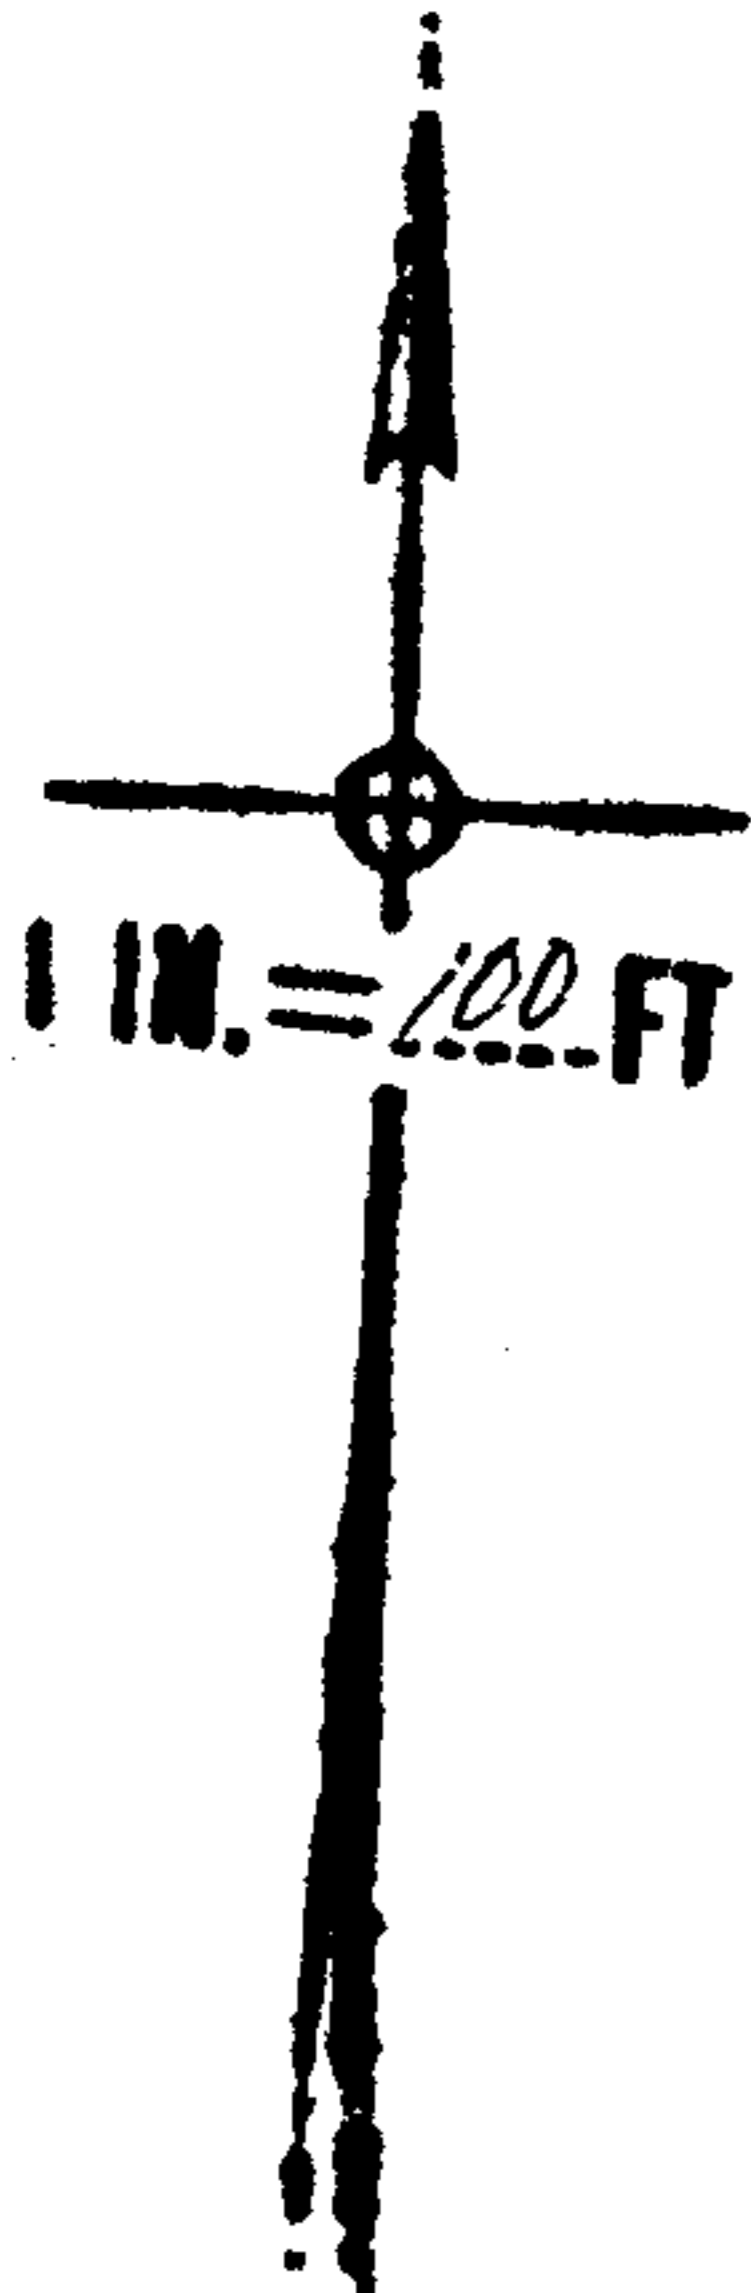

~~-031~~
~~-029~~
~~11.63A~~
11.13A


APPROVED
LORAIN CO.
MAP DEPT.
DATE 9-3-68
11-00-088B
BY *Grace*



Date 9/28/68

Grace 753.20

100
231.85
-018
22A.

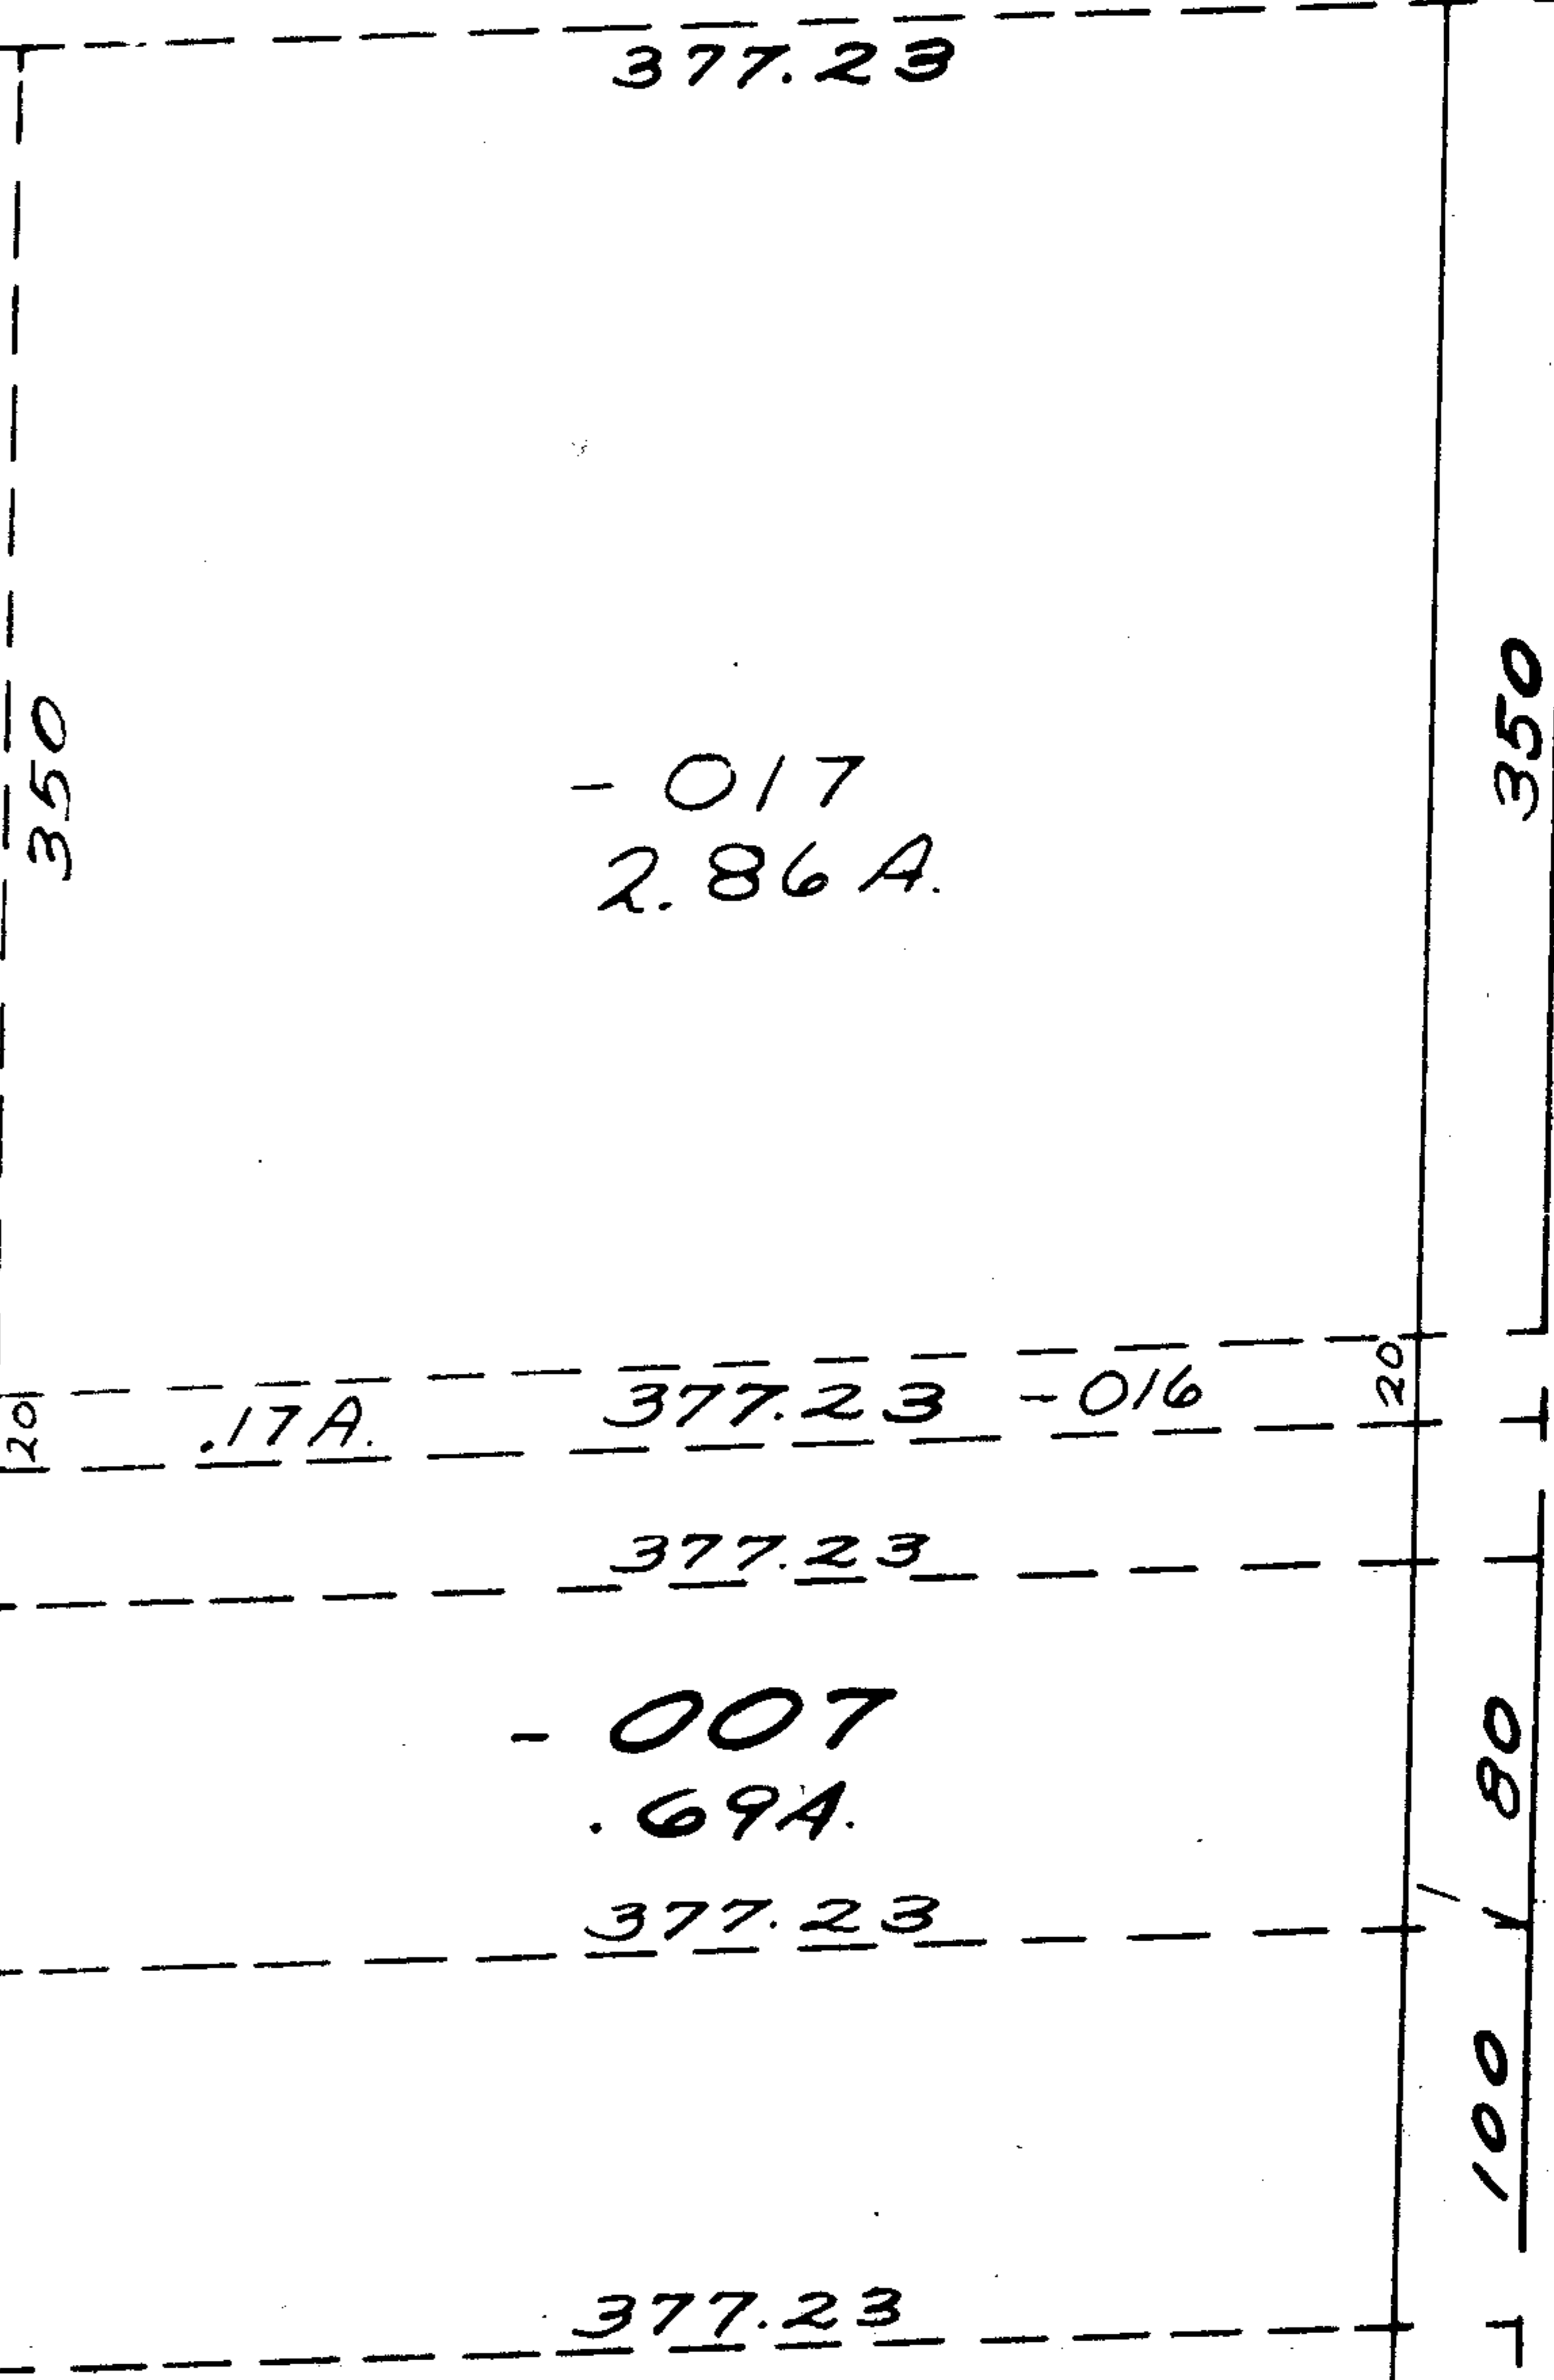

377.23

-017
2.86A.

377.23 -016

-007
.69A.

377.23

-008
2.68A.

377.23

350

100

80

2.15