


BEREA

← -052 36.82 A.

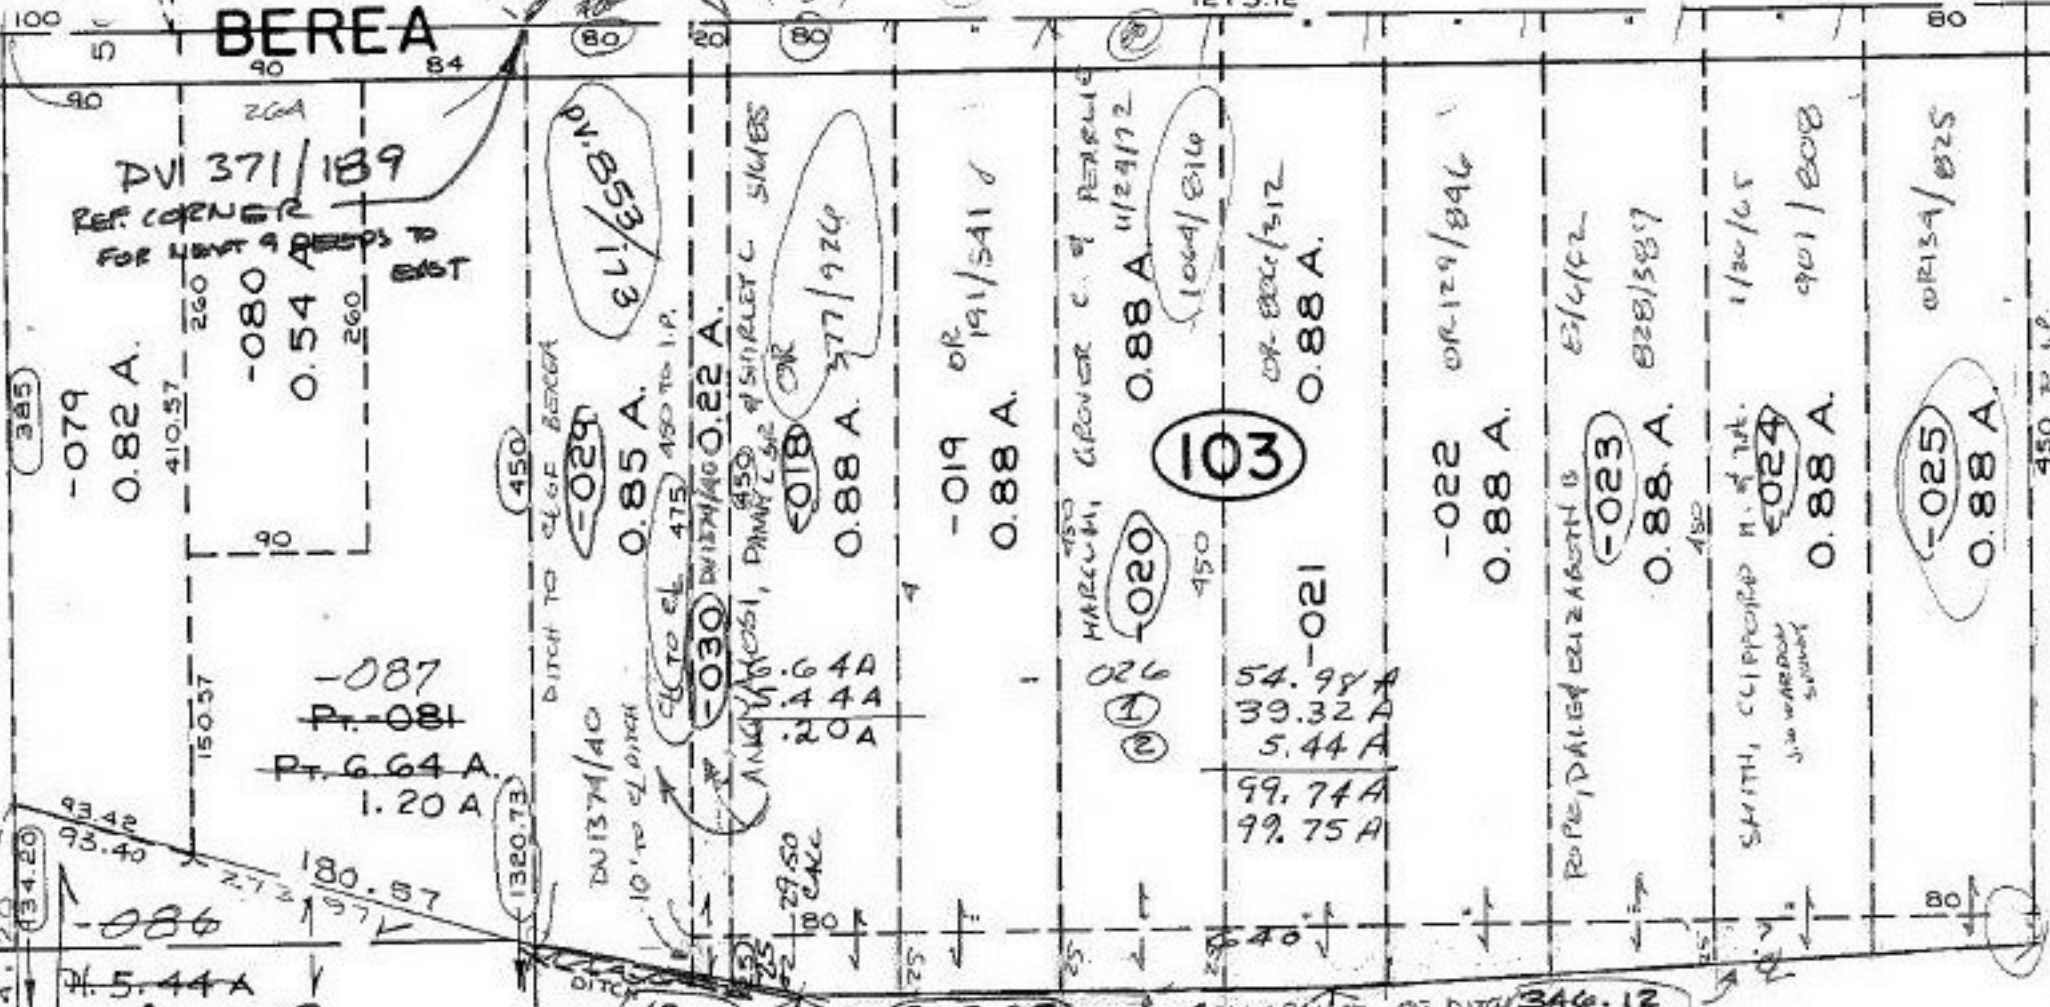

DVI 371/189
 REF. CORNER
 FOR NEXT 4 DEEDS TO
 EAST

-079
 0.82 A.

-080
 0.54 A.

-087
 P. 664 A.
 1.20 A.

~~P. 088~~
~~P. 99.74 A~~

99.75 A OLD TAX
 M. DOLL. SURVEY MAP PG.
 Mac Kay Eng.

CT BIGGS
 SURVEY
 DV 371/189

P.V. 853/1
 0.85 A.

0.85 A.

0.64 A
 0.44 A
 0.20 A

0.88 A.

-019 OR
 191/541 d
 0.88 A.

0.88 A 11/24/72

103

1004/816
 0.88 A.

0.88 A.

-022 OR 129/846
 0.88 A.

-023
 0.88 A.

0.88 A.
 901/808

0.88 A.
 01134/825

20695-0

#20695-0

~~APPROVED
 LORAIN CO.
 MAP DEPT.
 DATE 1-20-94
 PAGE 7-00-011-B
 BY CAROLYN FRANCIS
 VOID AFTER # 20695-0~~

5/26/94 07-00-011-103-
 PARCELS -018 thru 025 ALL EXTEND
 TO THE CENTERLINE OF DITCH ON
 THE SOUTH LINE PER THE DEEDS
 REFERENCED AS NOTED ABOVE

MAP
 CORRECTION

APPROVED
 LORAIN CO.
 MAP DEPT.
 DATE 1-24-94
 PAGE 7-00-011-B
 BY T. McMain
 VOID AFTER 20695-0