
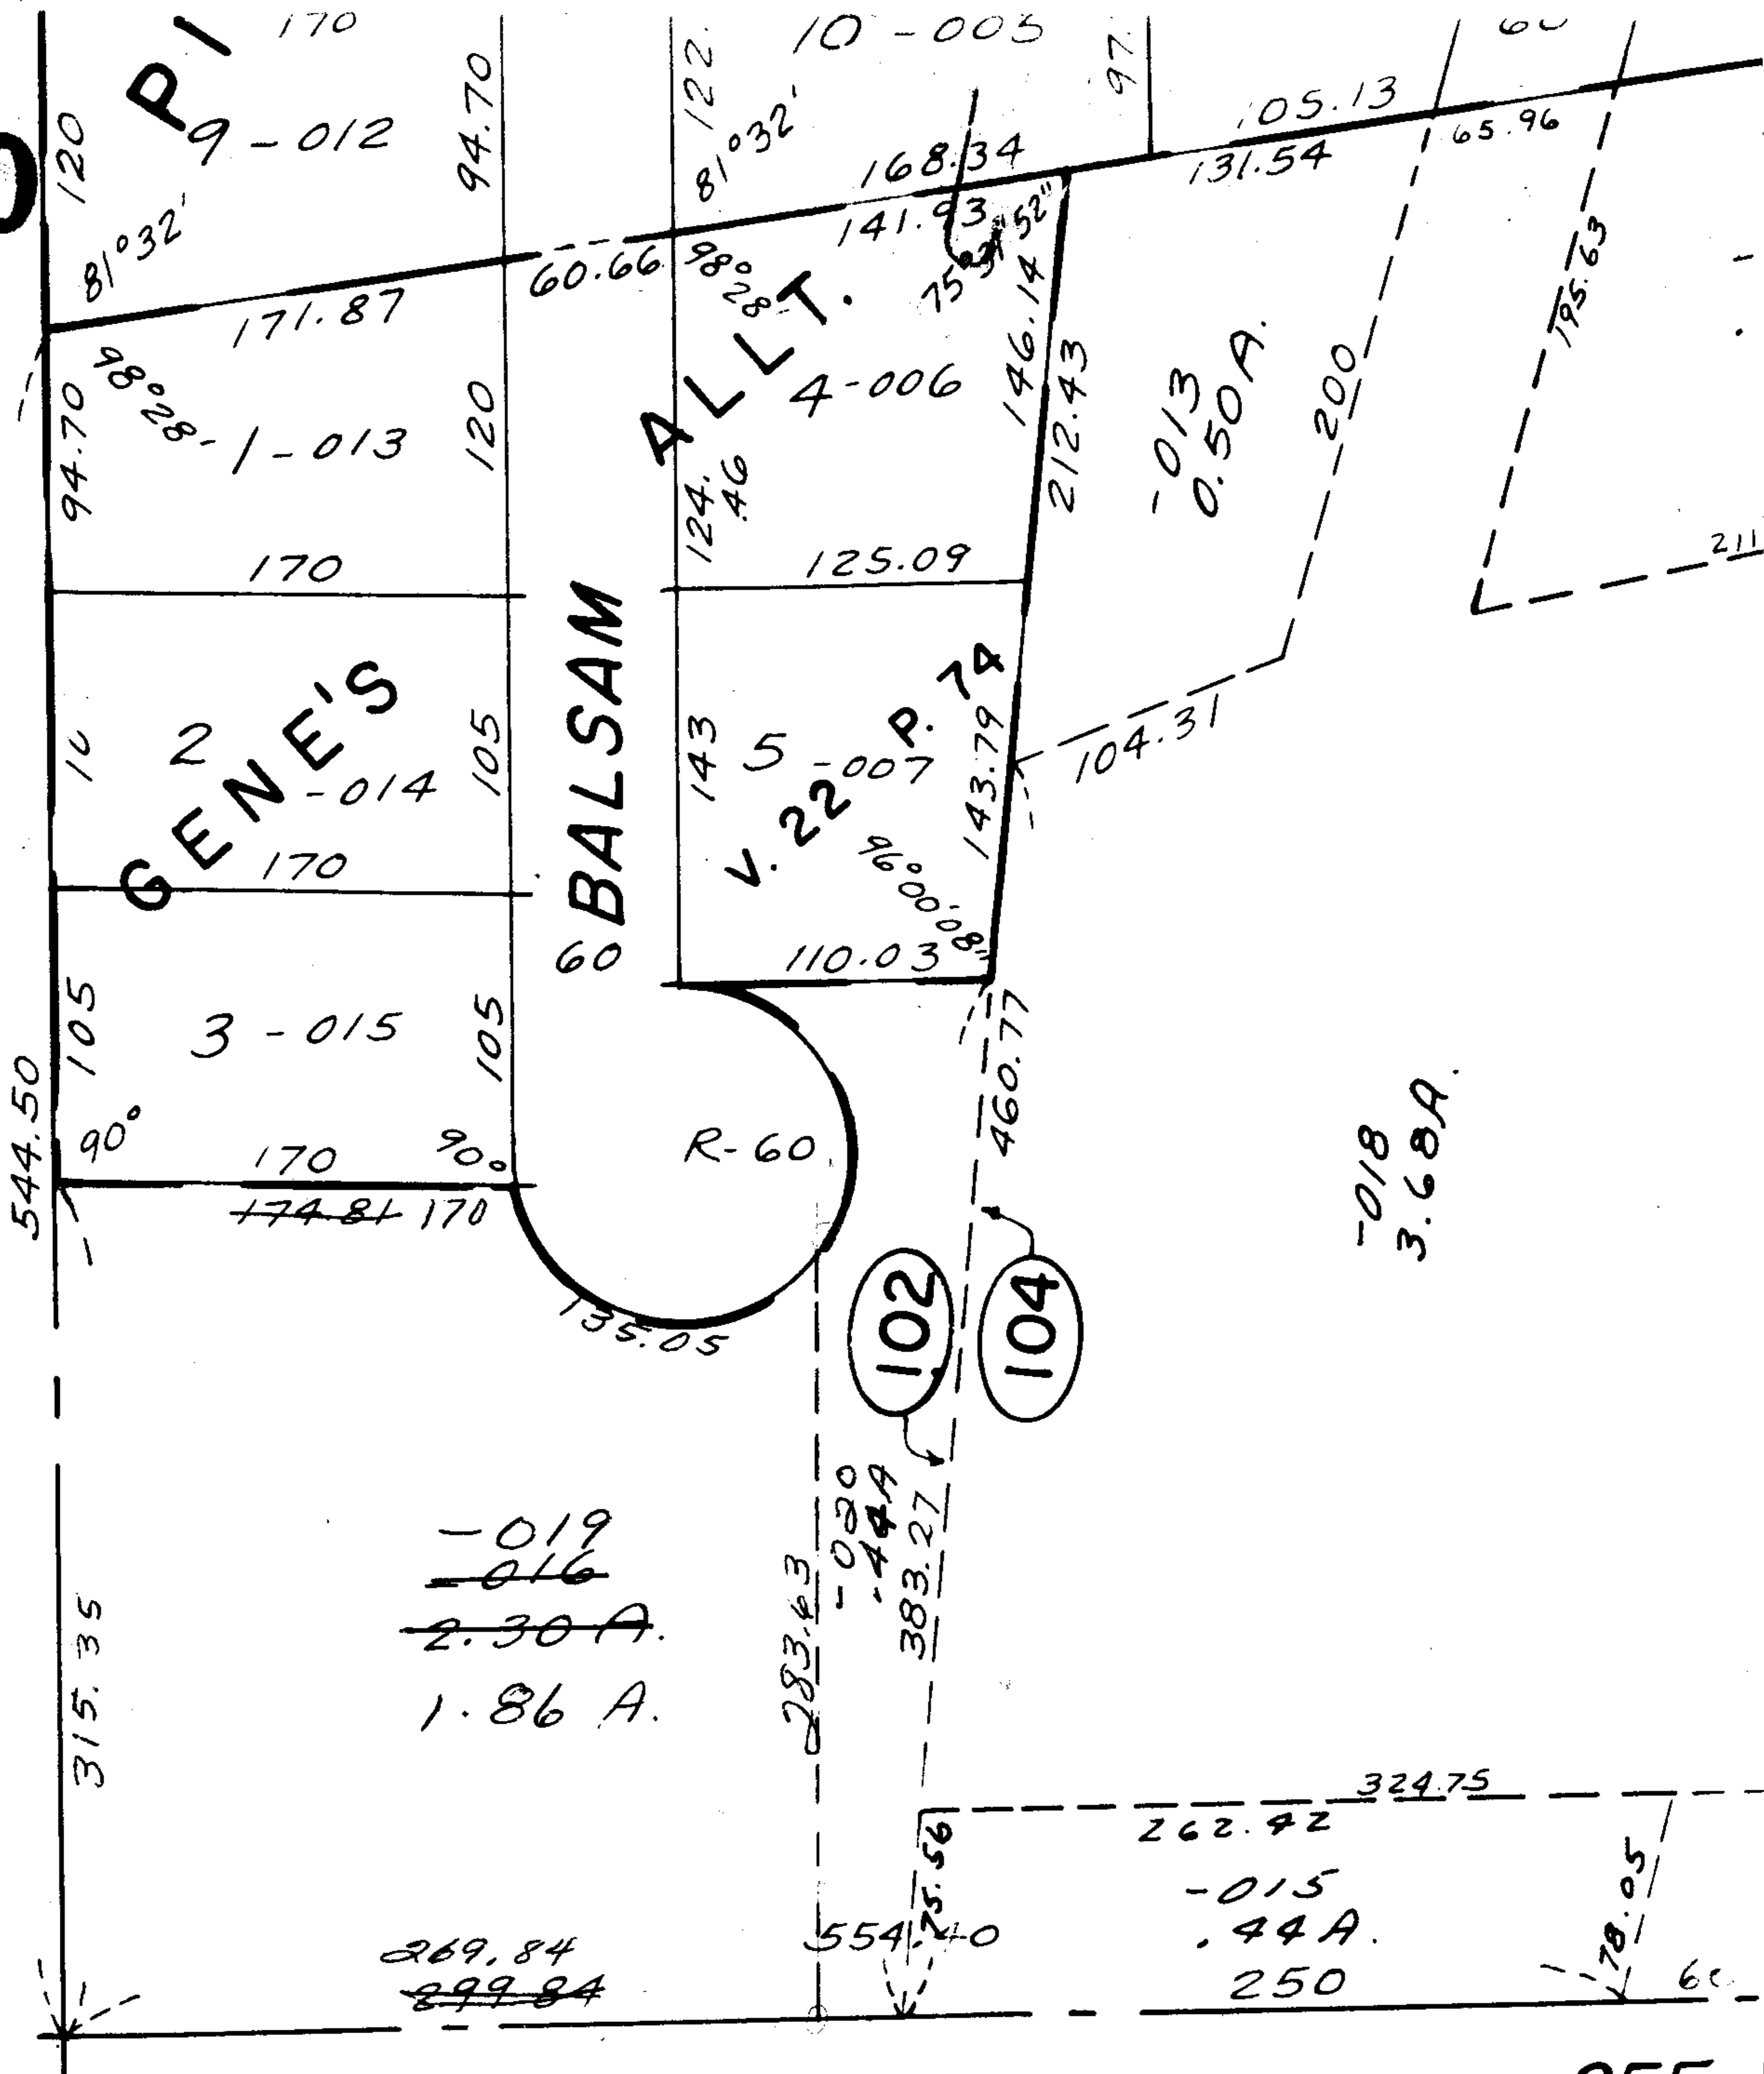


2070

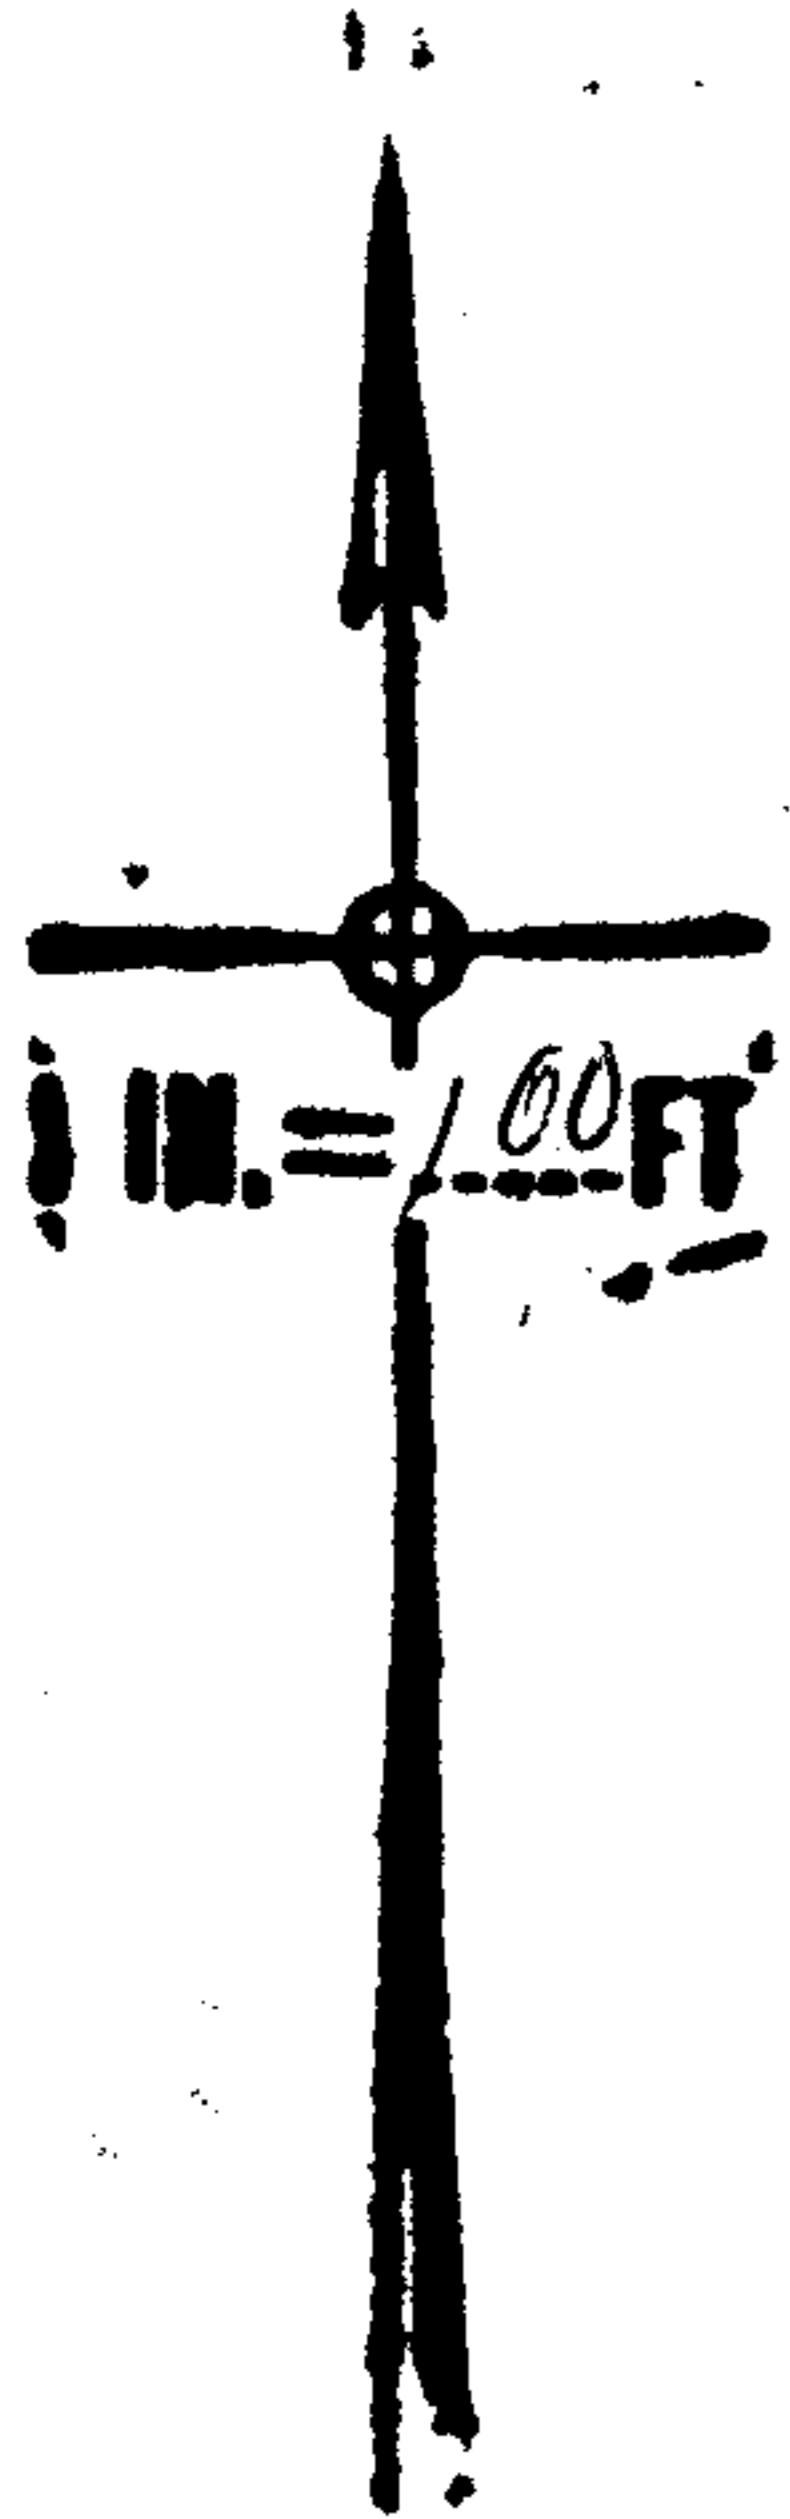

APPROVED
 LORAIN CO.
 MAP DEPT.
 DATE 9-5-68
 5-00-059A
 BY *J. Grace*

J. Grace
 Done 11-2-68

AMHERST TWP.

SCALE: 1" = 100'

SEE
 T-14-86 D.B.