

150.44 1.22 673.84 1306.05 D. 96.40.5 23.72 60.00 74.23 225.52

THIS DIMENSION BY DEED & SURVEY MAP.
THE MEADOWS SUB
Vol 50 PGS. 13 + 14

R=110.00 CH 23.67
CURVE R=140 CH=73.95
37.52 R=50.00 CH 36.65

~~-511~~
~~-509~~


19.22 A
① 0.10 A

19.12 A
② 0.36 A

18.76 A SUBTRACTED
ACREAGE

~~19.22 A~~ ~~20.00 A.~~

~~18.76 A.~~
18.91 A Ac. CORR. PER
SURVEY
Don. WOIKE Reg. Surveyor

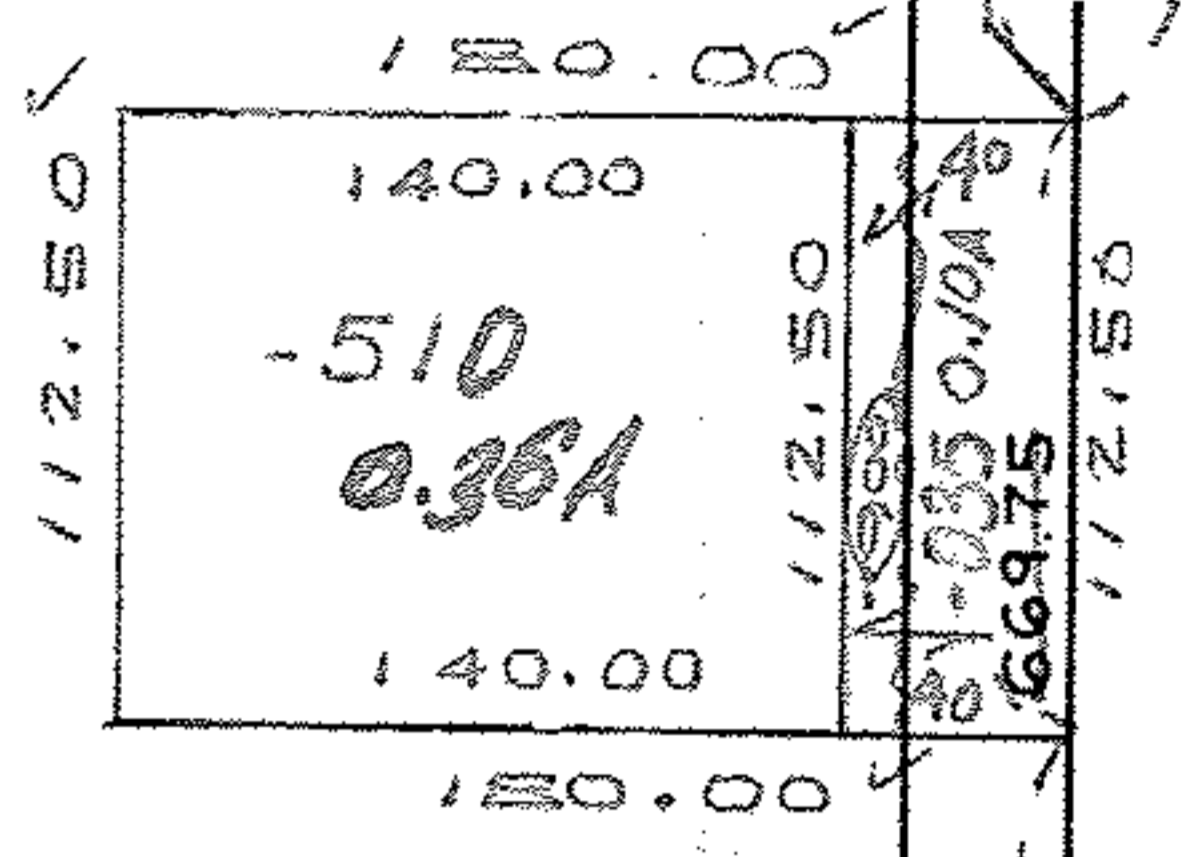

①
4,500 Sq Ft.
= 0.10 A
②
15,750 Sq Ft.
= 0.36 A.

6/22/94
20705
APPROVED
LORAIN CO.
MAP DEPT.
DATE 1-26-94
PAGE 4-00-020 H
CAROLYN
BY FRANCIS
VOID # 20705

P.P. NO. 04-00-020-104- 04-00-020-900-
PRIOR INST: DV.1354/329
CLOSURE: 0.10 ac. C=1: INF. 0.36 ac. C=1: INF.
18.91 ac. C=1:322,900
SURVEYED BY: HENRY REITZ ENG. CO.
DONALD E. WOIKE REG. SURVEYOR

1307.00
~~1307.22 D.~~
1303.50 D.

66726
650.02

RD.
275.00
215.00
112.50
112.50
112.50
112.50
LENG NAKIE RD