




COMBINATION

DV. 1212 / 416

~~11-00-006-000-024, 031~~

CLOSURE: G=LINE

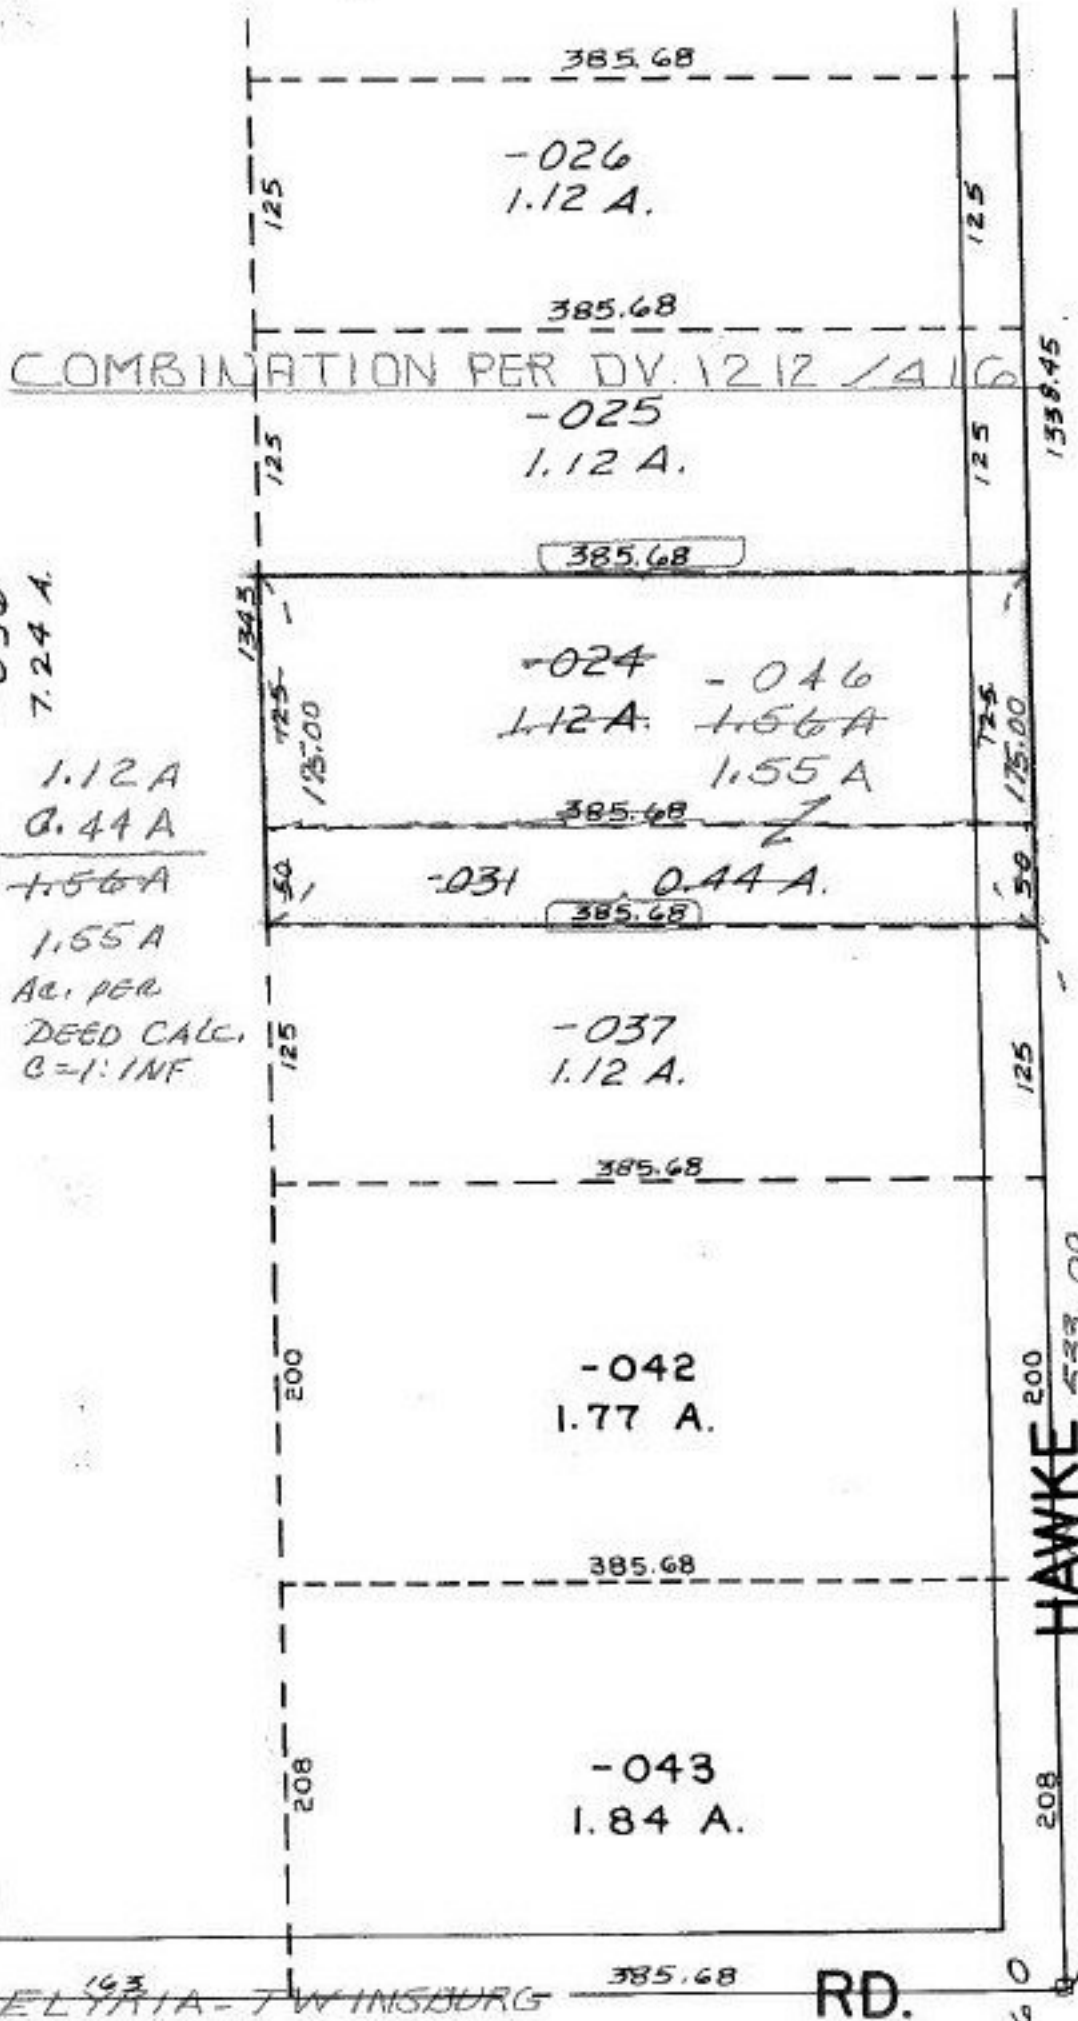

-036
7.24 A.
1.12 A
0.44 A
1.56 A
1.55 A
AC. PER
DEED CALC.
C=1:1NF

AUG 5 1994
20708
APPROVED
LORAIN CO.
MAP DEPT.
DATE 1-26-94
PAGE 11-00-006 B
BY CAROLYN
BY FRANCIS
VOID
MASTER # 20708