

-00
45.0

189.
189.

-0
35.

1034.88

-001
39F.

1287

(502)-003
1.30F.

234.1
-004

(502)

-002
8.44F.

4.19A

574.3

90°

1/100


(502)

200

-001
7.70F.

-032
Pt. ~~051~~
Pt. ~~41.90~~
43.74A.

Pt. 029
Pt. 67.037.

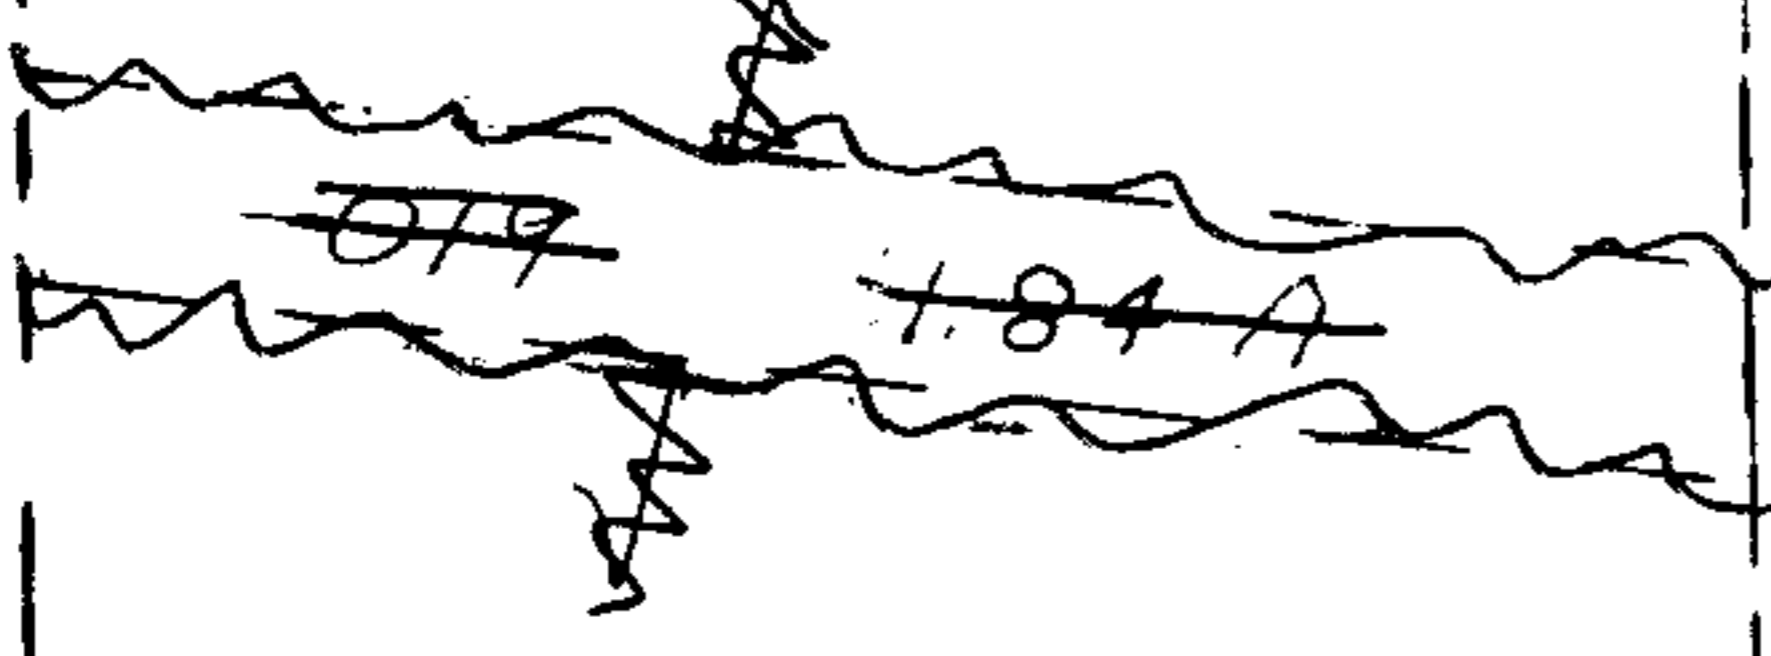

-020

2.65A

29



SEE
P.C.
8-25-68

2071

D-69-00-029-0

APPROVED
LORAIN CO.
MAP DEPT.
DATE 9-4-68
BY 18-B
BY <i>[Signature]</i>

P.H.

← 1873

A

88