


-001
54.00 A.

-002
27.75 A.

94

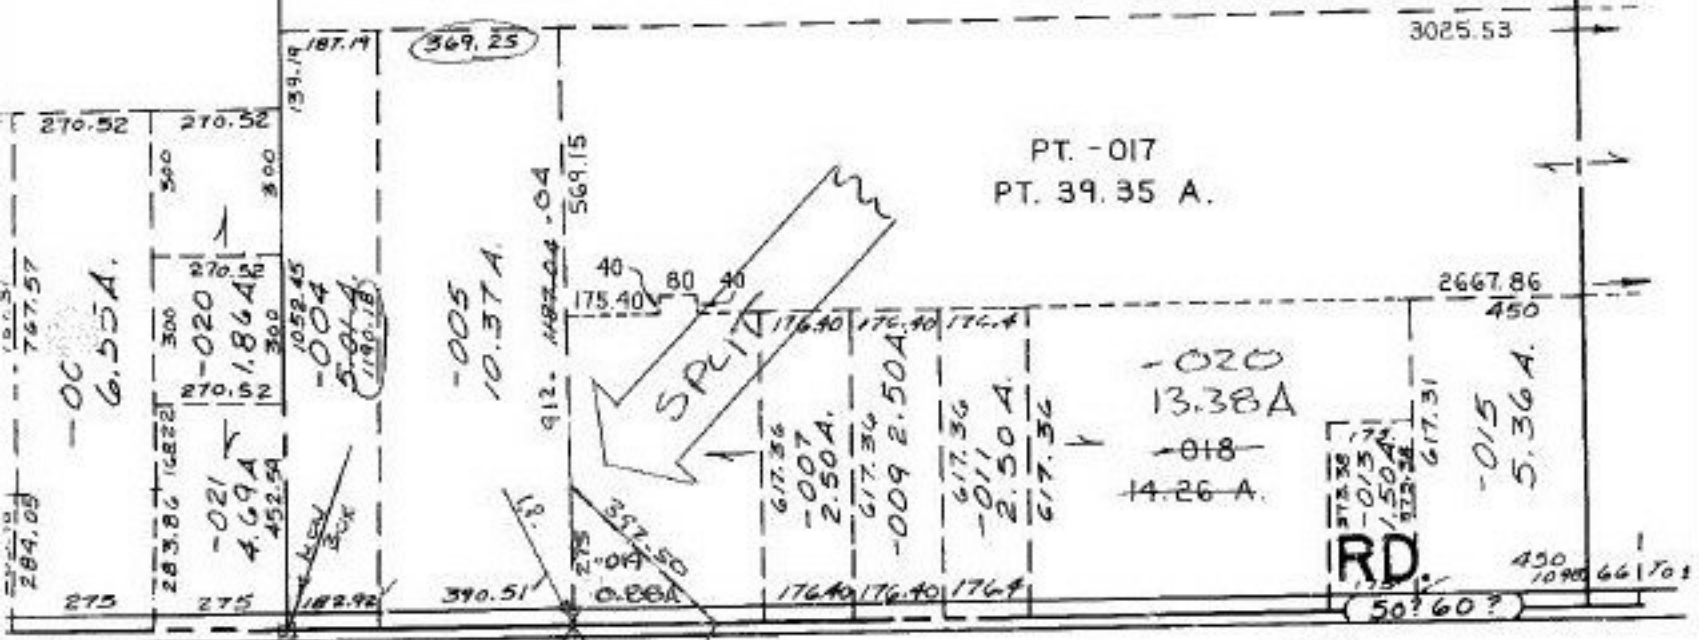


LAGRANGE TWP SPLIT COMBINATION

SCALE 1" = 400'

AUG 2 1994

#20711

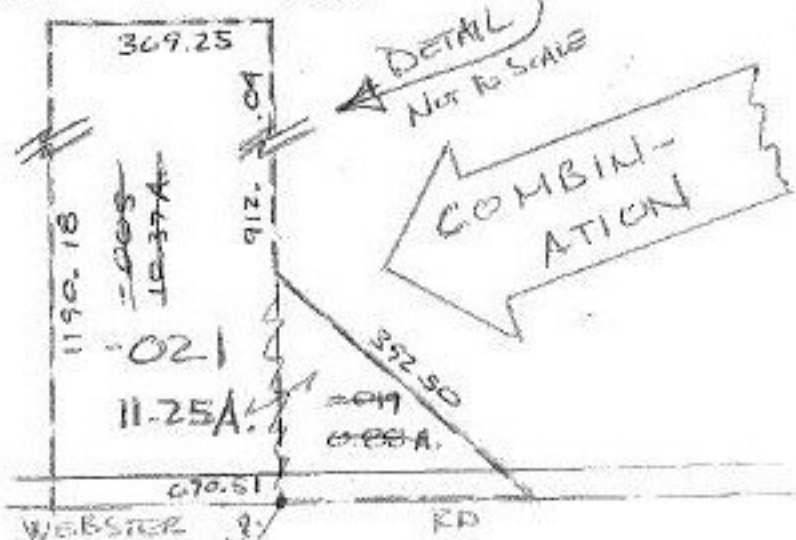

| | |
|-------------------------------------|-------|
| APPROVED LORAIN CO. MAP DEPT. | |
| DATE 1-26-94 | |
| PAGE 15-6 | |
| BY T. McVain | |
| VOID AFTER | 20711 |