


SEE 9-00-087-B

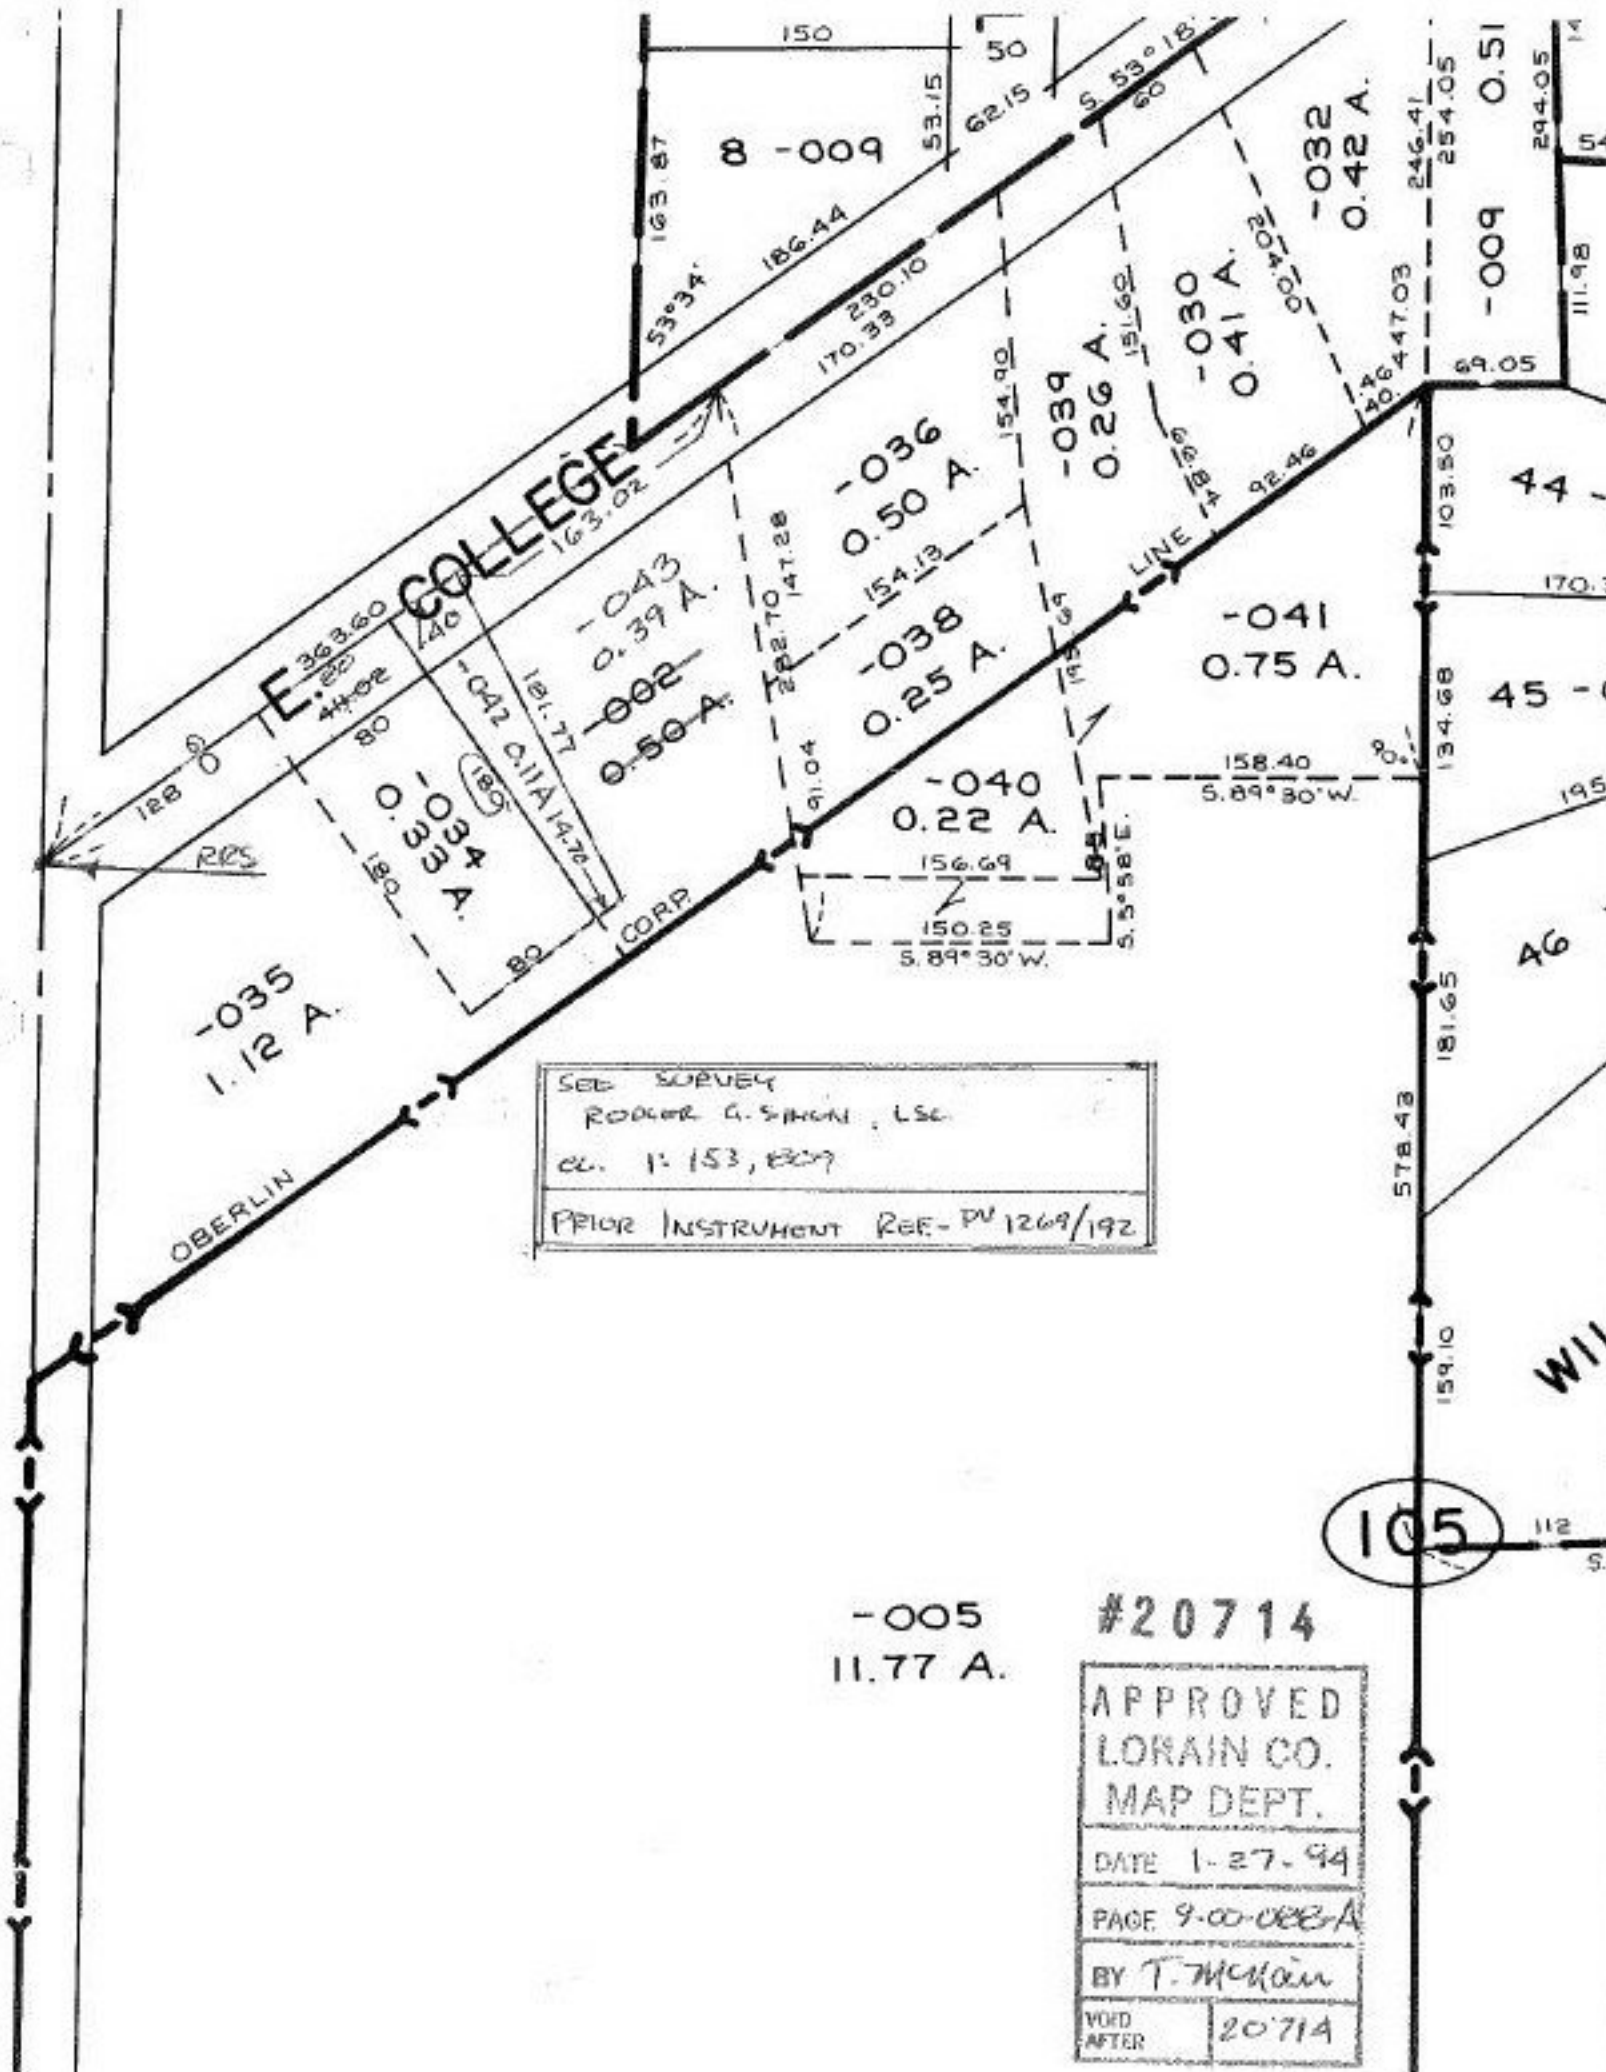

SEE SURVEY  
 RODGER G. SIMON, L.S.C.  
 C.C. 1: 153, 809  
 PRIOR INSTRUMENT REF- PV 1269/192

-005  
 11.77 A.

#20714

APPROVED  
 LORAIN CO.  
 MAP DEPT.  
 DATE 1-27-94  
 PAGE 9-00-088-A  
 BY T. McMan  
 VOID AFTER 20714

105

W11