


Pt. 11-00-006-500-001  
Pt. 49.91 A.

R.R.

514 R/W LINE of CONRAIL RR

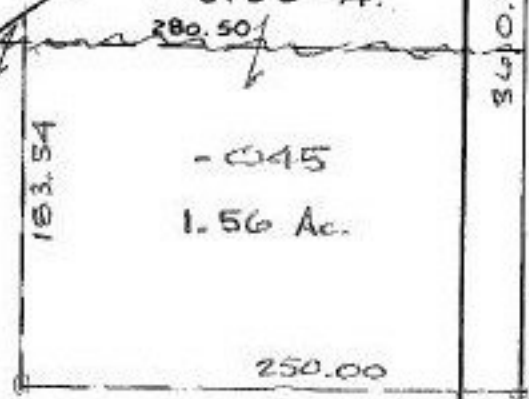

SEE SURVEY BY  
MCCARTNEY & ASSOC. 986  
JOHN R. HAMILTON, P.S. 6861  
CL. 1: 171, 283  
PROR INST.  
REFERENCE - DV 186/369

SEE 11-G SOUTH

Pt. ~~004~~ Pt. ~~046~~  
Pt. ~~15.17 A.~~ Pt. ~~14.11 A.~~

788.70

*SH*

NIG 5 1994

#20716



APPROVED  
LORAIN CO.  
MAP DEPT.  
DATE 1-27-94  
PAGE 11-00-058-B  
BY T. McMan  
VOID AFTER 20716

11-00-058-B