


SEE 5

PT. 1.0

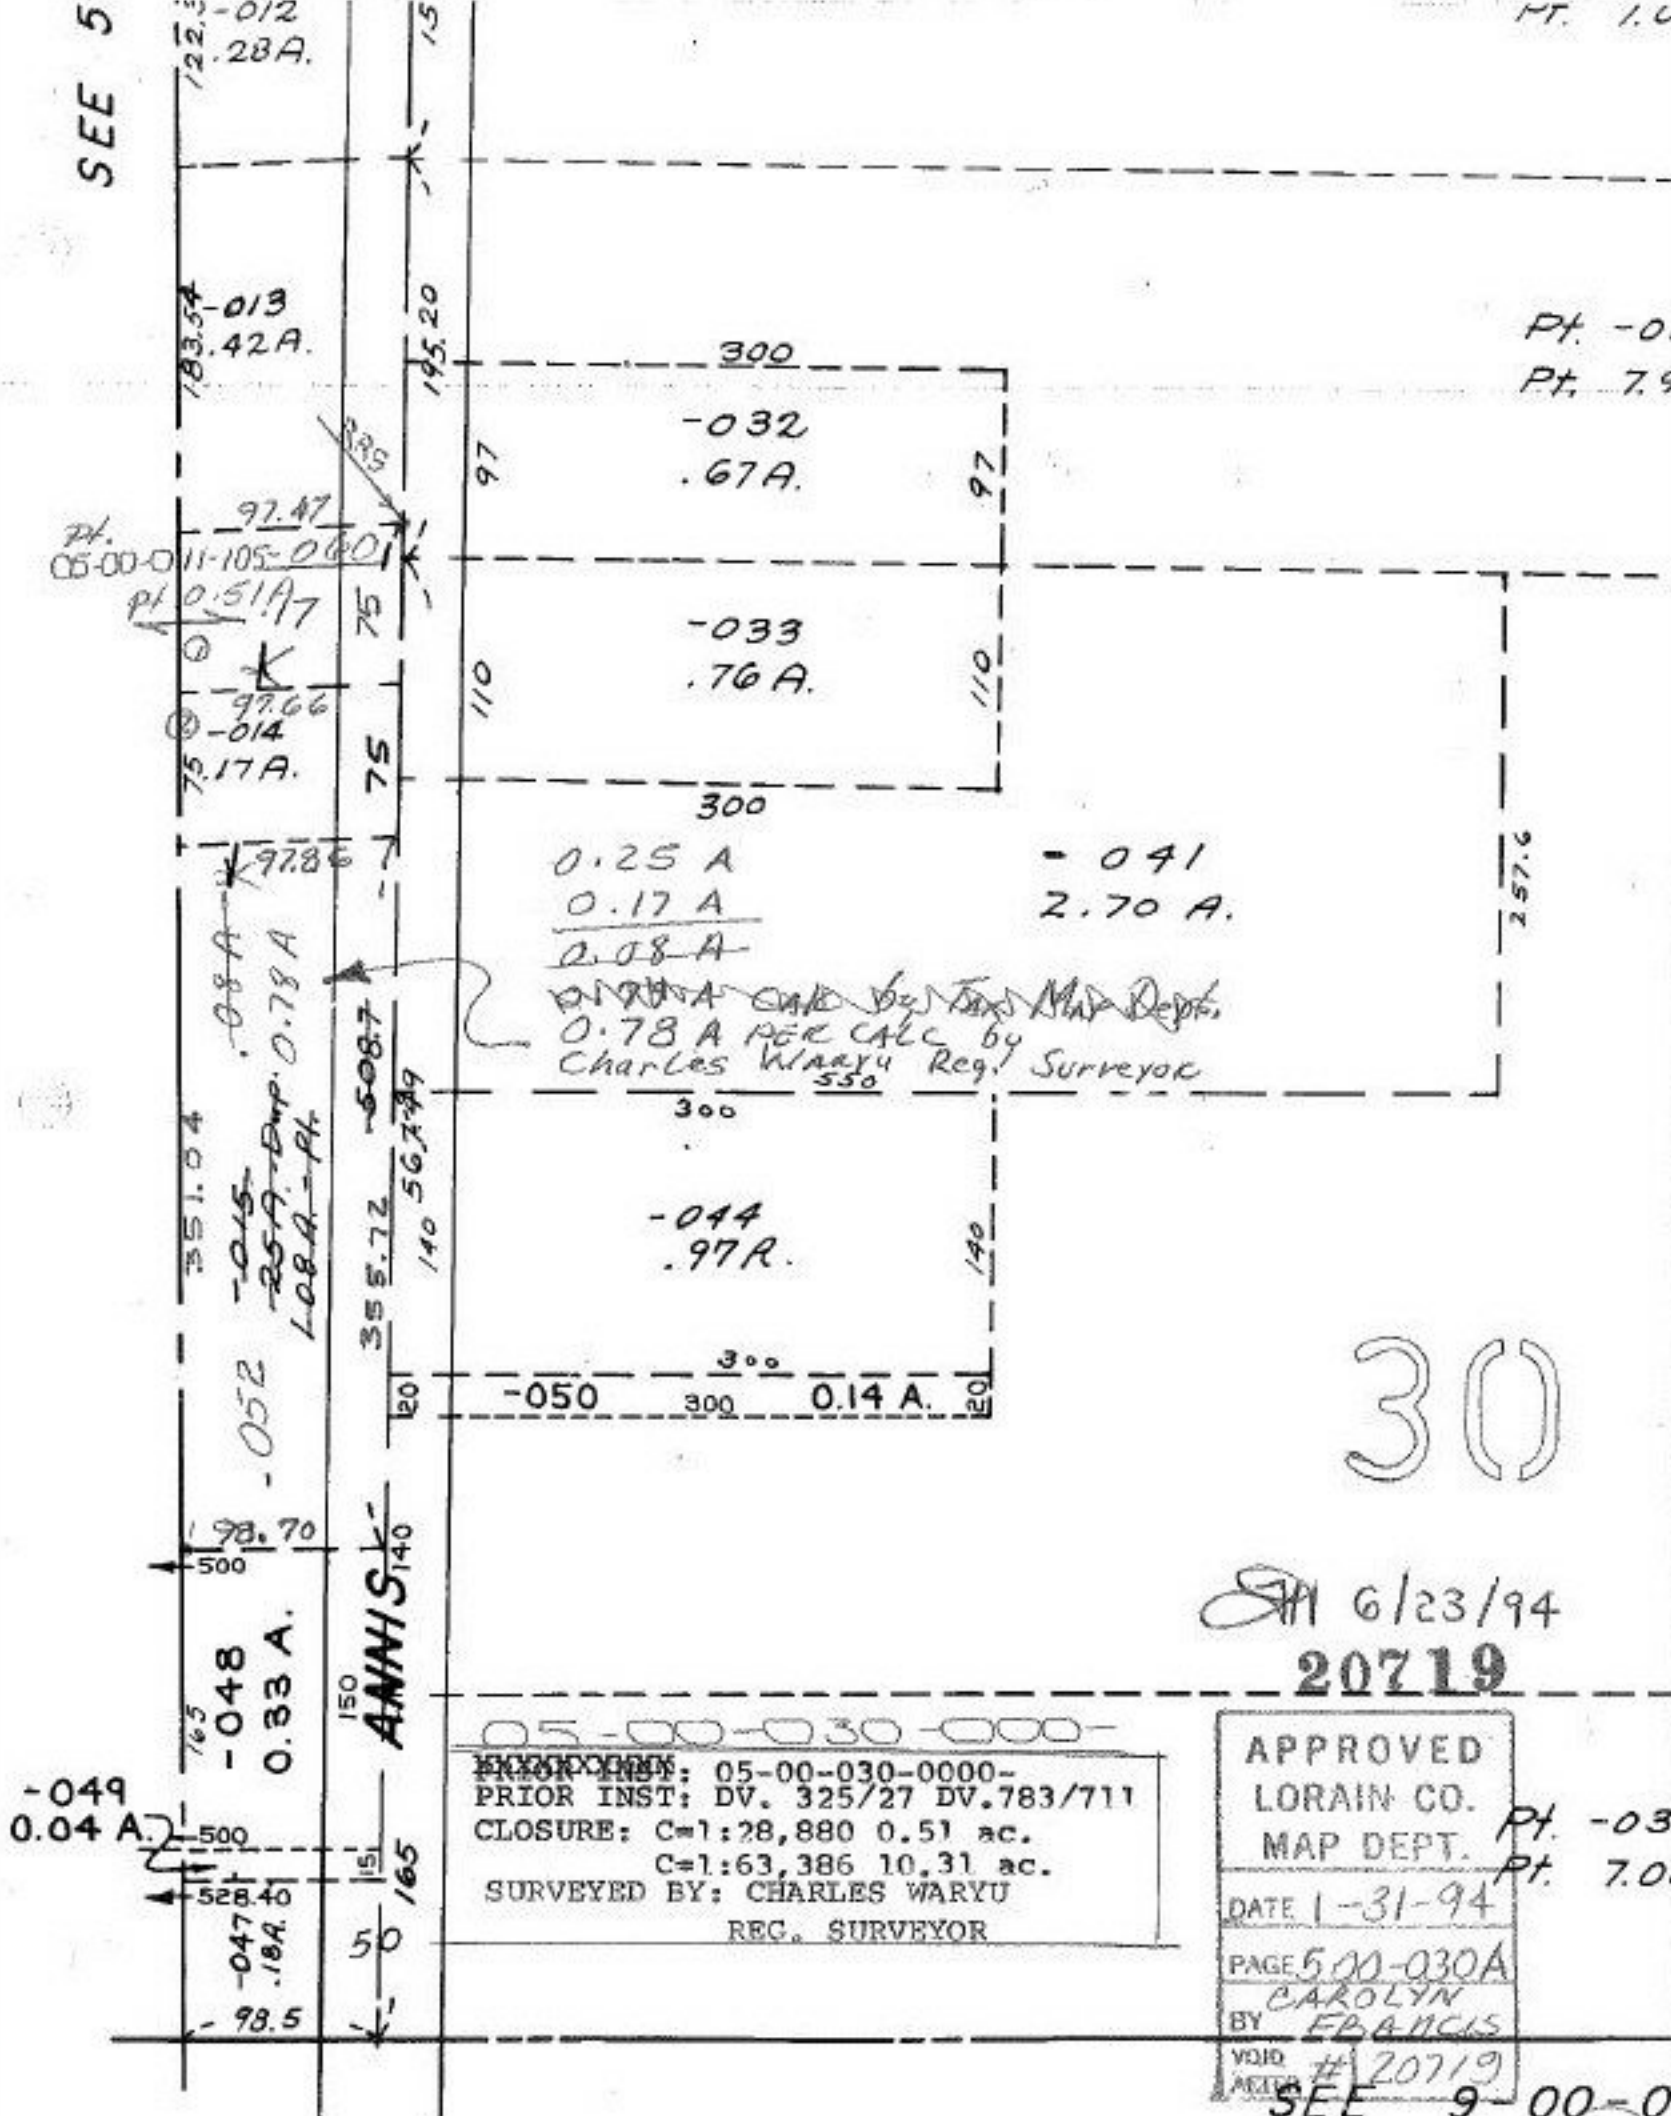

PL. 05-00-011-105-000
 PL. 0.51 A

0.25 A
 0.17 A
 0.08 A
 0.78 A
 TOTAL 2.70 A
 CORRECTED BY TAX MAP DEPT.
 0.78 A PER CALL BY
 CHARLES WARYU REG. SURVEYOR

30

6/23/94
 20719

05-00-030-000-
 PRIOR INST: 05-00-030-0000-
 PRIOR INST: DV. 325/27 DV. 783/711
 CLOSURE: C=1:28,880 0.51 ac.
 C=1:63,386 10.31 ac.
 SURVEYED BY: CHARLES WARYU
 REG. SURVEYOR

APPROVED
 LORAIN CO.
 MAP DEPT.
 DATE 1-31-94
 PAGE 500-030A
 BY CAROLYN
 FRANCIS
 VOID AFTER # 20719

PT. -03
 PT. 7.00

SEE 9 00-0

2/2