


ROTH LOUIS  
CHARLES

527.61

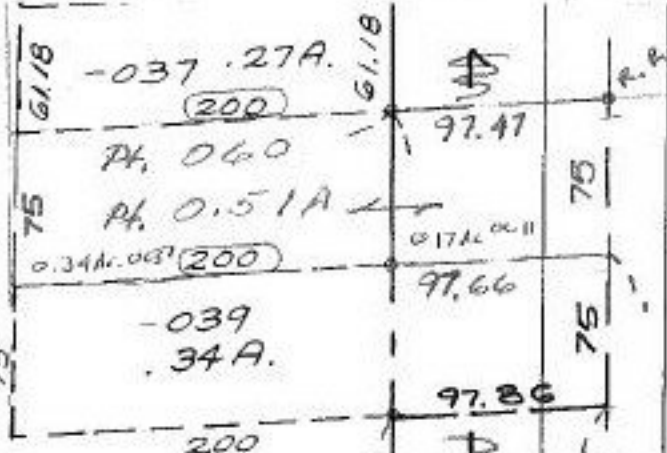

Ac. 0.51Ac.

O.L. 11 0.34A

O.L. 30 0.17A

0.51A

9.86A  
0.34A O.L. 11  
9.52A



015  
.25A  
.17A  
0.08A

- 0.61  
- 0.38  
9.86A  
9.52A

~~10.04A~~ per survey by  
9.53A Charles Waryu  
Reg. Surveyor

500.7  
05-00-020-000-052

929.93

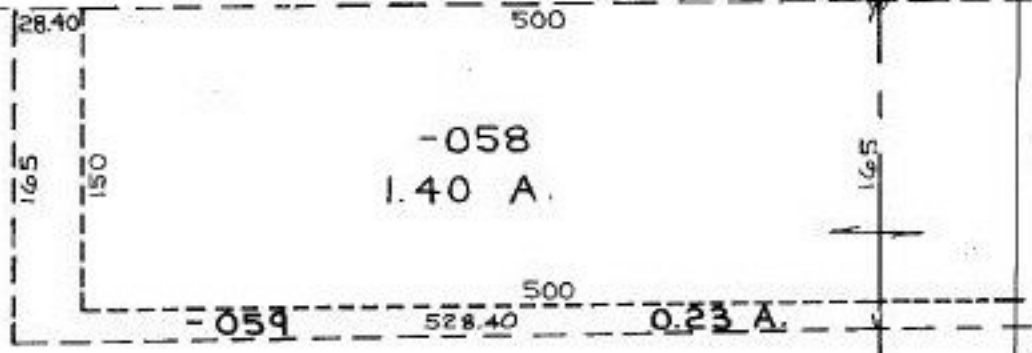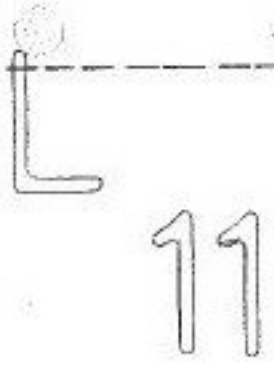

ANNIS  
150  
241.41  
76.41  
15

05-00-011-105-

1-004-A

SA 6/23/94  
20719

P.P.NO. 05-00-011-105-  
 PRIOR INST: DV.325/27 DV.783/711  
 CLOSURE: C=1:28,880 0.51 ac.  
 C=1:63,386 10.31 ac.  
 SURVEYED BY: CHARLES WARYU  
 REG. SURVEYOR

APPROVED  
 LORAIN CO.  
 MAP DEPT.  
 DATE 1-31-94  
 PAGE 5-00-011-B  
 BY CAROLYN  
 FRANCIS  
 VOID # 20719

SEE 5-00-030-A

1/2