


APPROVED  
 LORAIN CO.  
 MAP DEPT.  
 DATE 9-16-68  
 7-00-011A+B

2072  
 2073

#1+B = 42,900 A.  
 11,963 A.  
 155 A.  
 55,350  
 5,400  
 49,200 A.  
 109,950  
 2,52 A.  
 65,280  
 18,363  
 12,390  
 672  
 94,705 A.  
 2,17 A.

SEE 7-00-011-B

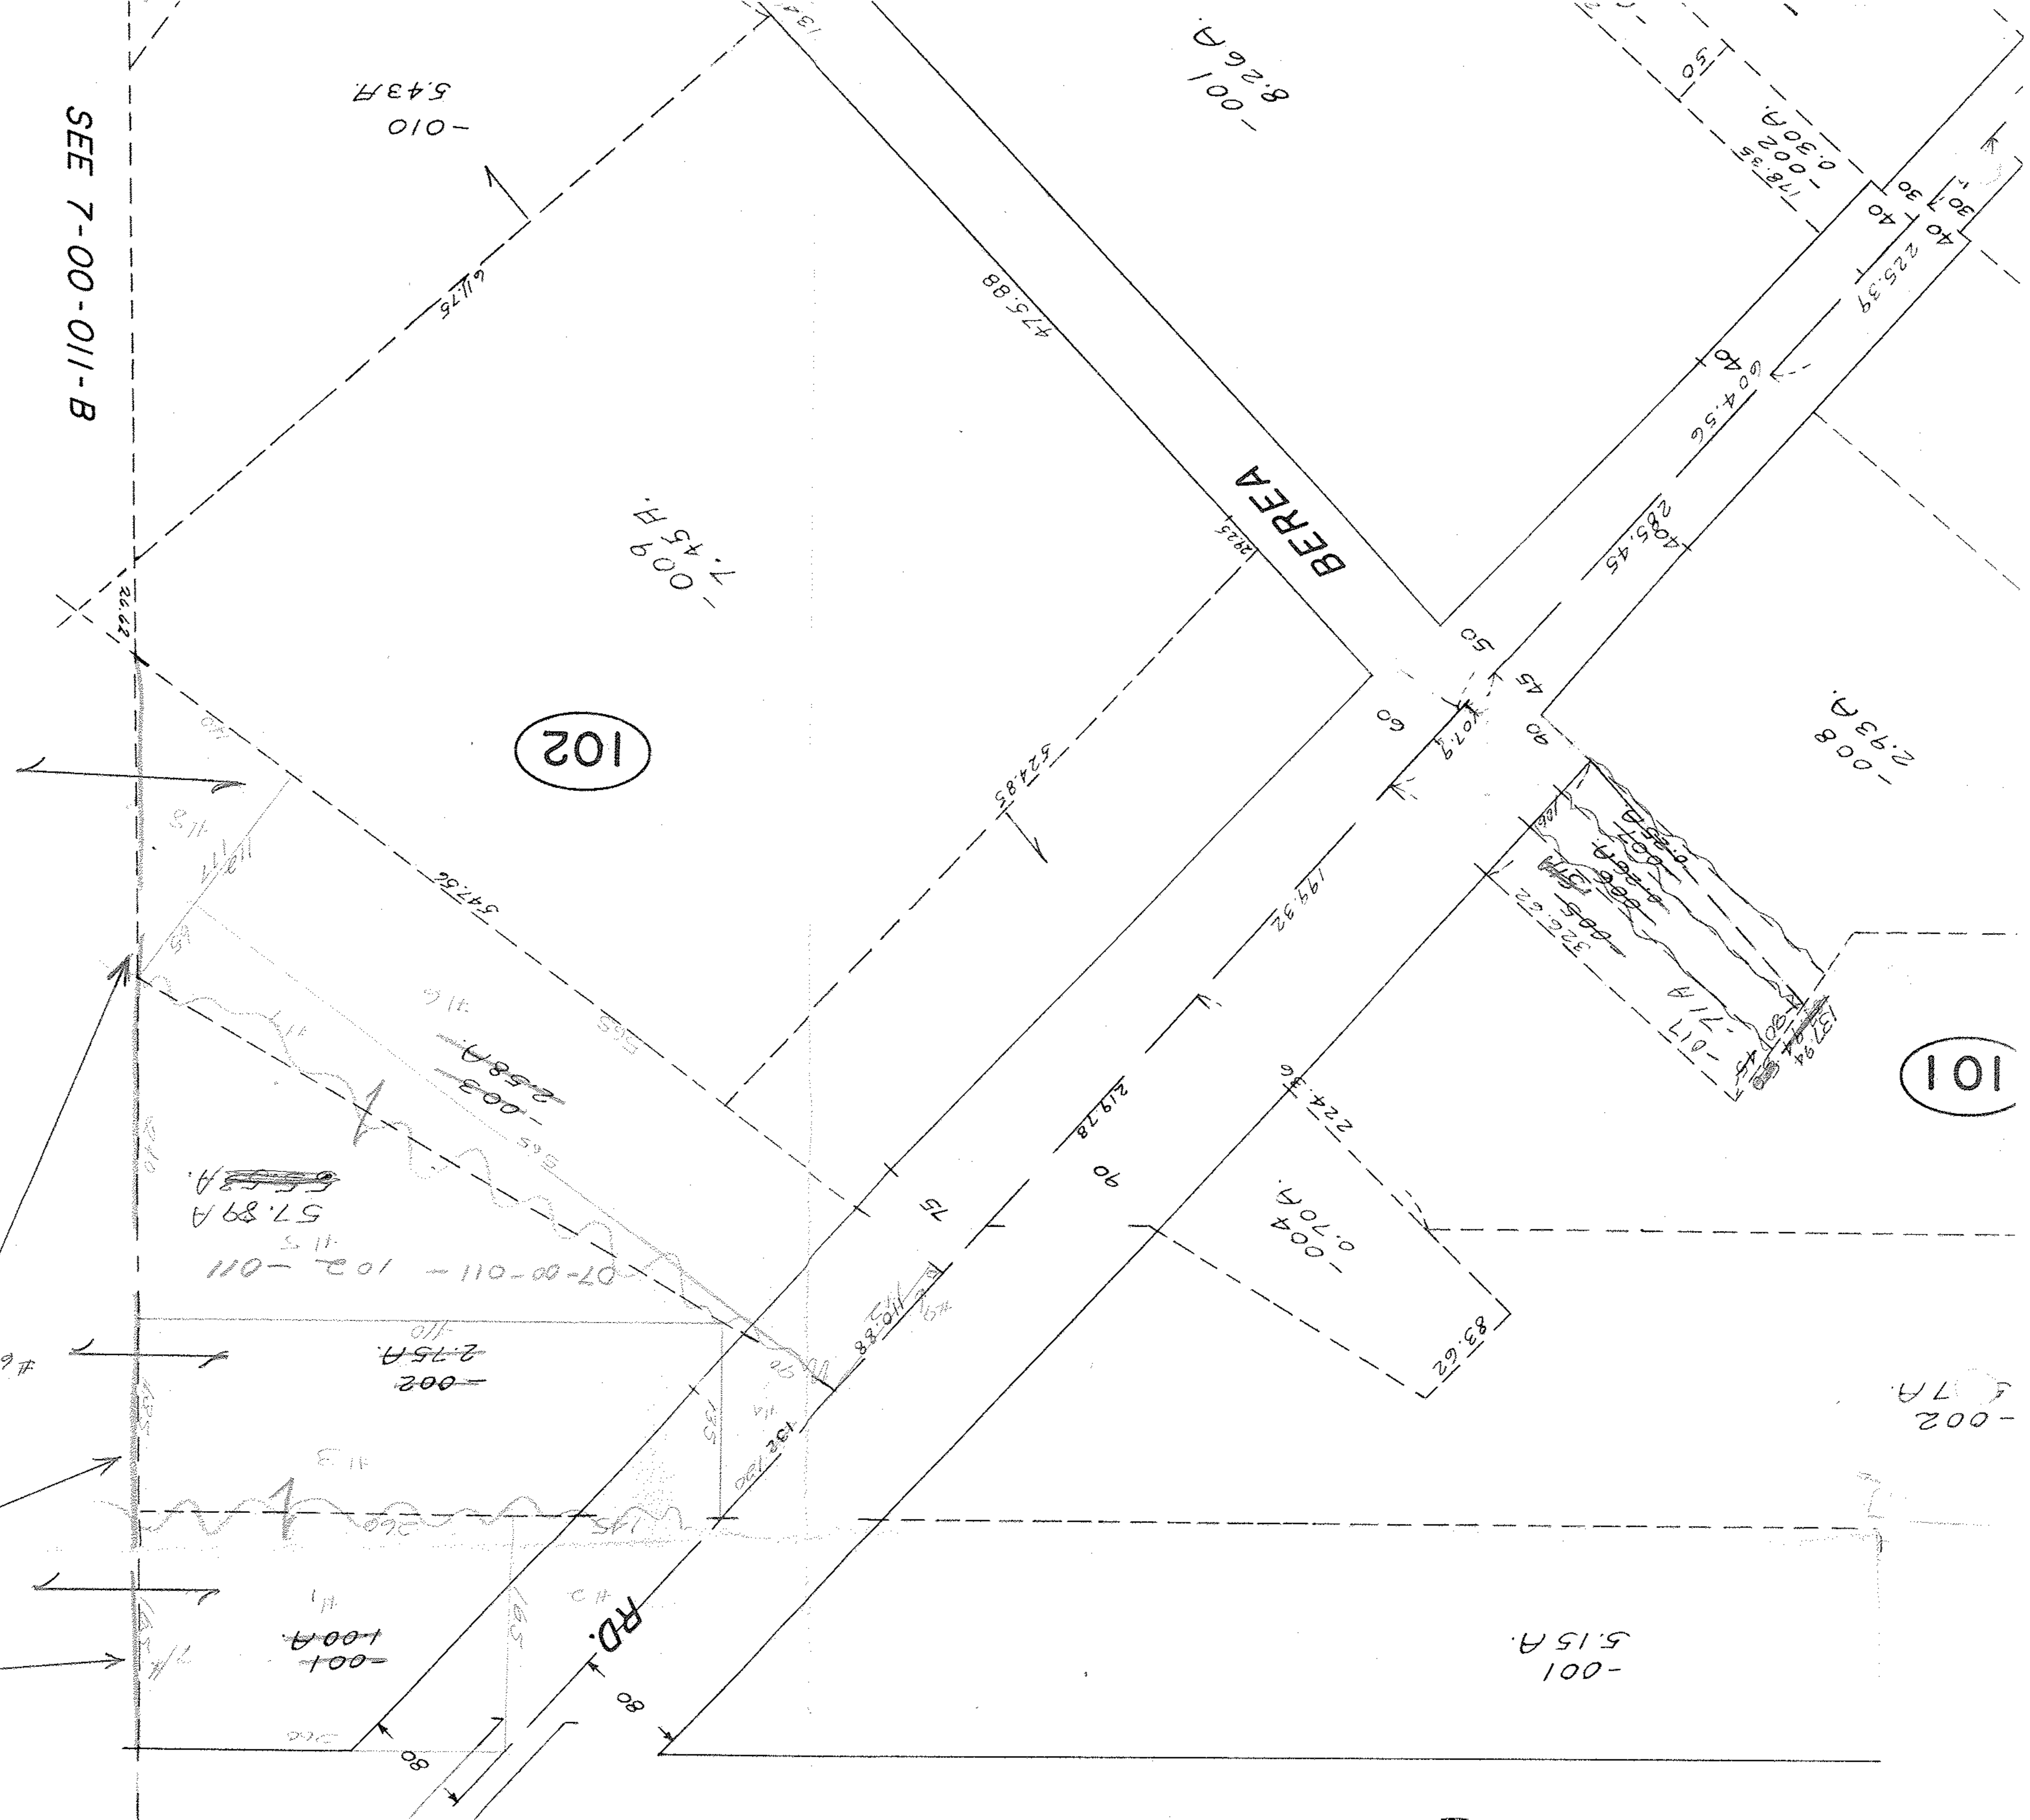

102

101

RD.

BEREA

-001  
 5.15 A.

-004  
 0.70 A.

-001  
 1.00 A.

57.89 A.

-002  
 2.75 A.

-003  
 2.55 A.

-009  
 1.45 A.

-010  
 5.43 A.

-001  
 8.26 A.

-002  
 0.30 A.

-008  
 2.93 A.

-002  
 5.7 A.

24.62

11.8

11.8

11.6

11.3

2.60

1.65

1.10

5.65

5.4756

6.1175

5.55

5.2485

5.2485

