

SL. 15 -006 120.45 SL. 13 -008 120.14
 ① 96.00 ③ 70.00
 30.45 30.14

SL. 14 120.29
 -007 ② 90.00
 30.29

79.10
 48.88
 48.88
 144.40

CORRECT THIS
 WHEN PUTTING
 ON MAP
 125' PER PLAT

6/2

LAKE



DR. 60

LAKE WOOD BEACH

DR.

AVE.

AVE.

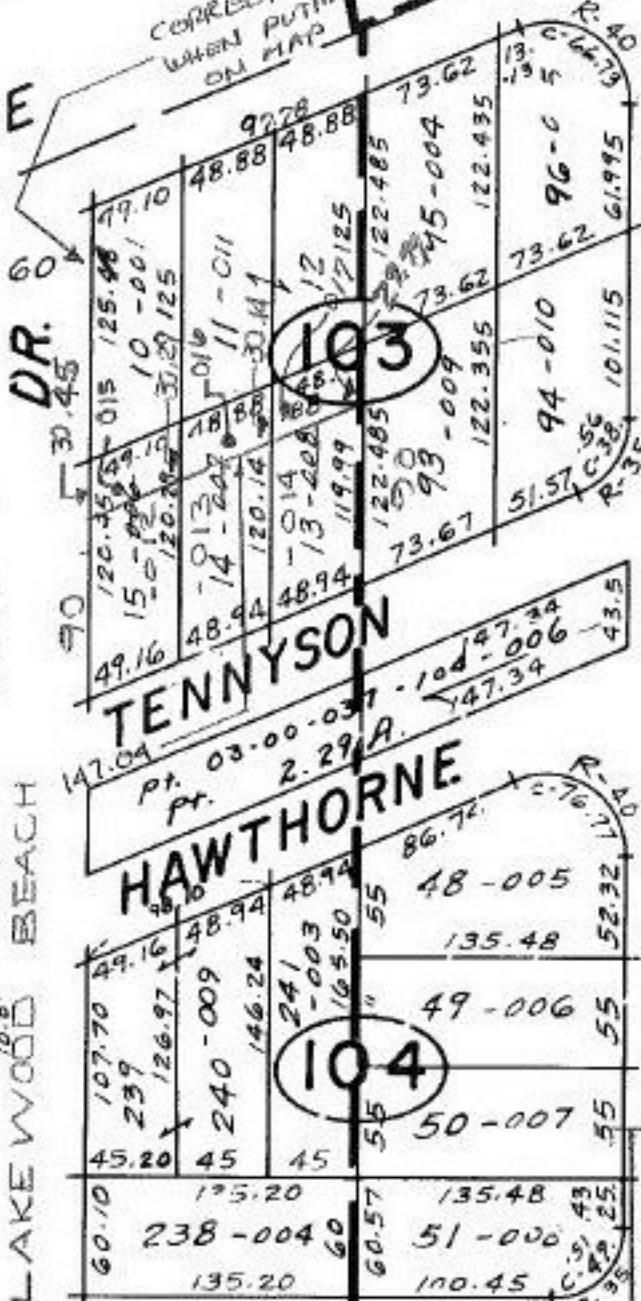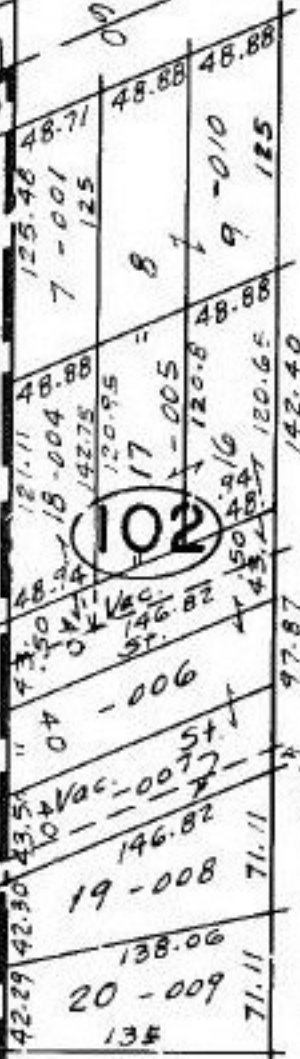

P.P. NO. 03-00-043-103-
 PRIOR INST: O.R.616/369
 SURVEYED BY: LAUNDON,
 SIMON, CAHL & ASSOC.
 CLOSURE: C=1: INF.

5/16/94
 20721

APPROVED
 LORAIN CO.
 MAP DEPT.
 DATE 2-4-94
 PAGE 3-00-043
 BY CAROLYN
 FRANCIS
 WORD NUMBER # 20721

FERNDALE

