


2923-82

2649.73

OBERLIN

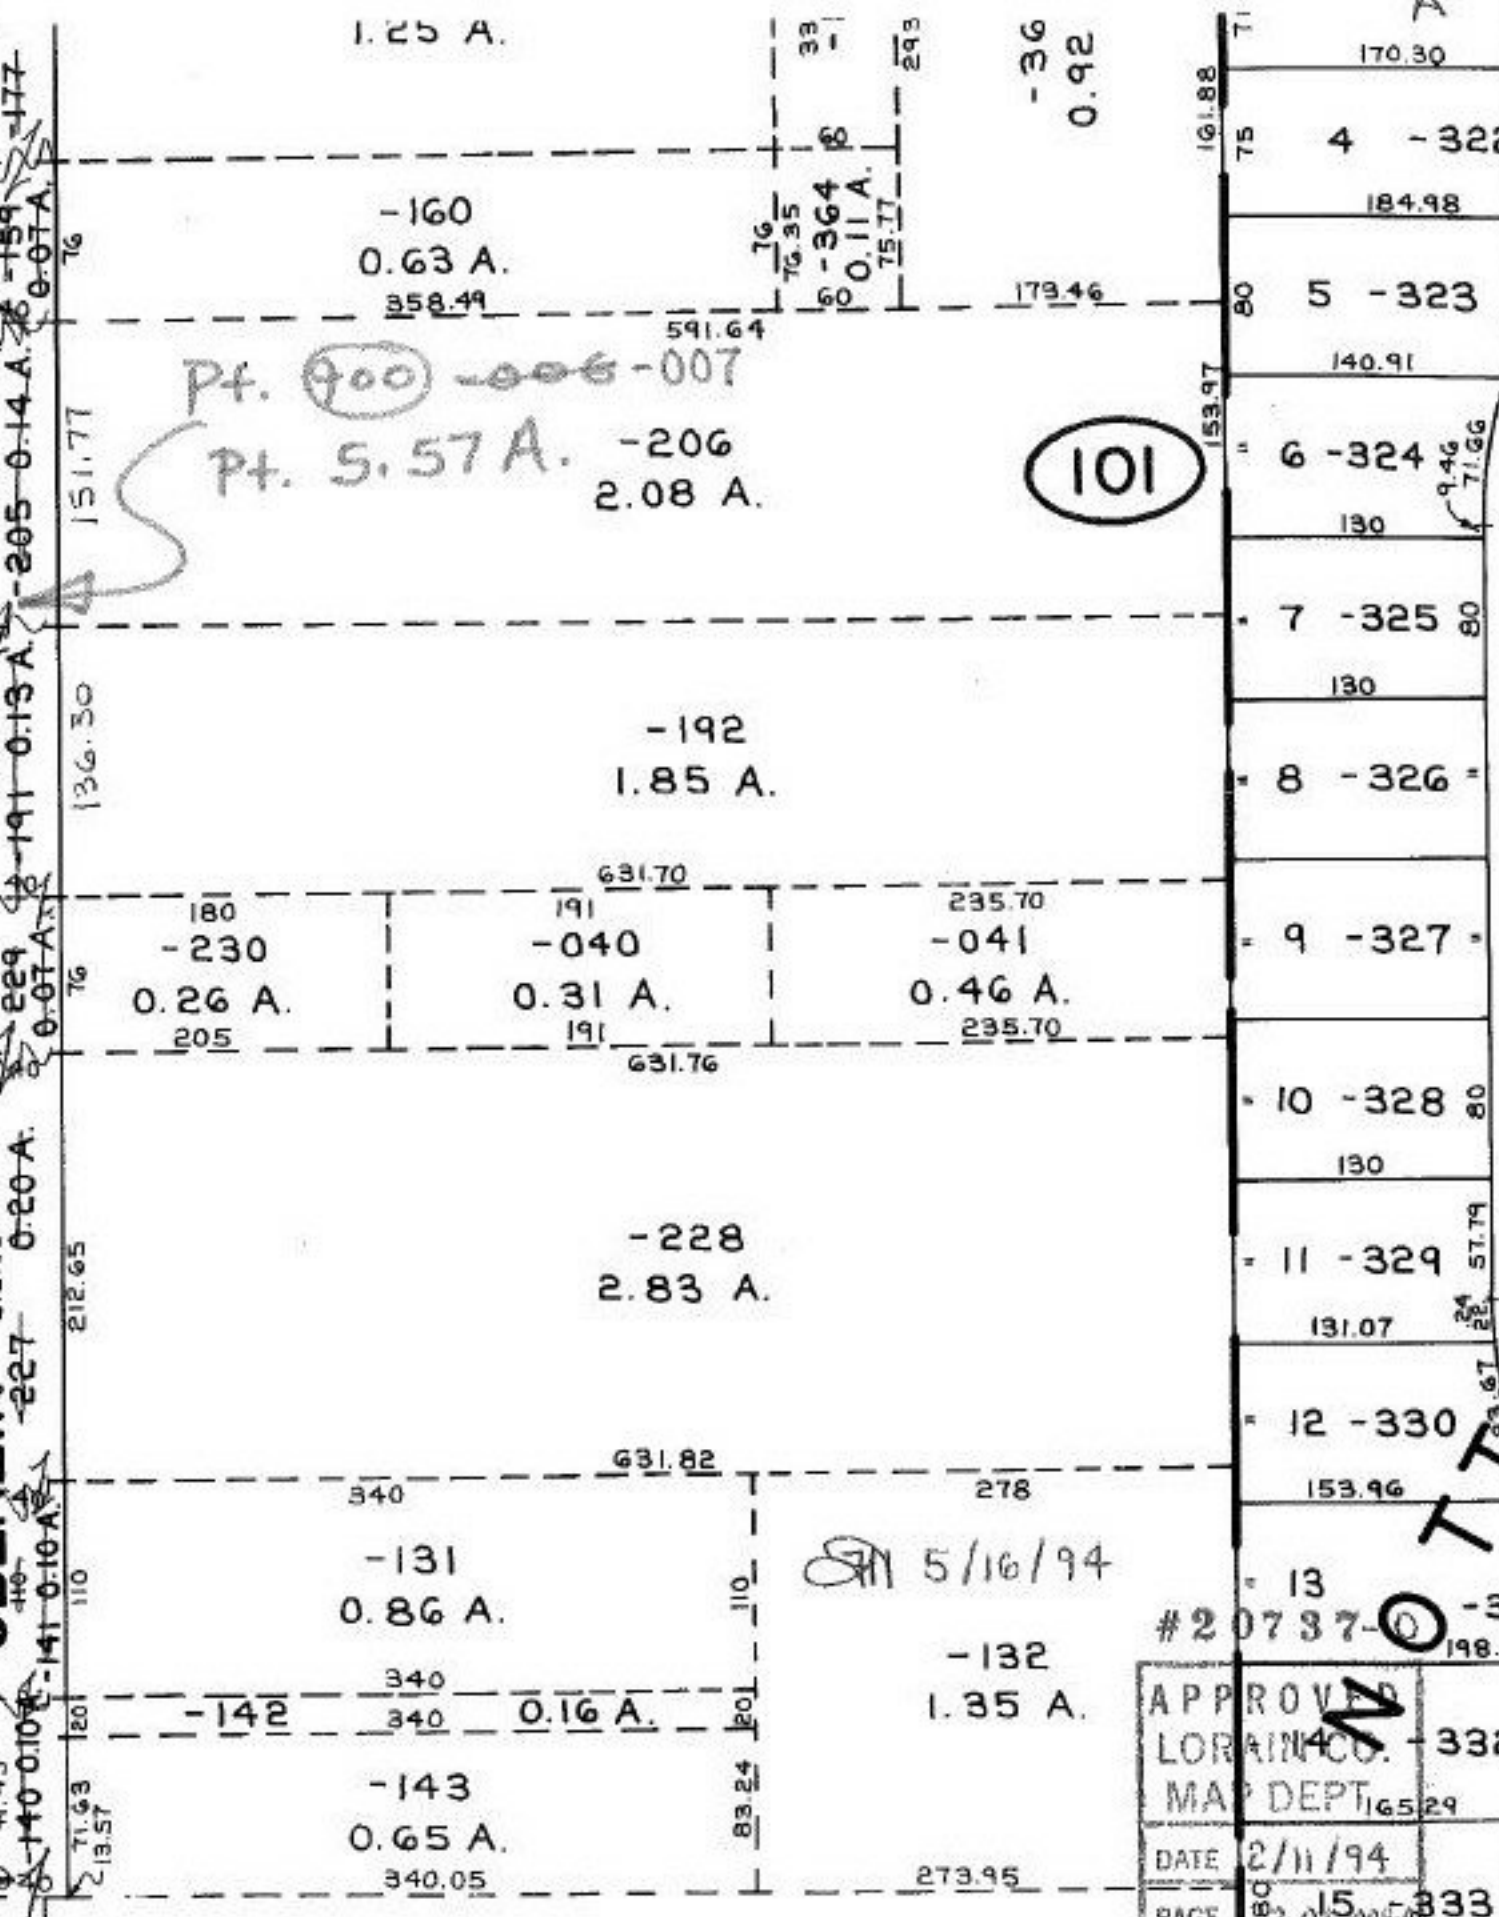

101

SEE 2-01-008-B

APPROVED	LORAIN CO. MAP DEPT
DATE 2/11/94	
PAGE 15	333
BY F. COBERT	
VOID AFTER	20737-0

#20737-0

332

16529

333

333

