


SEE 7-00-008-B

S. 88° 51' E.

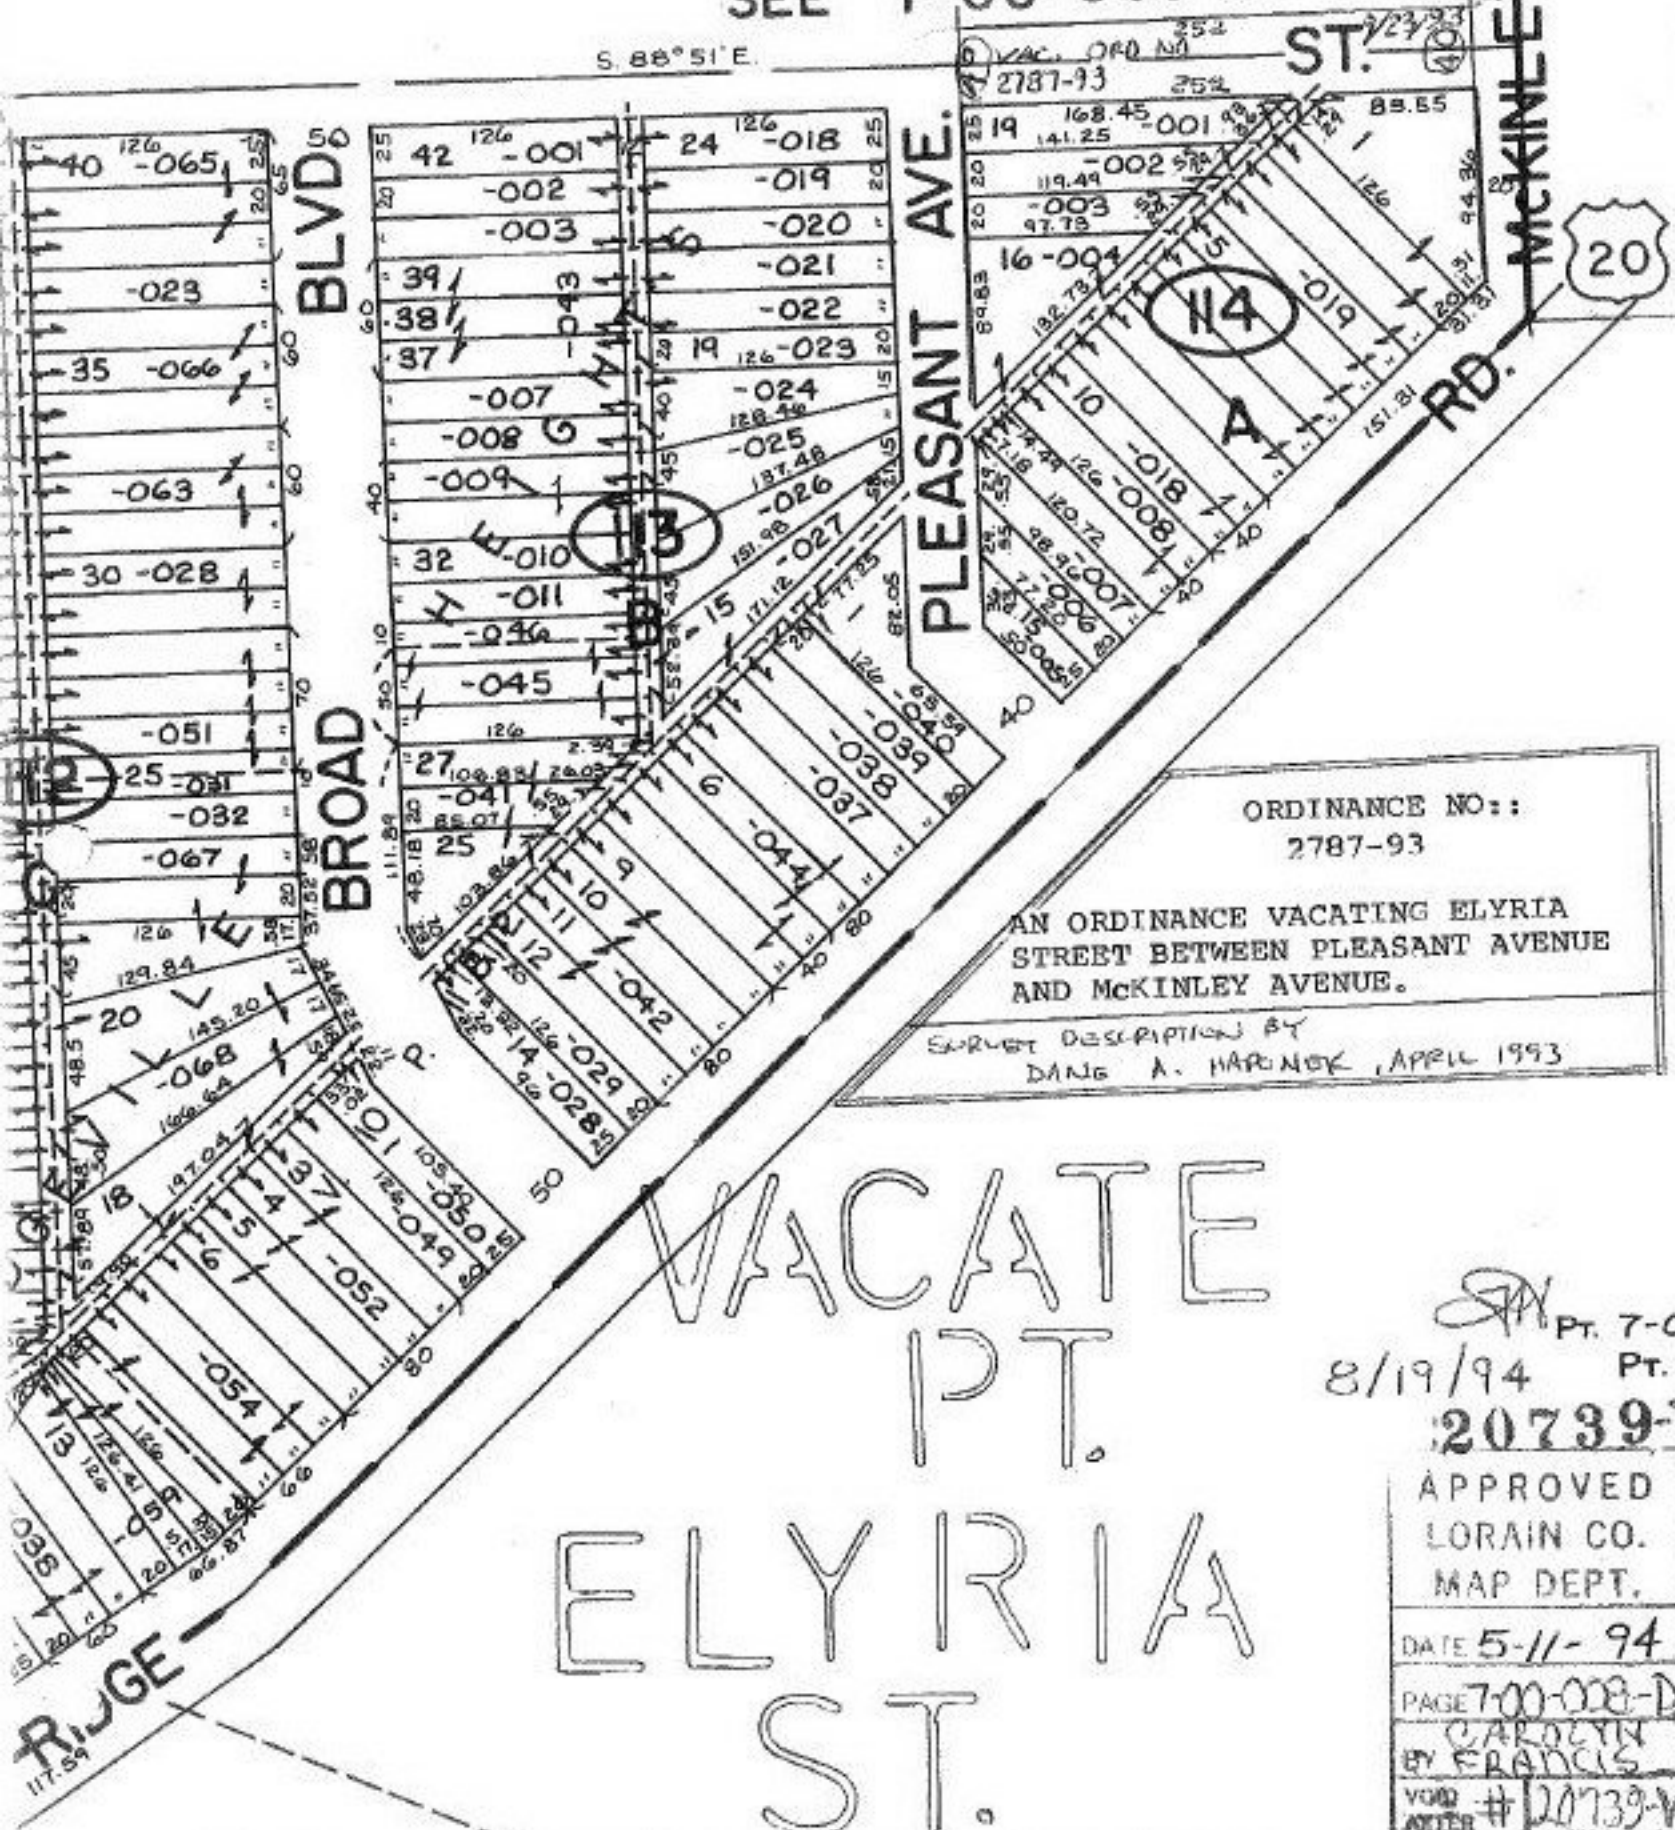

ORDINANCE NO.:  
2787-93

AN ORDINANCE VACATING ELYRIA  
STREET BETWEEN PLEASANT AVENUE  
AND MCKINLEY AVENUE.

SURVEY DESCRIPTION BY  
DANG A. HARNOK, APRIL 1993

VACATE  
PT.  
ELYRIA  
ST.

PT. 7-00  
8/19/94 Pt. 1  
20739-1

APPROVED  
LORAIN CO.  
MAP DEPT.

DATE 5-11-94

PAGE 7-00-008-B

CAROLYN  
BY FRANCIS

VOID  
AFTER # 20739-V

VAC. ORD NO 2787-93 DATE 5-23-93