


RD.

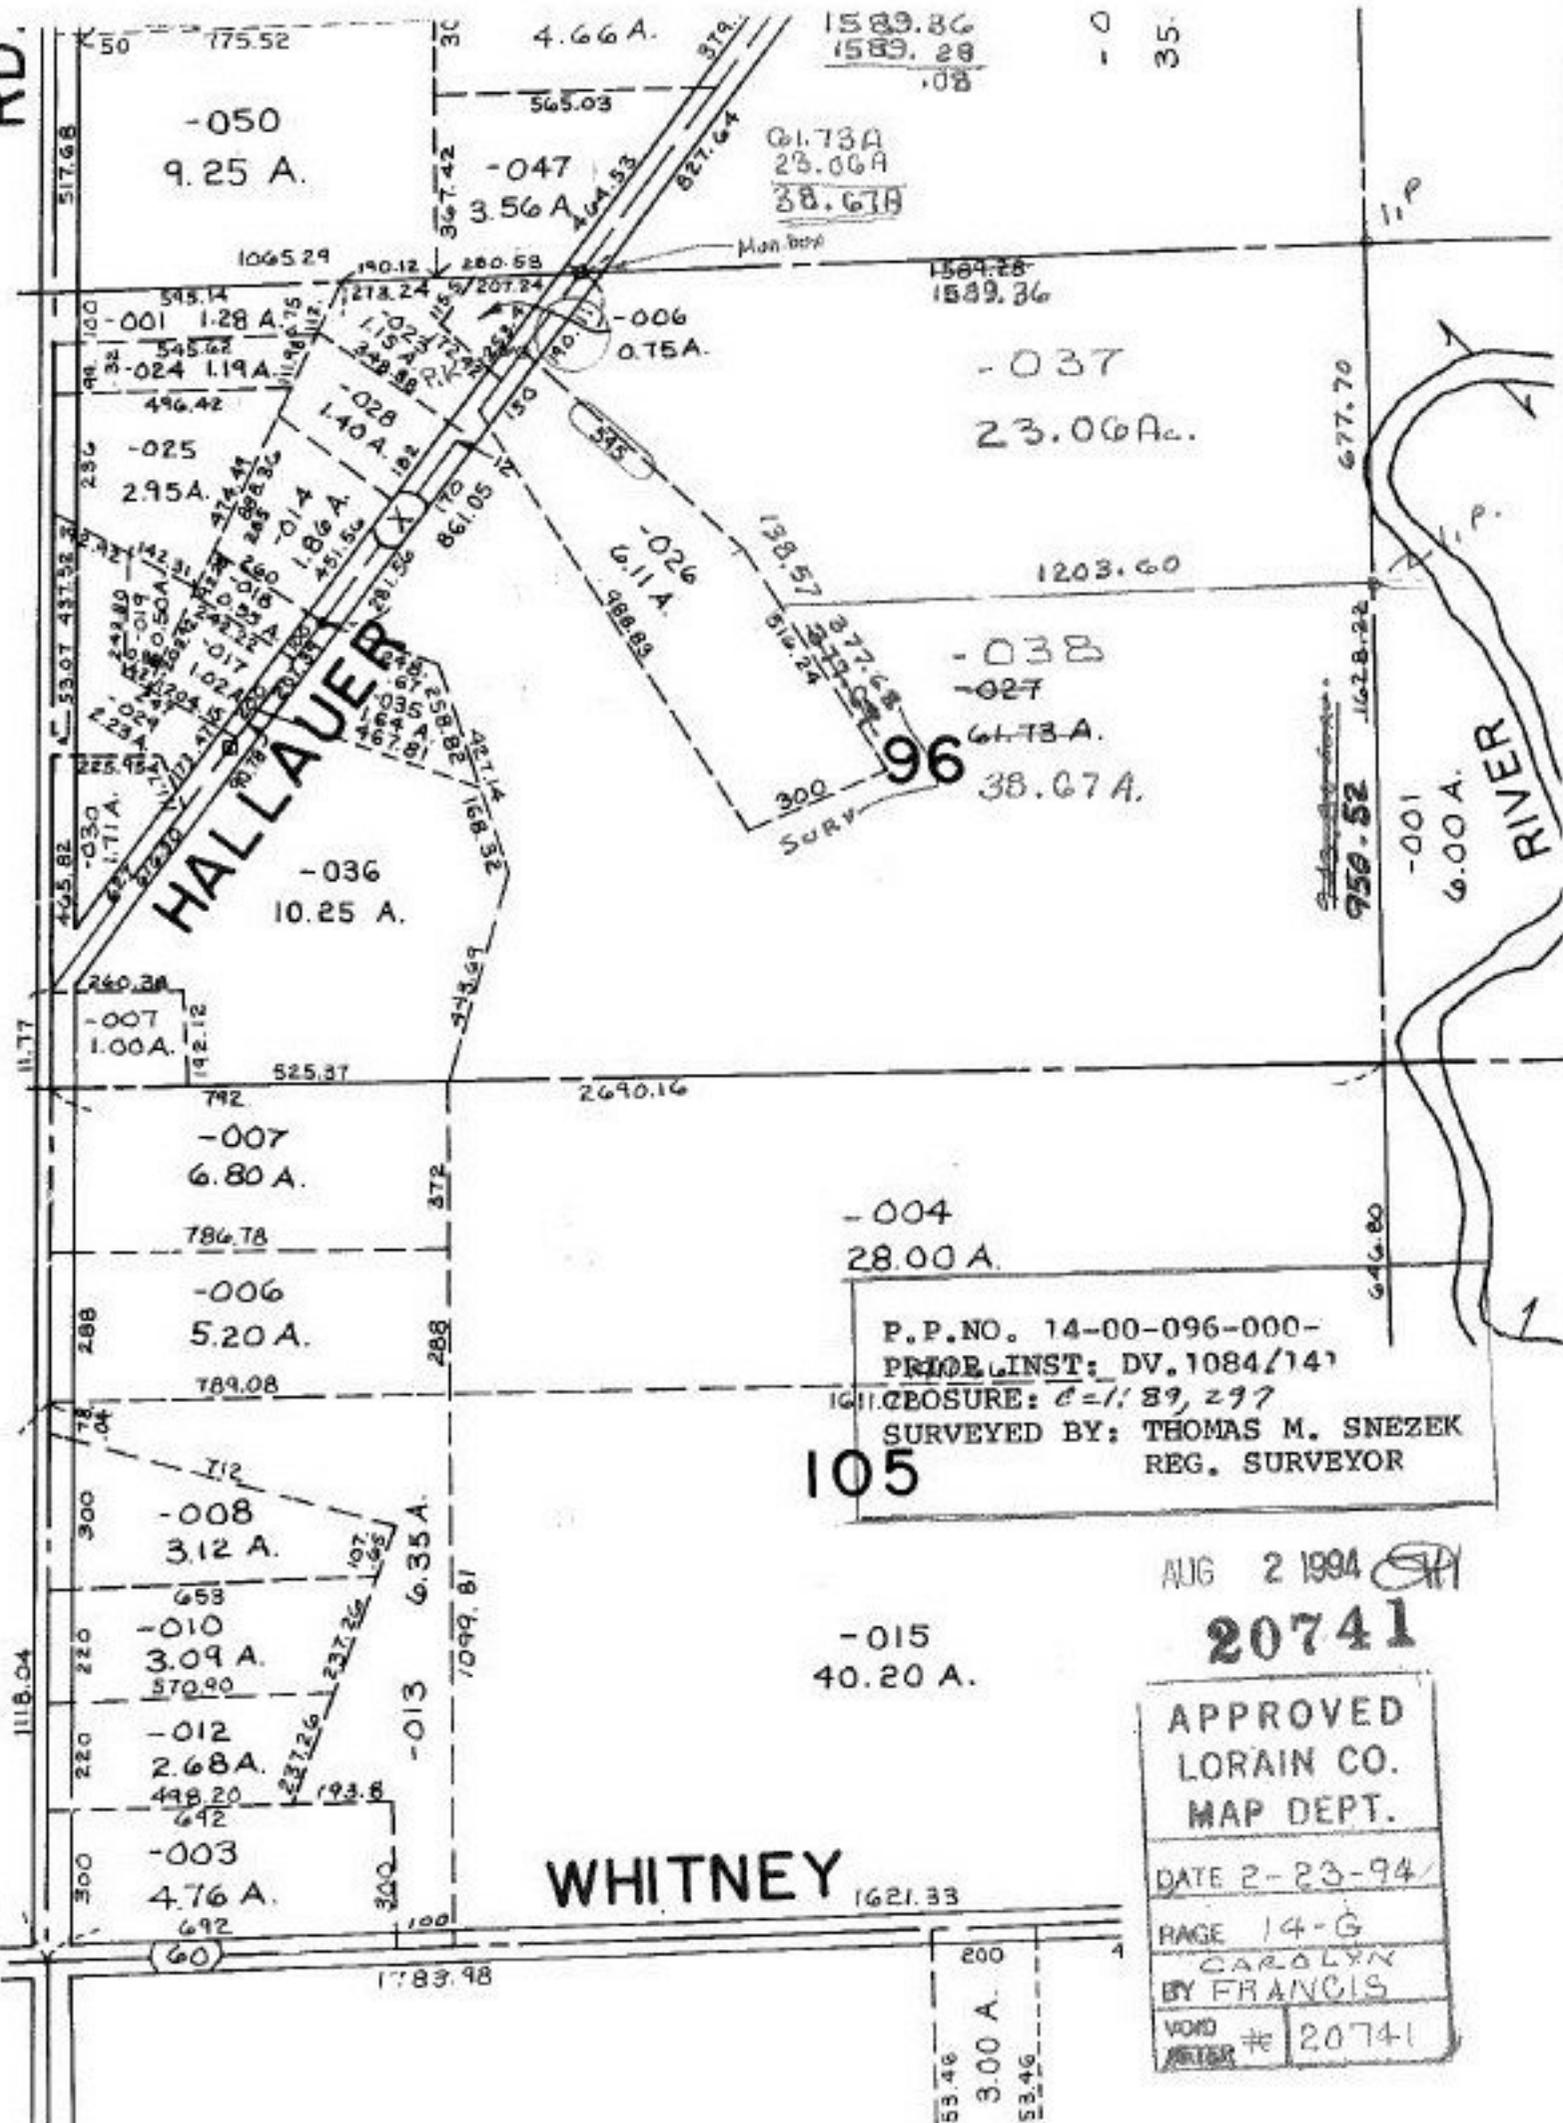

1589.36  
 1589.28  
 .08

61.73A  
 23.06A  
 38.67A

1584.28  
 1589.36

-037  
 23.06A.

1203.60

-038  
 -027  
 61.73A.  
 38.67A.

96

300  
 SURV

HALLAUER

WHITNEY

105

P.P. NO. 14-00-096-000-  
 PRIOR INST: DV. 1084/141  
 ENCLOSURE: C-1: 89, 297  
 SURVEYED BY: THOMAS M. SNEZEK  
 REG. SURVEYOR

AUG 2 1994

20741

APPROVED  
 LORAIN CO.  
 MAP DEPT.

DATE 2-23-94

PAGE 14-G

CAROLYN  
 BY FRANCIS

VOID  
 METER # 20741

14-