


COLLEBIA T  
 East Middle Part  
 Scale 1" = 400'



20747 A

APPROVED
LORAIN CO.
MAP DEPT.
DATE 3-23-94
PAGE OLD TAX MAP Pg. 12
CASOLIN
BY FRANCIS
VOID # 20747A

12 OLD TAX MAP

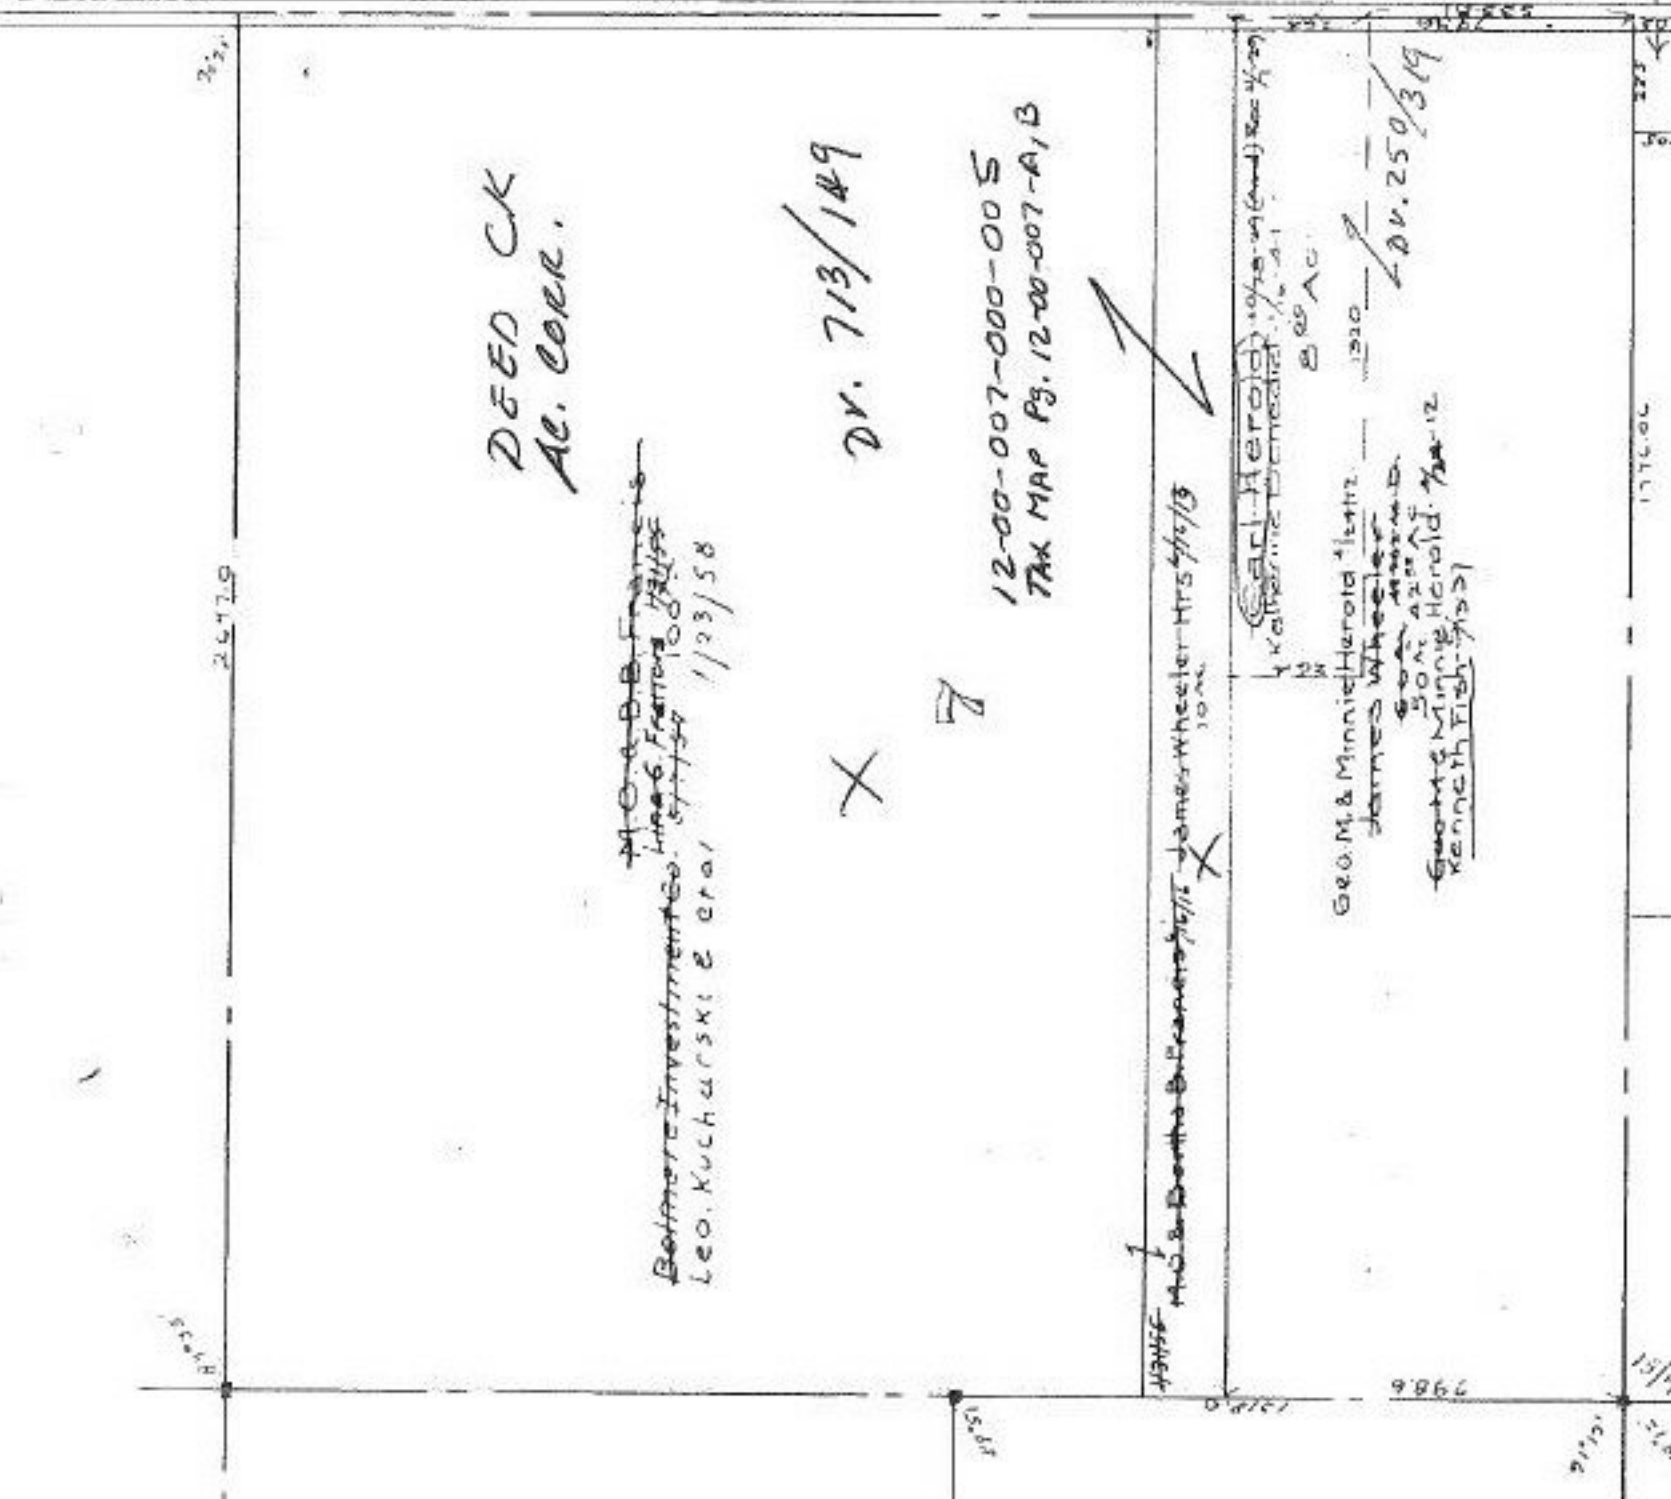

DEED CK  
 AC. CORR.

M.O.D.B. Francis  
 Baltimore Investment Co. 1/23/58  
 Leo. Kucharski & Co. 1/23/58

Dr. 713/149

12-00-007-000-005  
 TAX MAP Pg. 12-00-007-A, B

Geo. M. & Minnie Herold  
 James Wheeler

Geo. M. & Minnie Herold  
 James Wheeler

Geo. M. & Minnie Herold  
 Kenneth Fish

Robert & Mary Lou Berger 9/29/61