


SEE 15-D

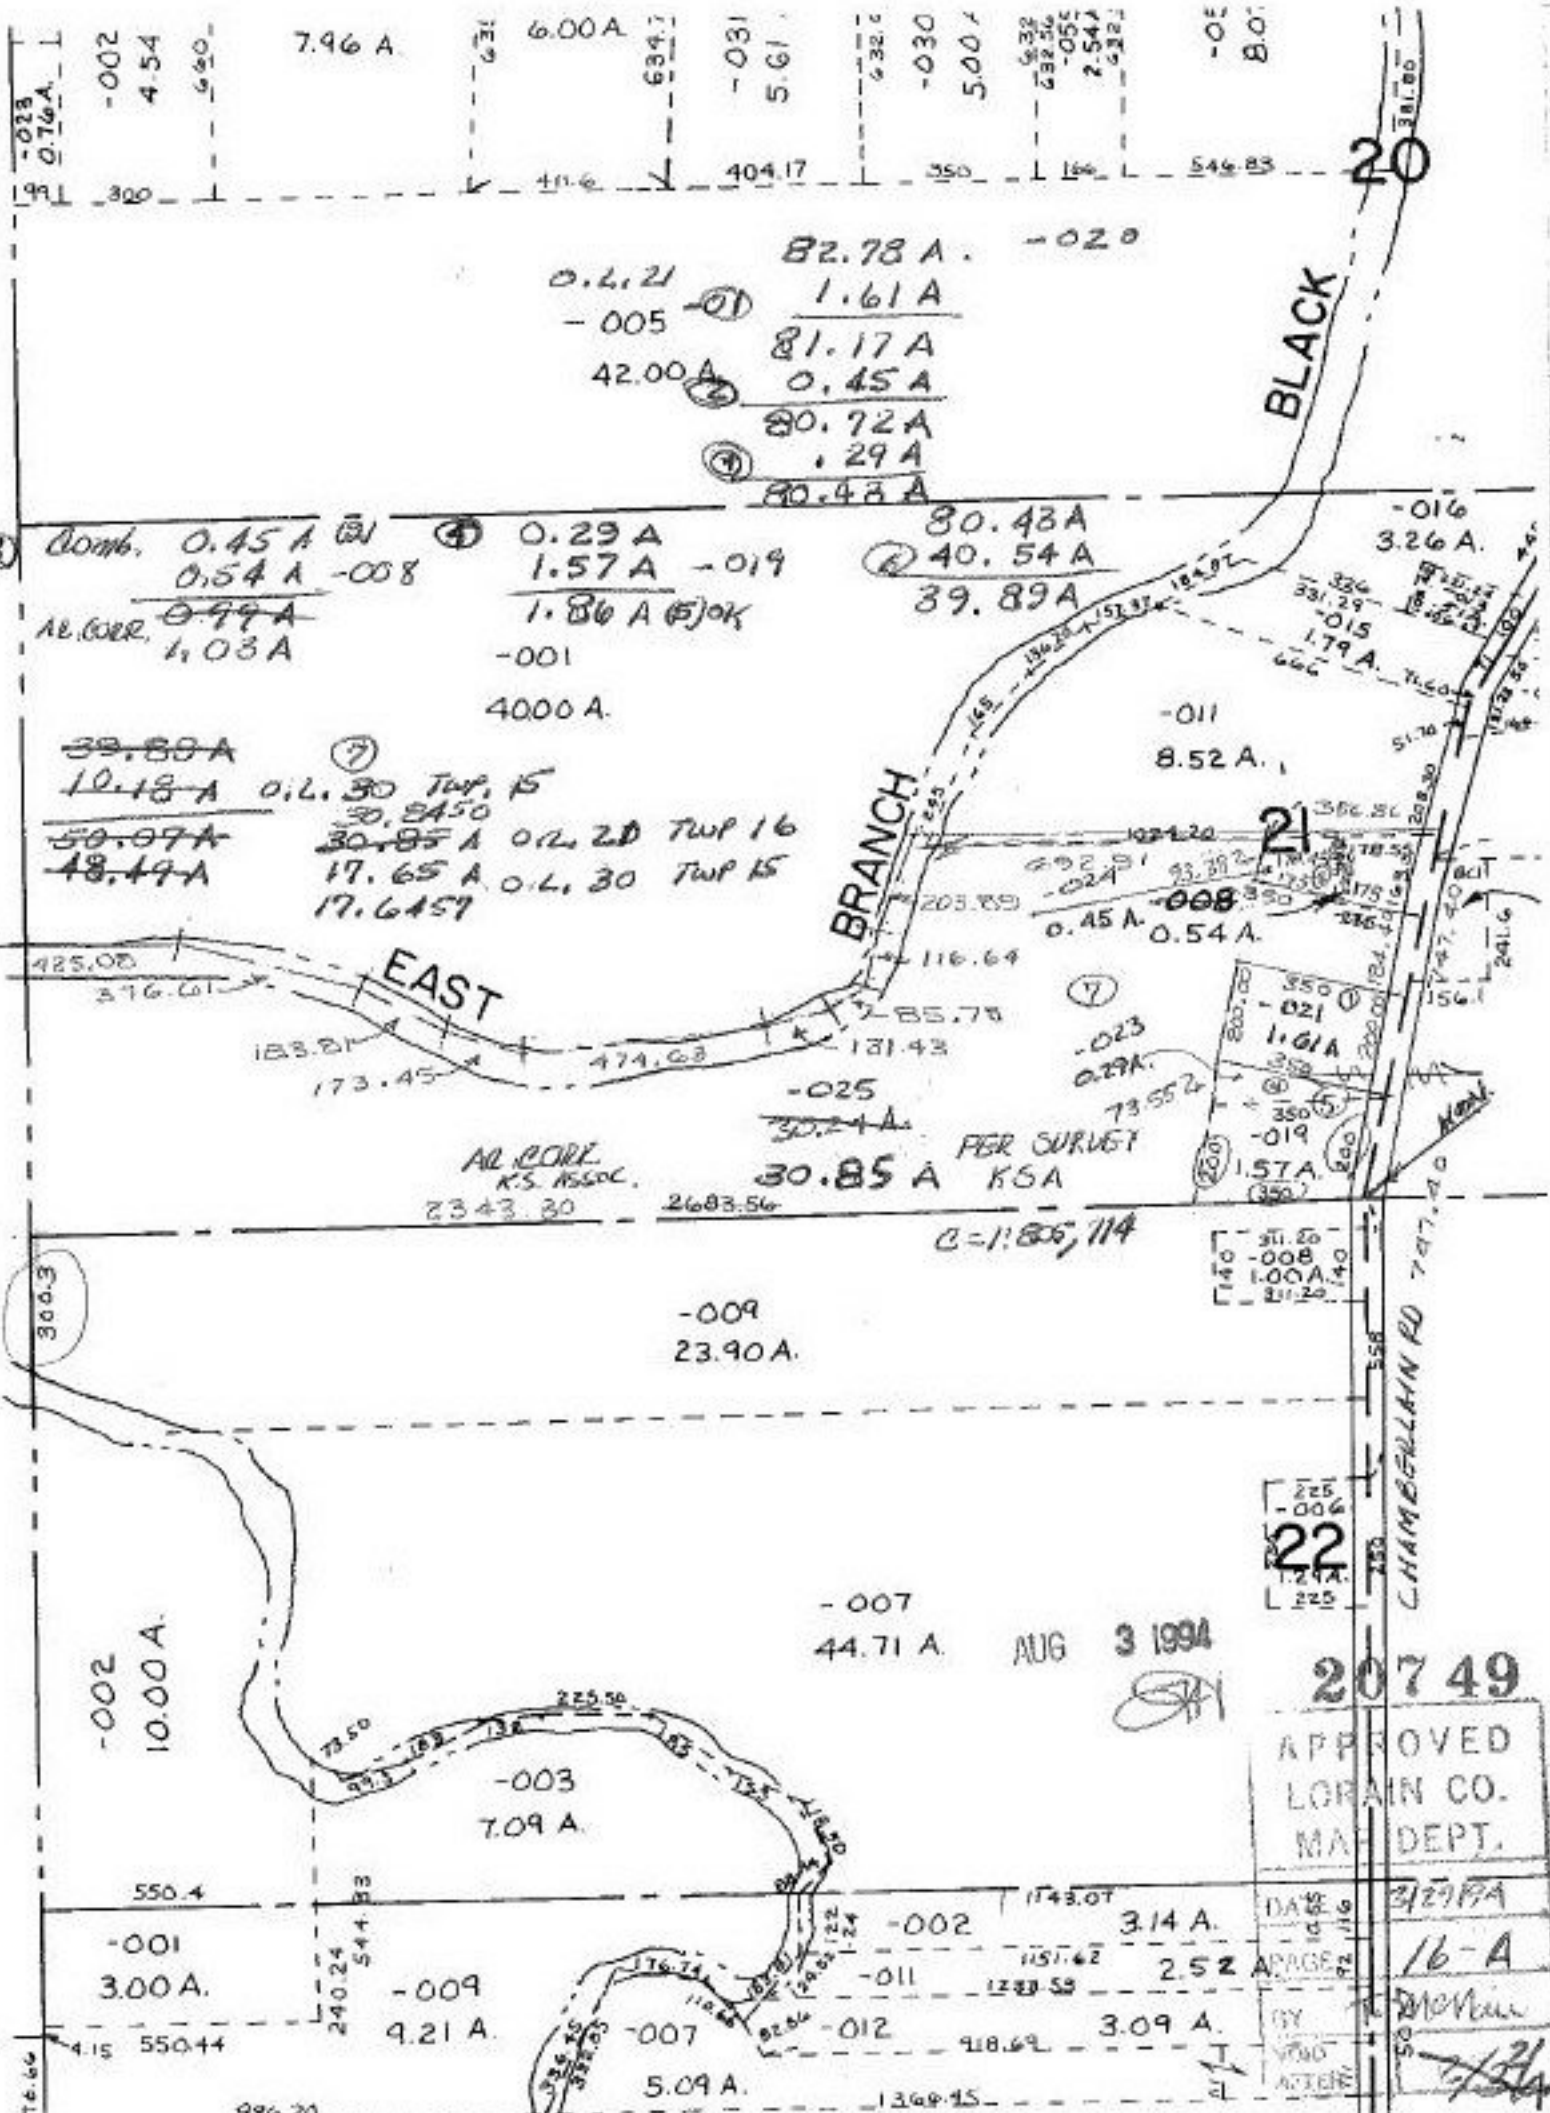

<b>22</b>	
221	225
222	226
223	227
224	228
225	229
<b>207 49</b>	
APPROVED	
LORAIN CO.	
MA. DEPT.	
DATE	3/29/94
PAGE	16-A
BY	[Signature]
WHO	
ATTN	