



2075

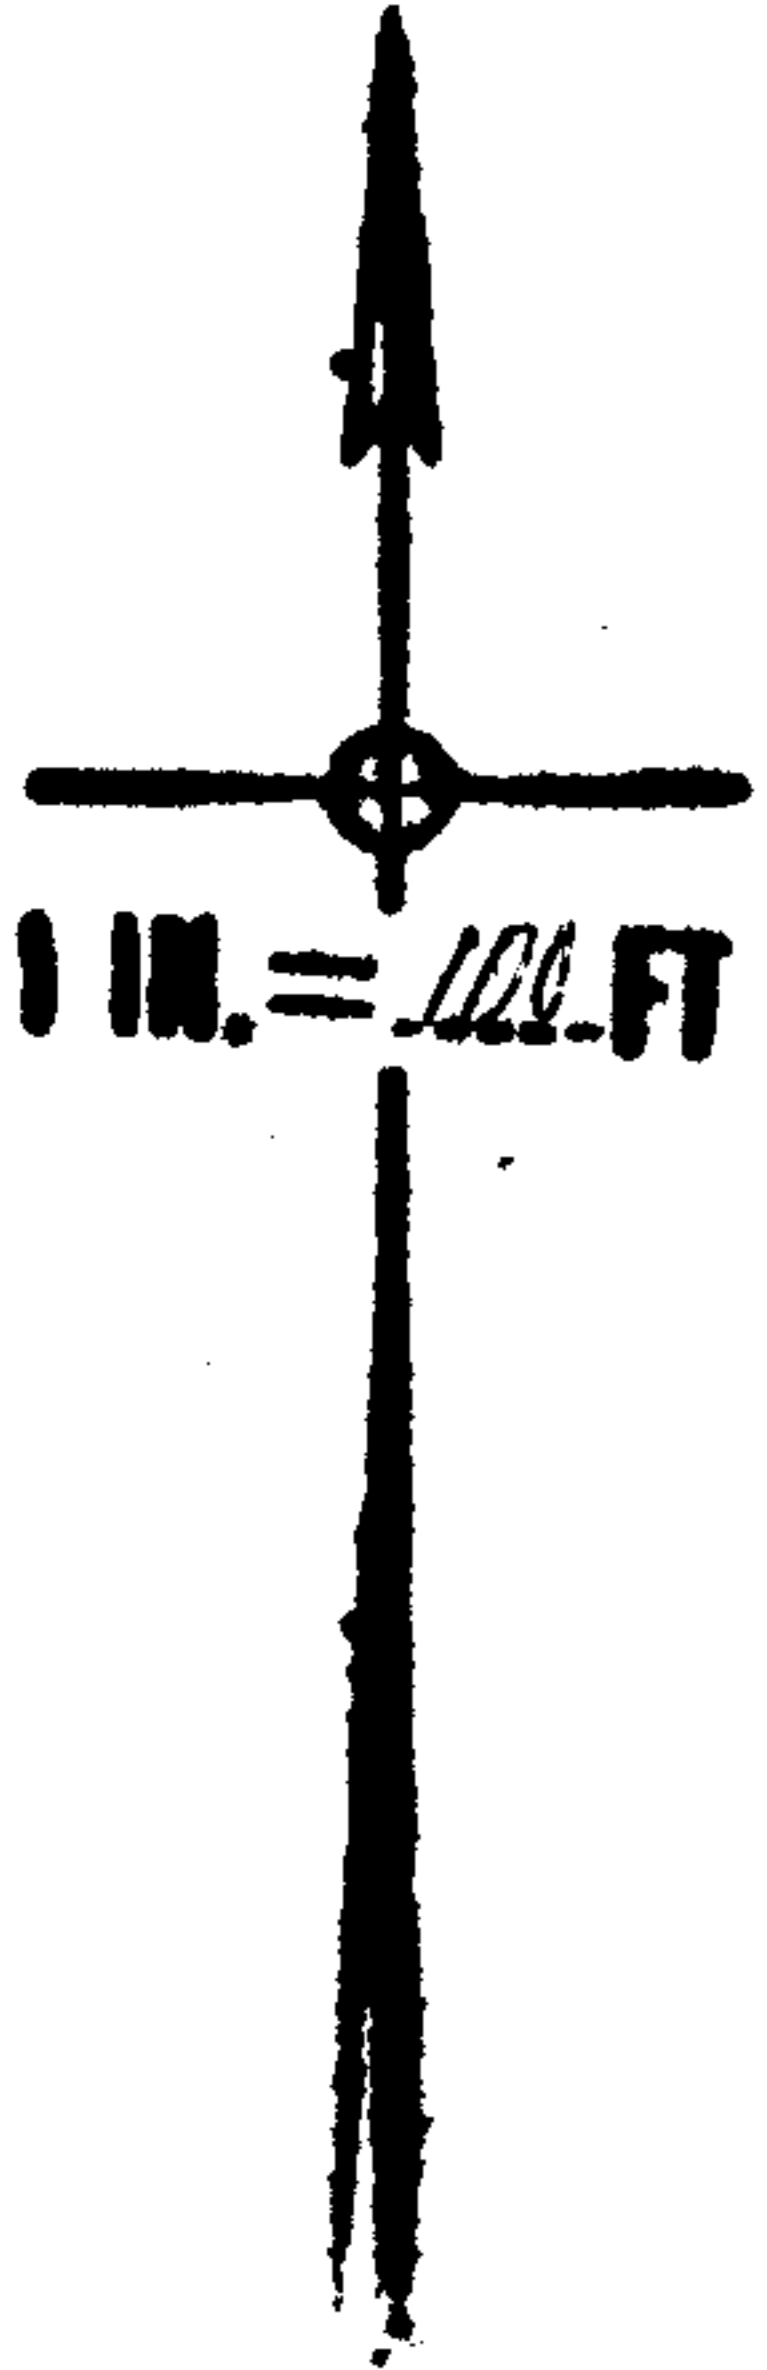

MILAN - ELYRIA  
100

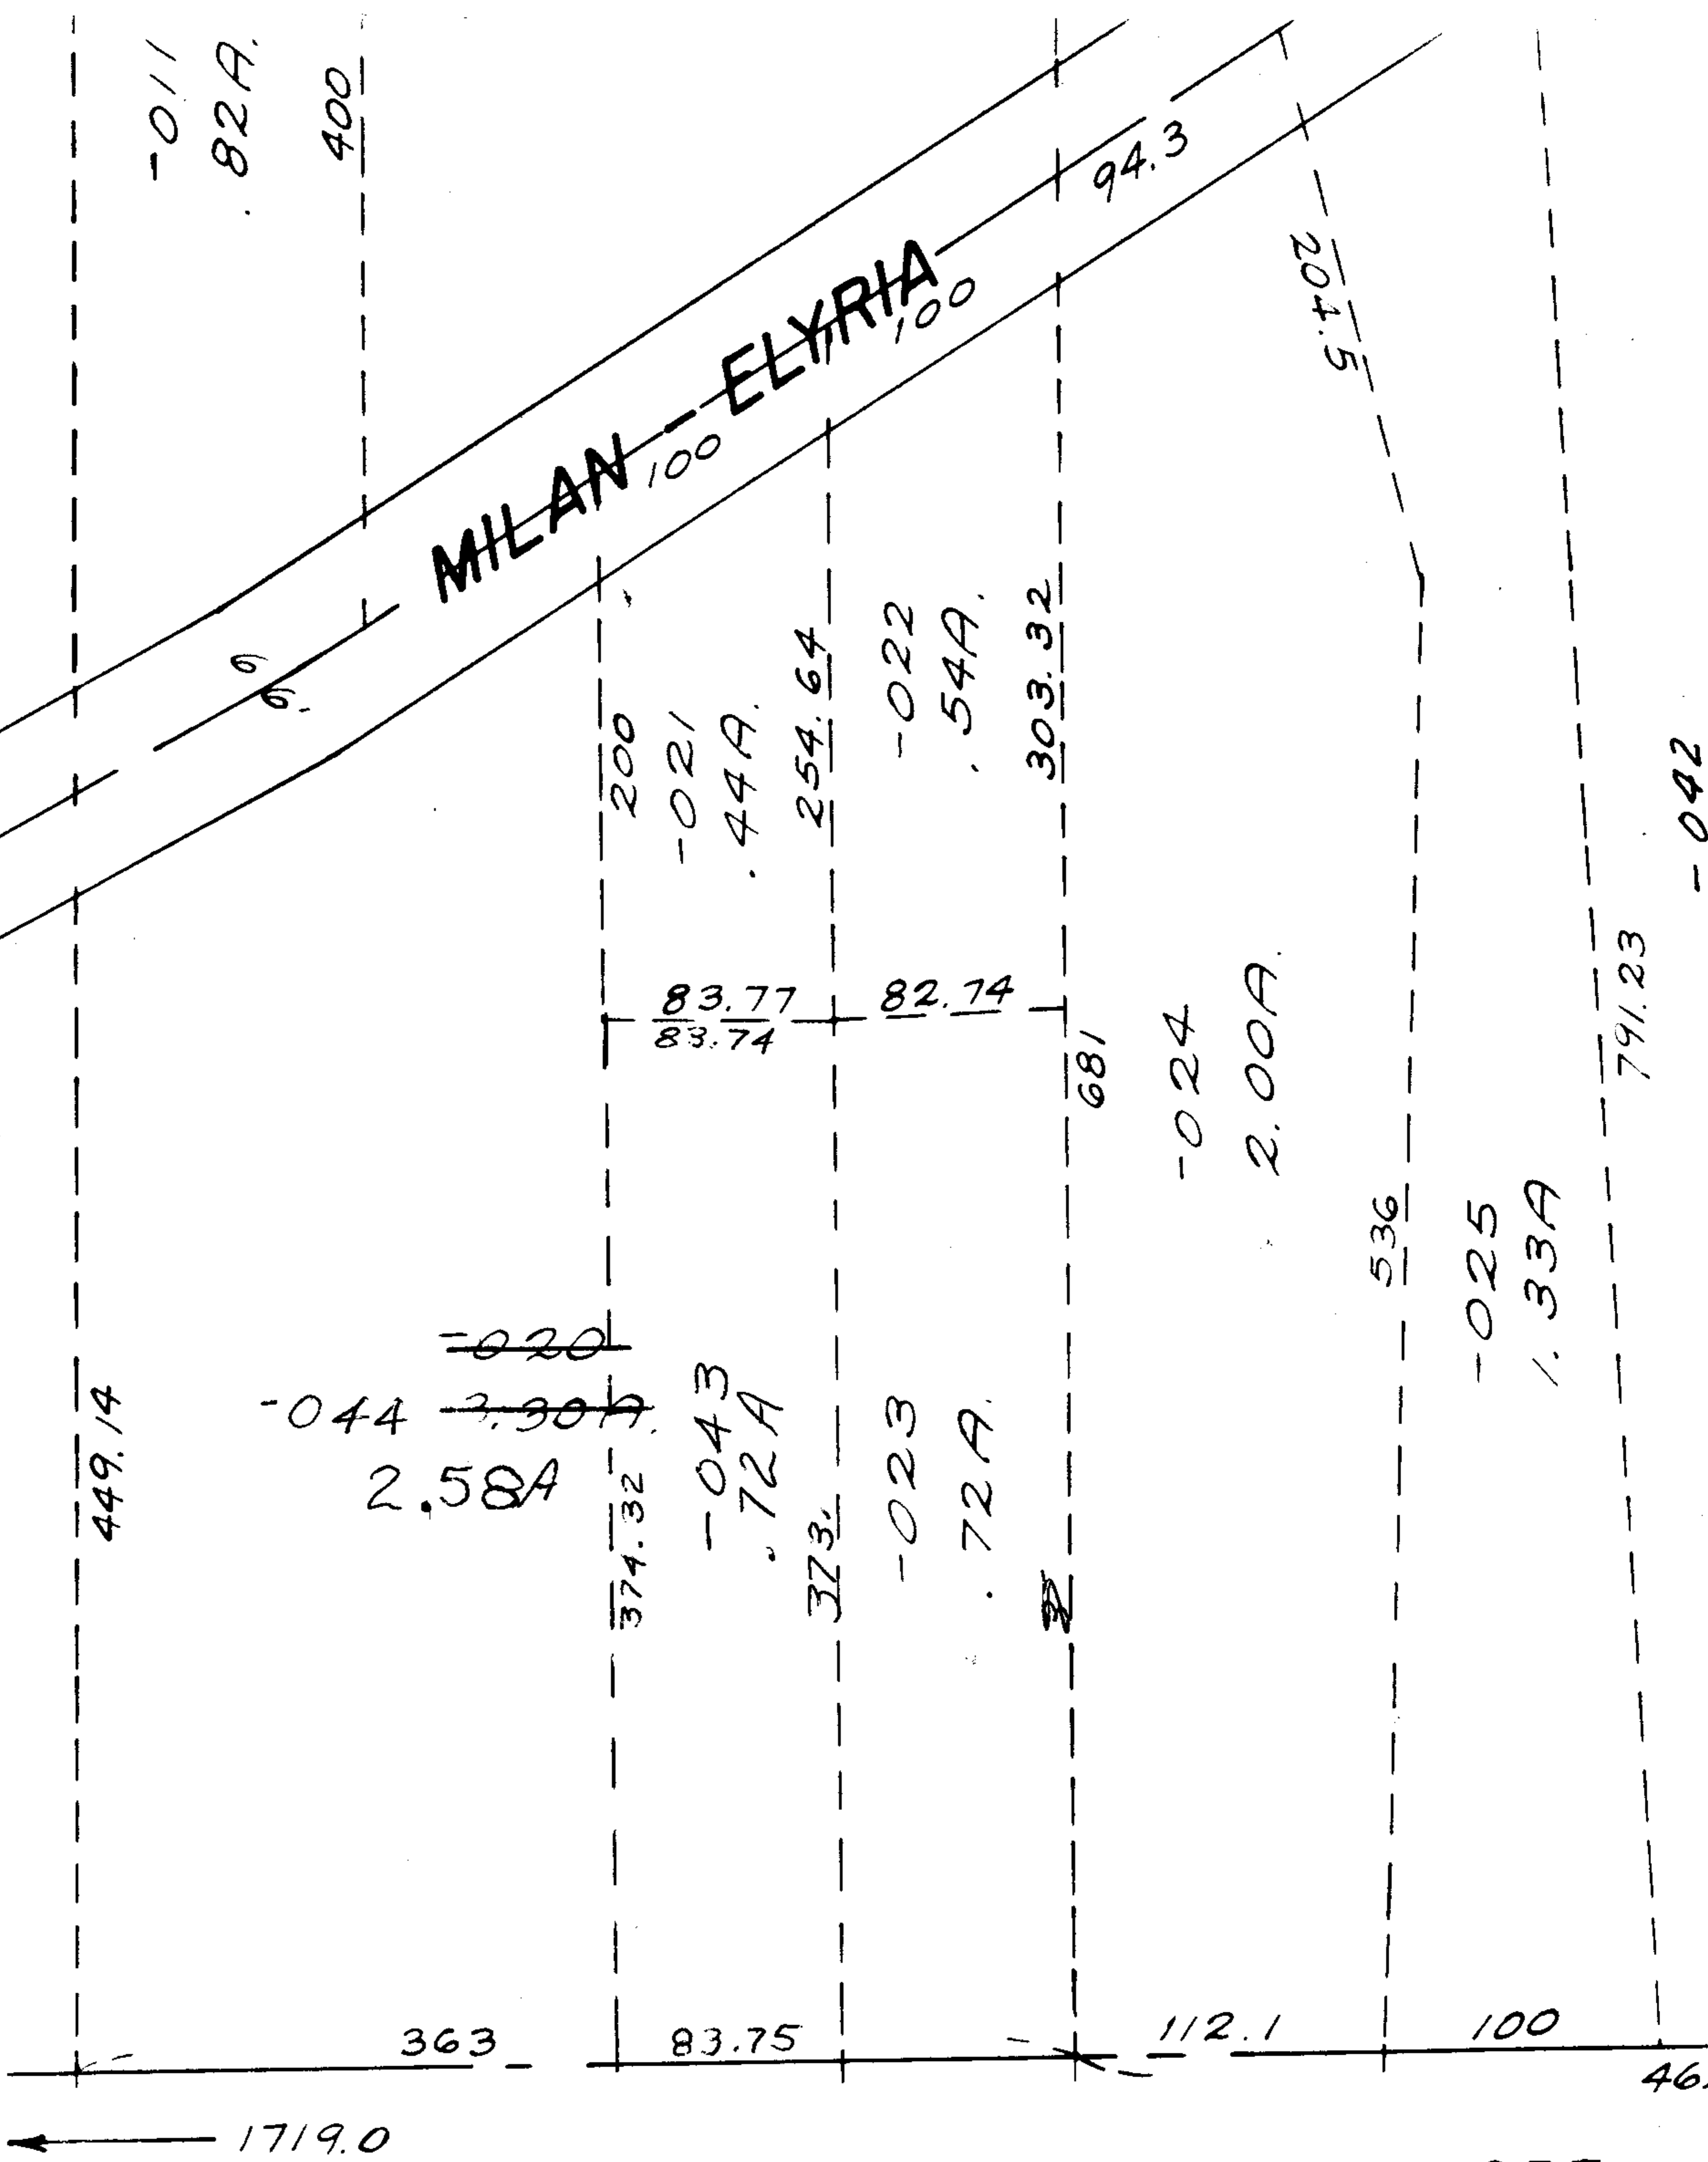

APPROVED  
 LORAIN CO.  
 MAP DEPT.  
 DATE 9-4-68.  
 5-00-029B  
 BY *Grace*

T-14-80 800.



Done 11-2-68.

*Grace*

SEE