


SEE II-00-100-B

PARSONS RD. 1575.84

792.76 RRS to RRS AS NOTED

101

Pt. 16-00-001-101-020
Pt. 3-53A
7.71A
Ac. Corr. Per Survey
GARY PENFOUND
REG. Surveyor

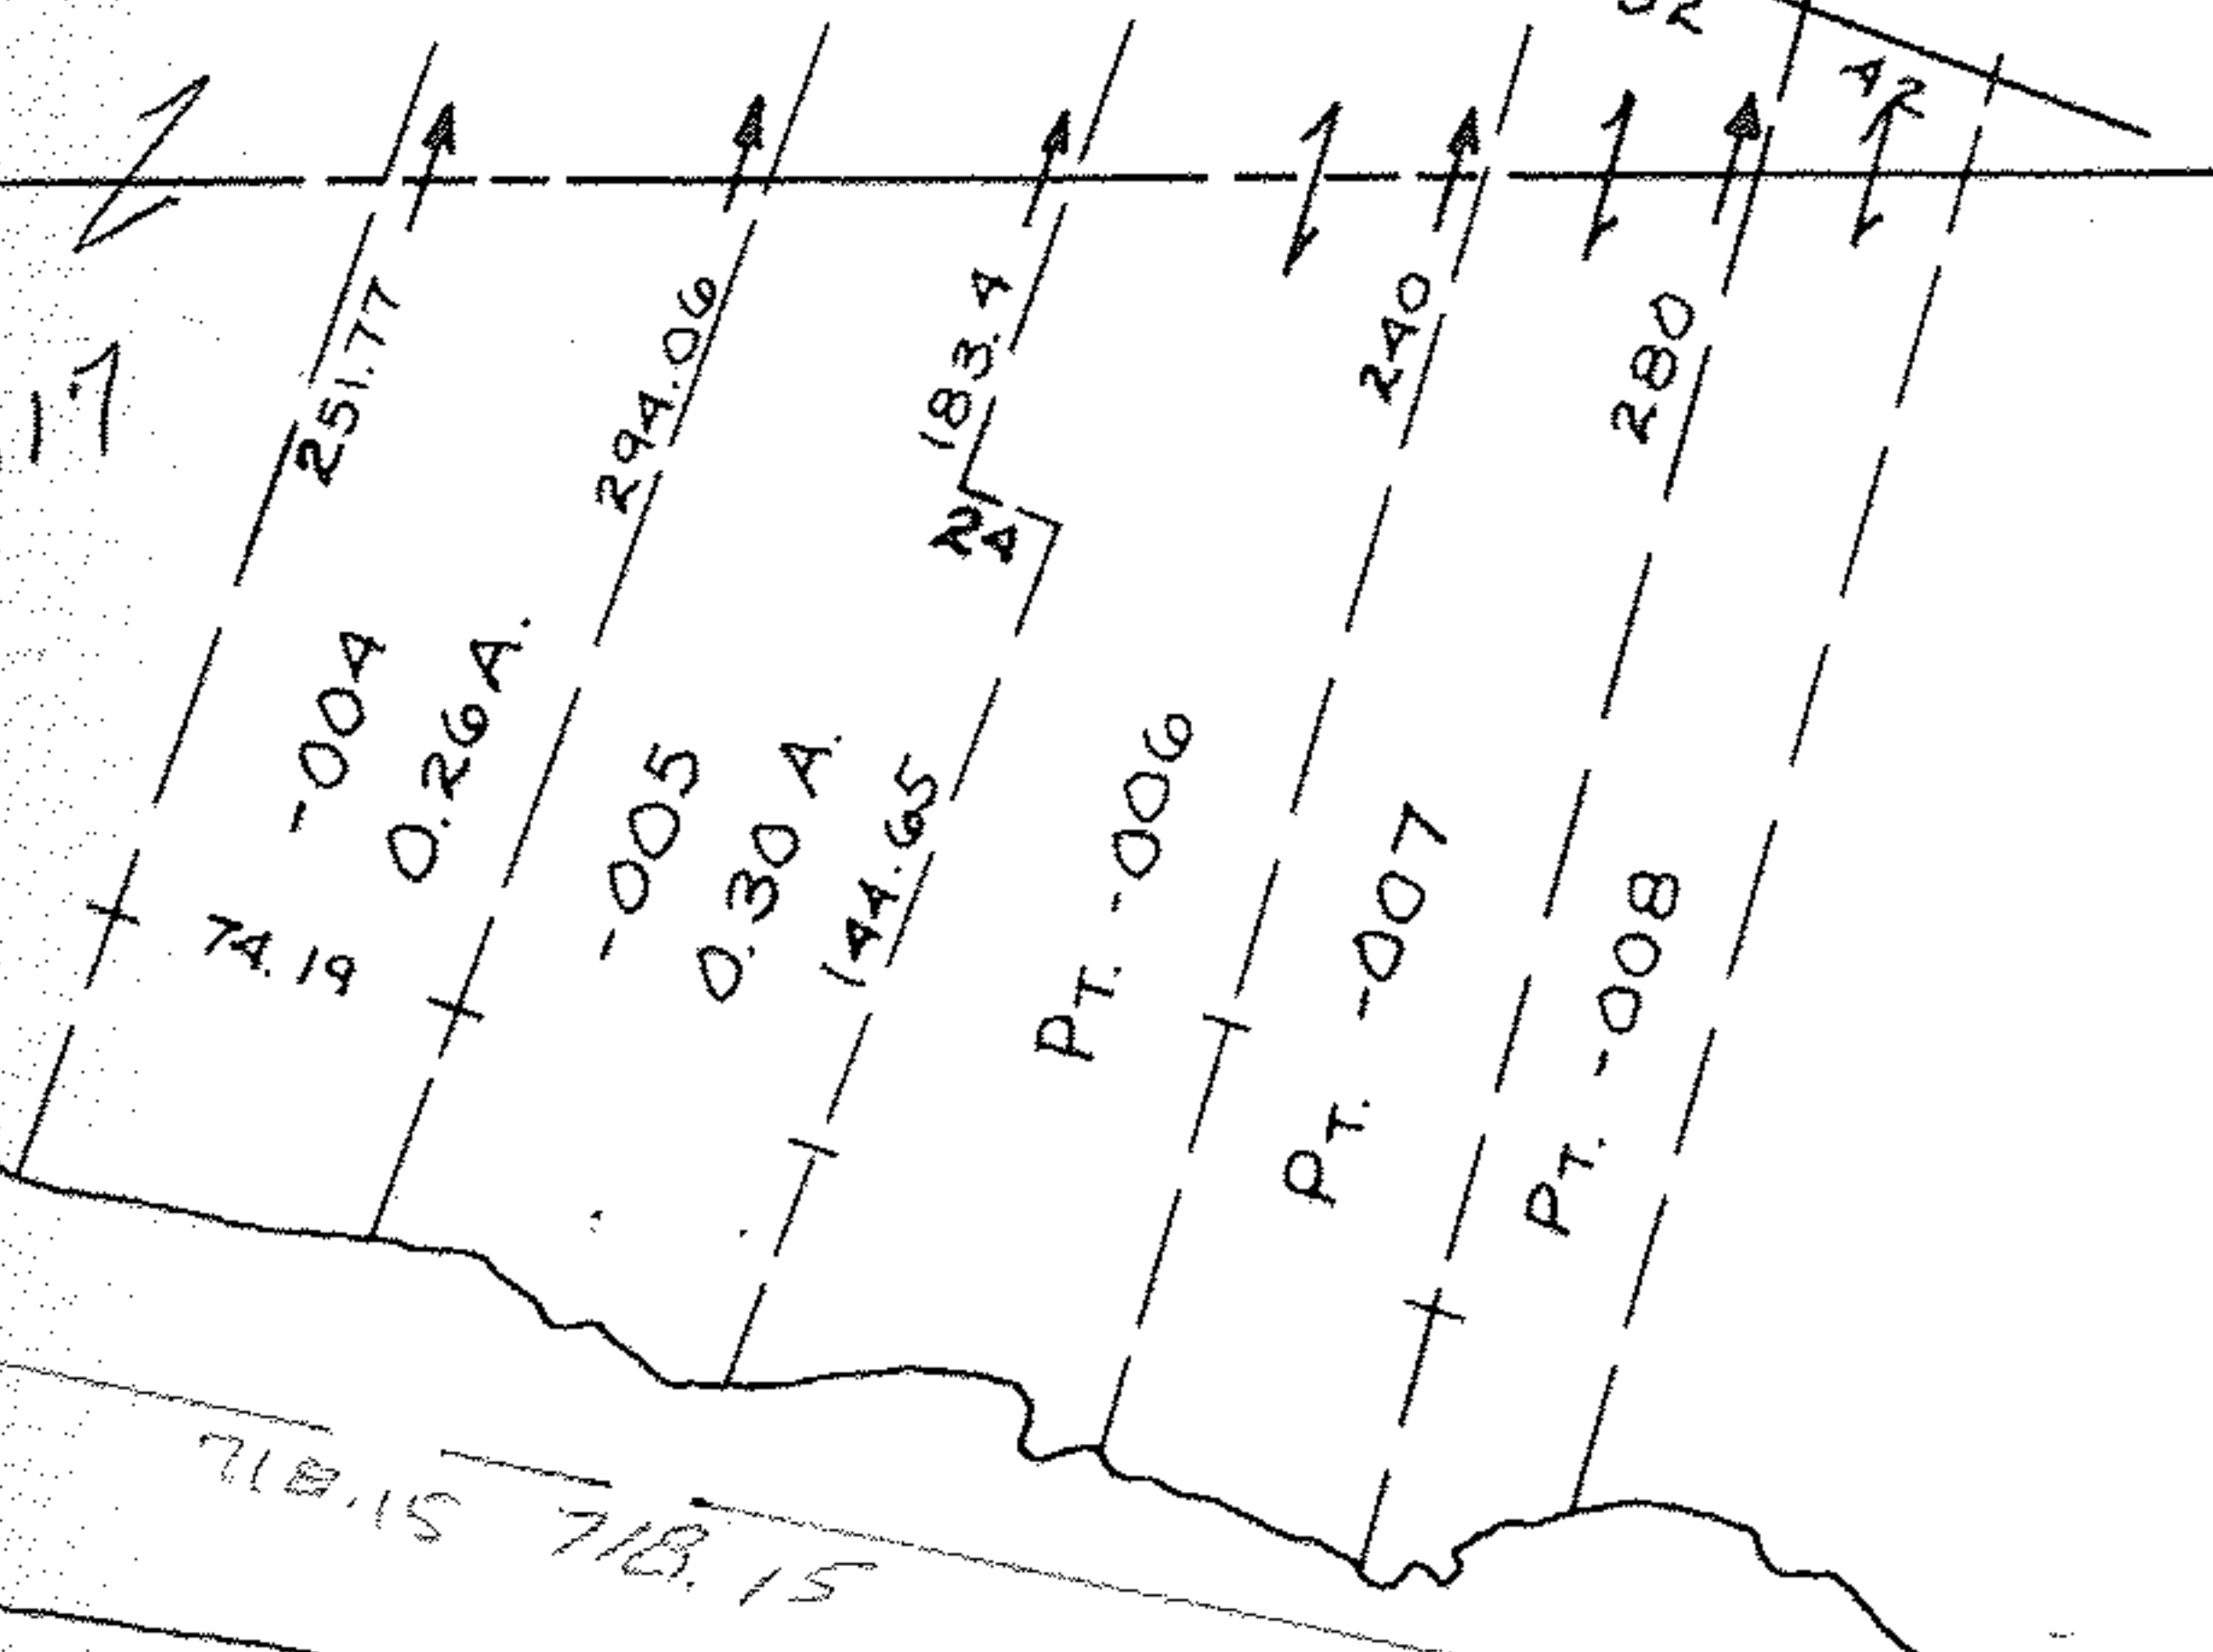

16-00-002-101-003 14.79A
-019-101-001 1.09A
-002-101-004 16.56A
001-101-019 67.14A
AL. PEIZ ROUNDING 99.58A
DEED 99.57A
CALC CURVE IN SPLIT 99.22A

Put in Break Line
99.57 C=1:10 631,730.

20753

APPROVED
LORAIN CO.
MAP DEPT.
DATE 3-14-94
PAGE 16-00-001-B
CAROLYN
BY FRANCIS
VOID AFTER # 20753

101

Pt. 019
-003 -018
28.11A
Pt. 67.14A

SPLIT

16-00-001-101-

CURVE R=10372.22
B=1097.74
CH 1097.23
8775
R=10372.22

500

20753

APPROVED
LORAIN CO.
MAP DEPT.
DATE 3-14-94
PAGE 16-00-001-B
CAROLYN
BY FRANCIS
VOID AFTER # 20753

AUG 3 1994

20753

APPROVED
LORAIN CO.
MAP DEPT.
DATE 3-14-94
PAGE 16-00-001-B
CAROLYN
BY FRANCIS
VOID AFTER # 20753

ST. L.

102

-001
5.00A

SEE 16-00-001-A

Put in Break Line

101

-002
0.62A

Pt. 16.56A

16-00-002-101-
Comb

-001 15.62A
-002 0.62A
16.24A
Ac. Corr 16.56A

4.62A
2.48A
7.10A

R.R. 100

RIVER

3