


16-00-002-101-003	14.79A
-019-101-001	1.09A
-002-101-004	16.56A
-001-101-019	67.14A
AC. PER ROUNDING.	99.58A
DEED	99.57A
CALC	99.82A

CURVE IN SPLIT
99.57A @ 4:10, 631, 730.

20753
APPROVED
LORAIN CO.
MAP DEPT.
DATE 3-14-94
PAGE 16-00-001-A
BY CAROLYN
FRANCIS
VOID AFTER # 20753

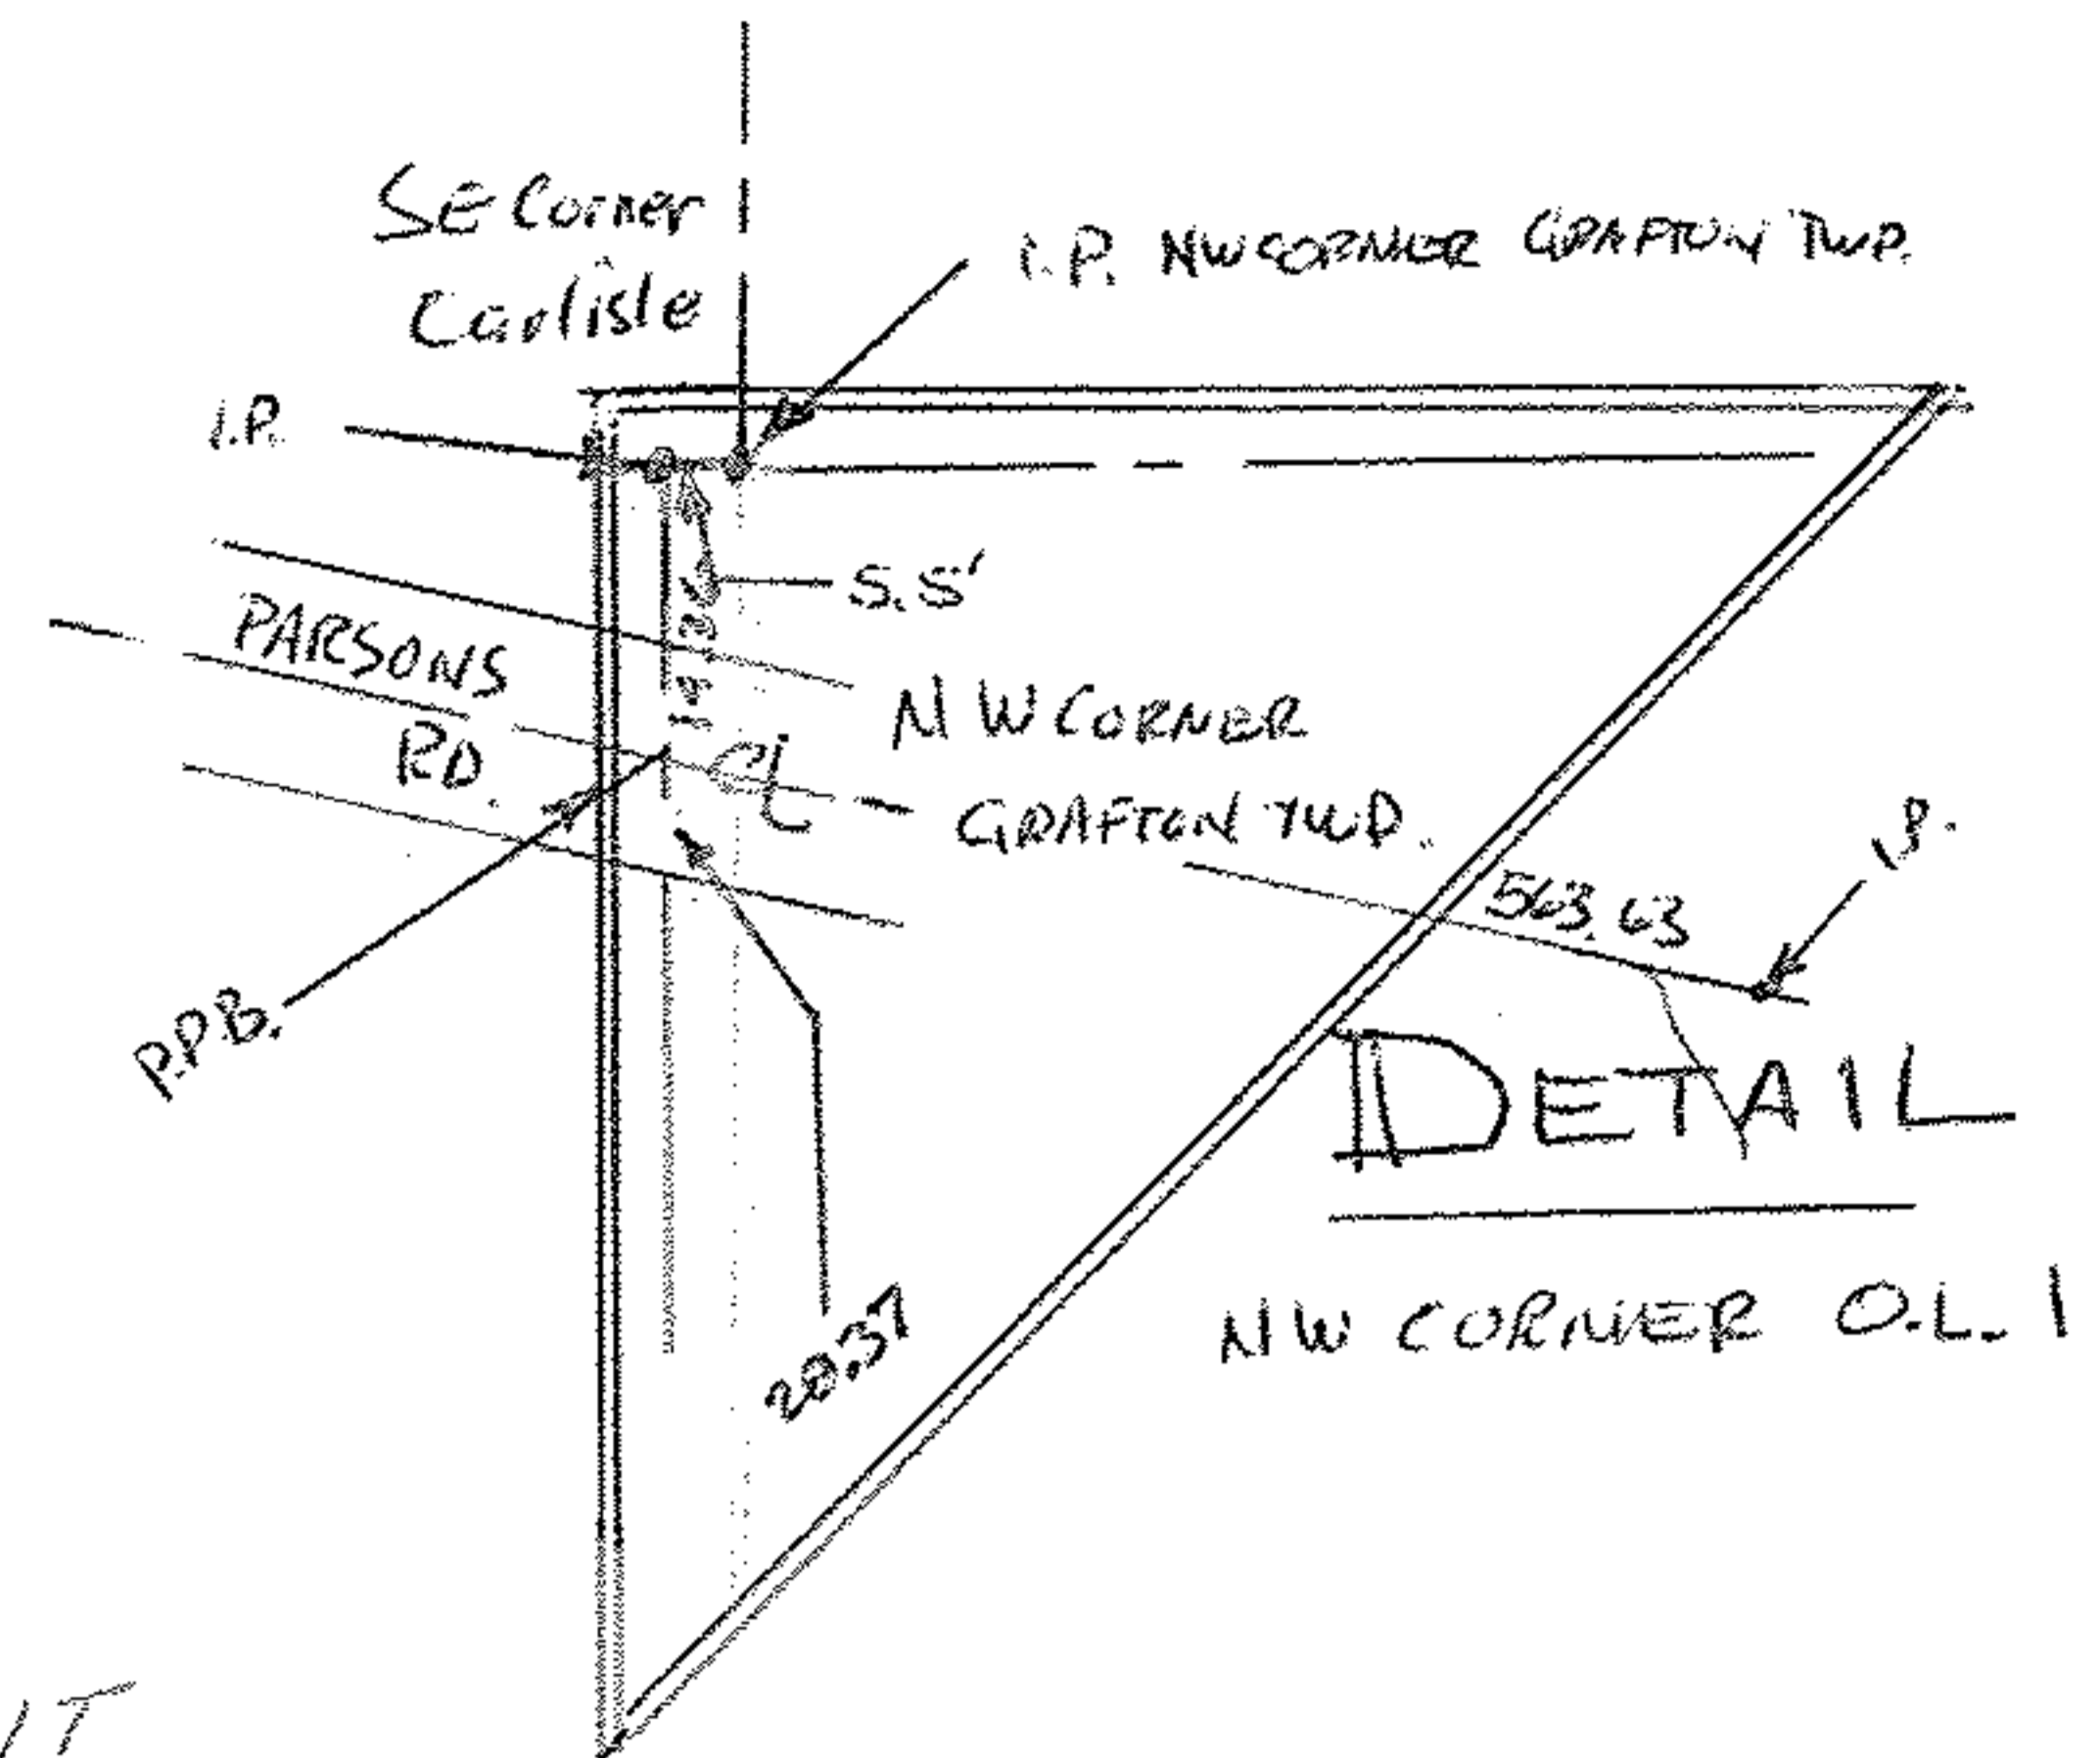

① 16-00-002-101-003	13.27A AC. CORR.	14.79A
② 16-00-019-101-001	1.50A AC. CORR.	1.09A
③ 16-00-002-101-001	15.62A COMB	
-002	0.62A COMB	
	16.24A AC. CORR.	16.56A

SPUT

④ 16-00-001-101-001	42.62A
-018	28.11A
	70.73A
AC. SPLIT OUT	67.14A
	3.59A
AC. CORR. PER REFOUND REG SURVEYOR	7.71A

101

Pt. 019

-001

42.62A

Pt. 67.14A

SPLIT

383.64

375.25

545.00

16-00-001-101

AUG 3 1994

20753

APPROVED
LORAIN CO.
MAP DEPT.
DATE 3-14-94
PAGE 16-00-001-A
BY CAROLYN
FRANCIS
VOID AFTER # 20753

16-00-002-101-

Comb.	
-001	15.62A
002	0.62A
Ac. Corr	16.24A
Grafton VILL.	16.56A

put in Break Line

Comb.

Pt -004

-001

15.62A

16.24A

Pt. 16.56A

3

COMB AC CORR.

1573.44

