

7.47 A.

-005
21.31 A.

104

16-00-002-101-003 14.79A
 -019-101-001 1.09A
 002-101-004 16.56A
 001-101-019 67.14A
 AC. CORR. PER ROUNDING 79.58A
 DEED 79.57A
 CALC 79.82A
 CURVE IN SPOT
 99.57A C=10,631,730.

AUG 5 1994
20753

APPROVED
 LORAIN CO.
 MAP DEPT.
 DATE 3-14-94
 PAGE 11-00-100 A
 BY CAROLYN
 FRANCIS
 VOID AFTER # 20753

2075
 APPROVED
 LORAIN CO.
 MAP DEPT.
 DATE 3-14-94
 PAGE 11-00-100
 BY CAROLYN
 FRANCIS
 VOID AFTER # 2075

PARSONS

11-00-100-

AC. CORR. PER CALC BY
 GARY PENFOUND REG SURVEYOR
 PT. 16-00-001-101-020

SEE 16-00-001-A


Pt. 16-00-001-101-019
 Pt. 67.14A

563.63

Pt. 3.59A 7.10A
 Pt.

AC CORR. PER
 Gary Penfound
 Reg. Surveyor

1536.24

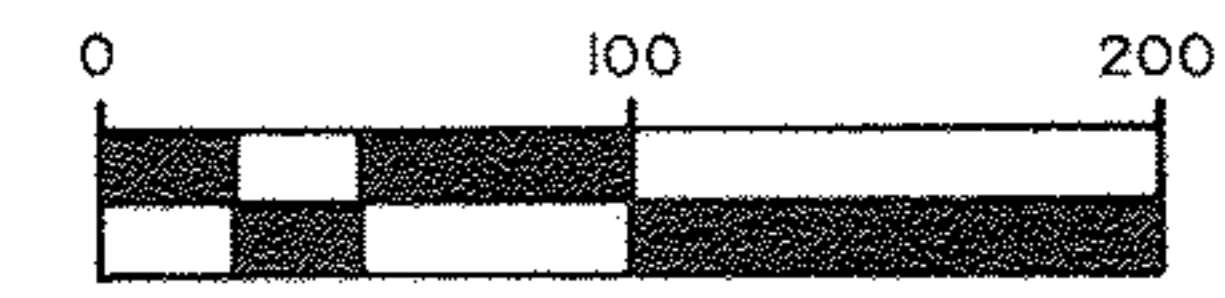

EATON TWP

SCALE 1" = 100'

3/8/94

11-00-100-A

W. PT. LOT 100