

2076


APPROVED  
LORAIN CO.  
MAP DEPT.  
DATE 9-4-68  
7-00-046-B  
BY *Bohler*

10/6/68 R.K.

114-816 8.8

SEE 7-00-045-A

1082.36

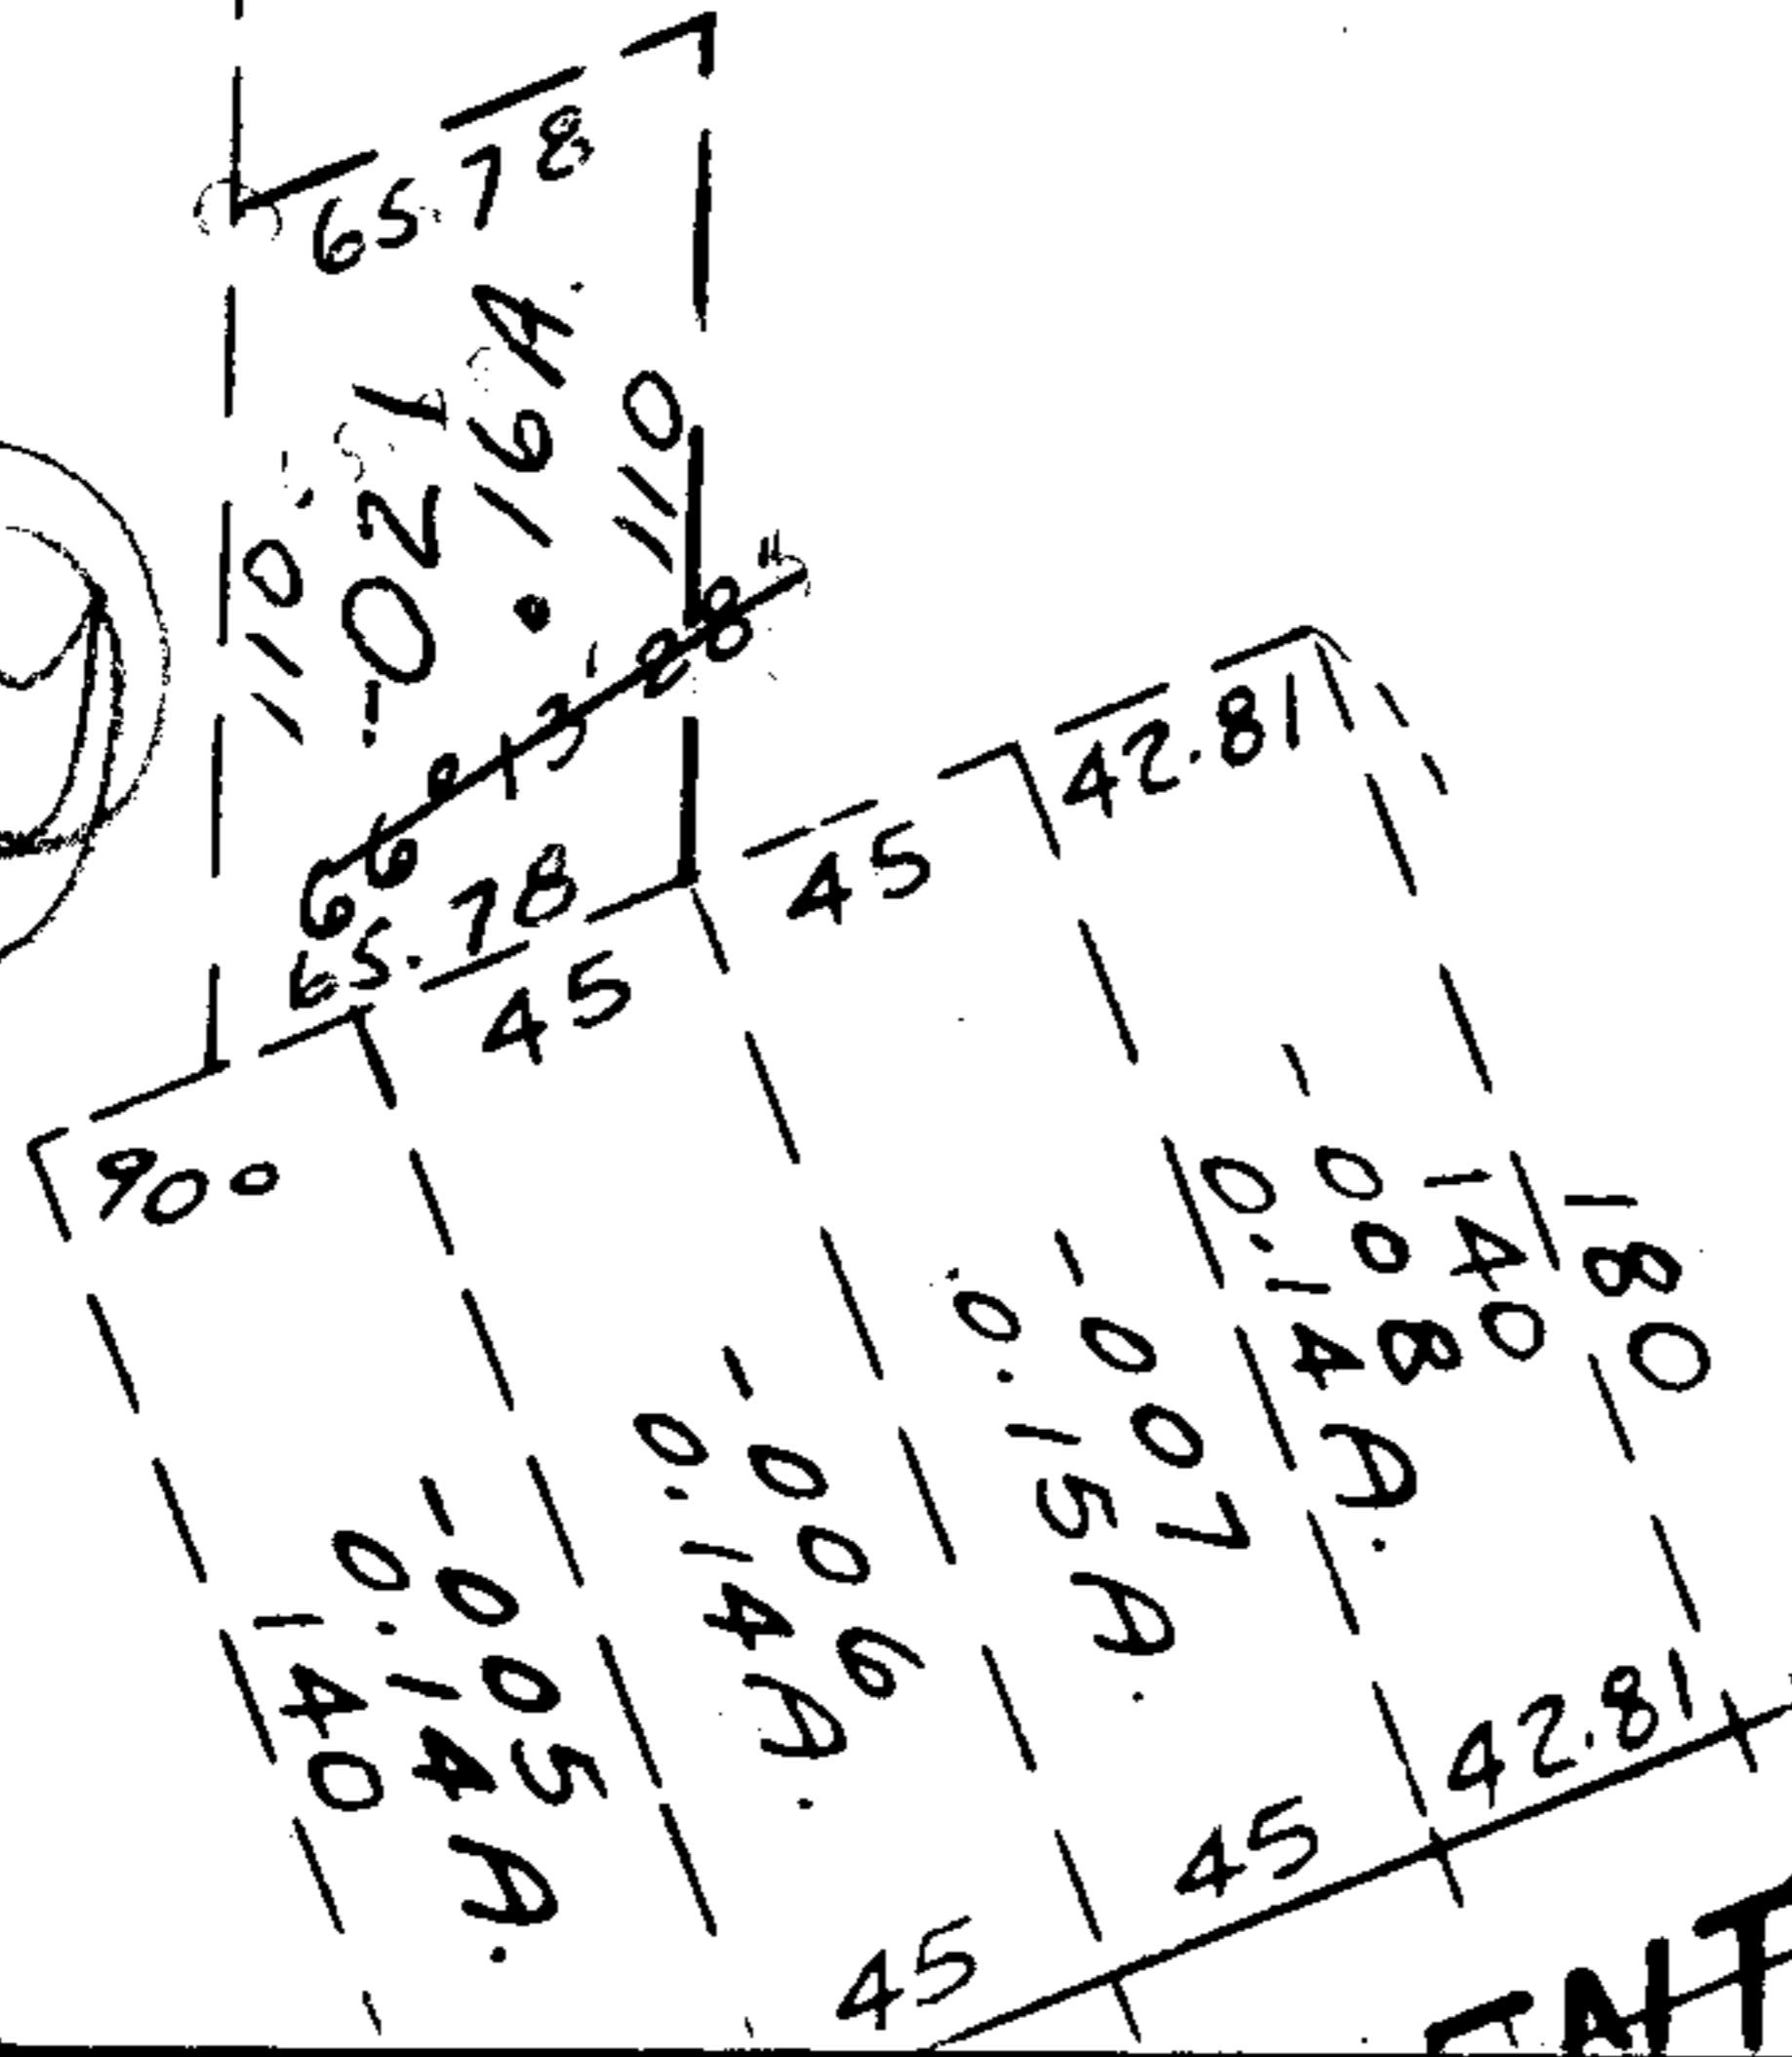

~~004~~  
8.84A

-022  
8.68A

118.76

253

300

88

90°

-011  
0.81A

109°37'

239.70

818.76

565.76

238

106

-010  
2.69A

-009  
4.71A

ENTER RIDGE