

SEE

SEE

CHECK IF ON FARM BILL

-014 14.72 A. WAS CREATED 1-17-89 BY COMBINATION AUTHORIZED BY DALE RUNDLE, OWNER SIGNATURE ON TRANSFER SHEET. SEE # 18285-A. IT IS BEING UNCOMBINED AT OWNERS

REQUEST DUE TO MORTGAGE ONLY COVERING PART OF PARCEL.

FORMERLY -010 & -014 COMB. PRIOR INST. REF. DV 1048, AG. 42

THIS ACREAGE CORRECTION DUE TO SUBTRACTION ERROR ON PRIOR UNCOMBINATION # 20402-A FILED 7/7/93

74
-012
140.52


ACREAGE CORRECTION DUE TO SUBTRACTION ERROR ON PRIOR UNCOMBINATION

AUG 5 1994

[Signature]

#20767-A

APPROVED
LORAIN CO.
MAP DEPT.
DATE 3-16-94
PAGE 12-E
BY T. MORRIS
20767-A

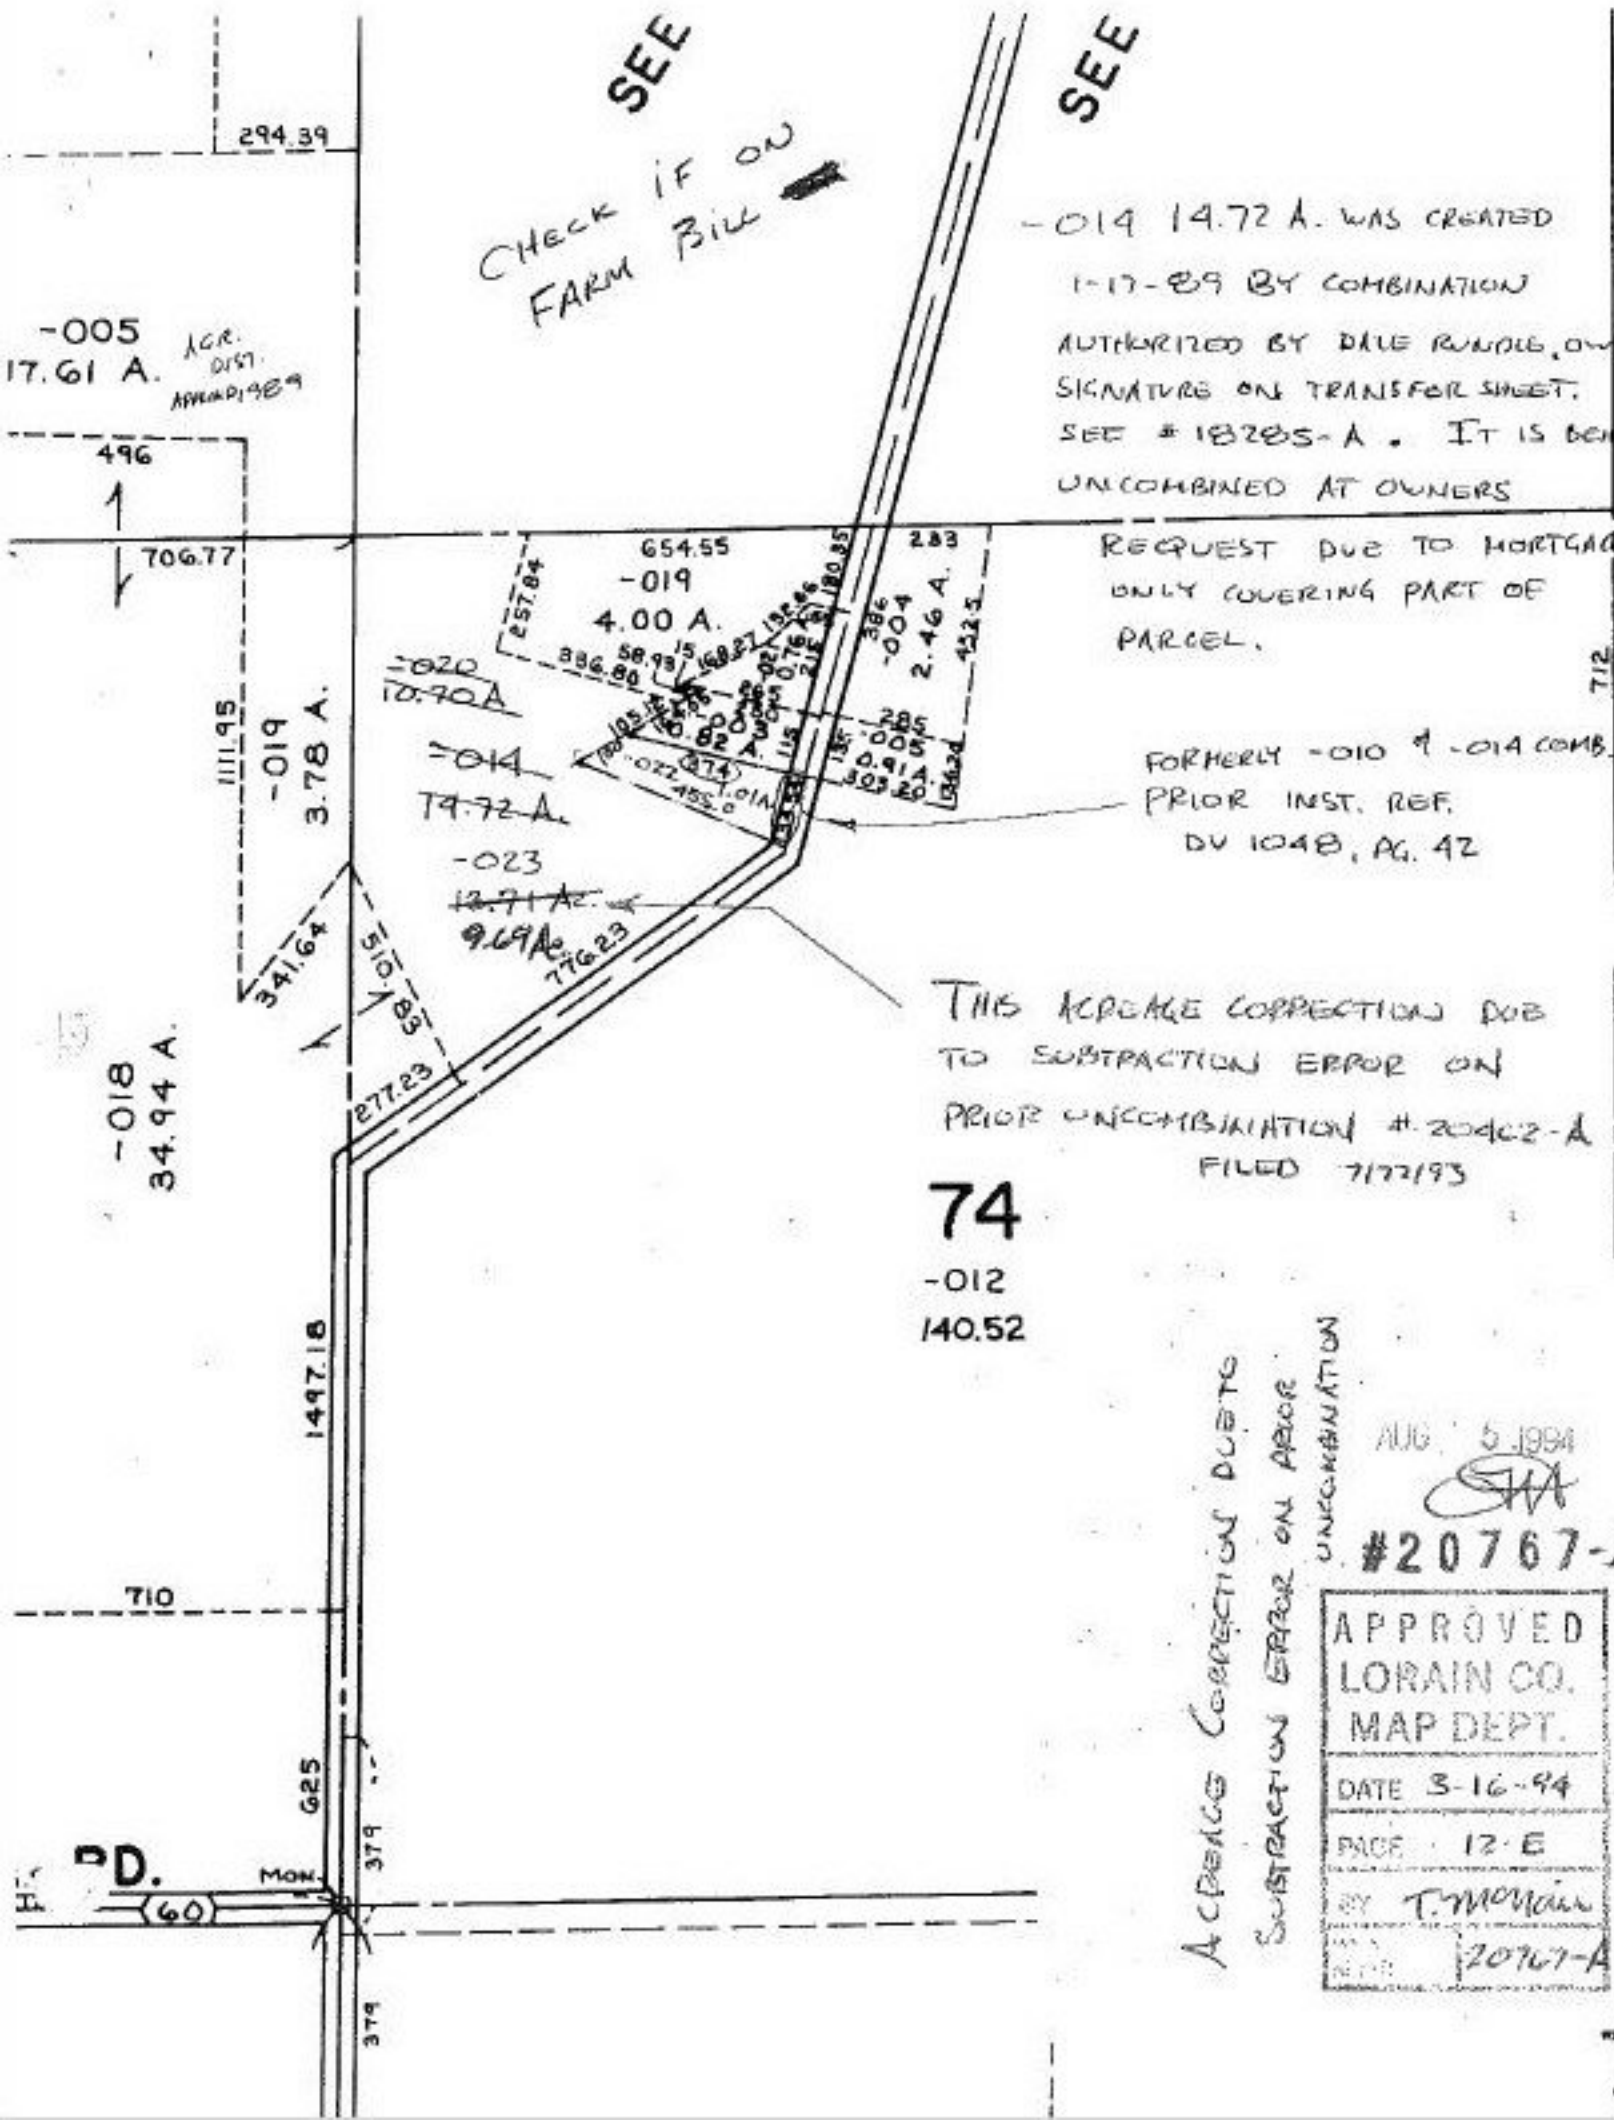

-005 17.61 A. AGR. DIST. APRIL 1989

496
↑
706.77
↓

111.95
-019
3.78 A.
341.64
510.85

-018
34.94 A.

654.55
-019
4.00 A.
257.84
886.80
58.98
15
168.27
134.46
216
180.85
283
386
-004
2.46 A.
432.5
285
-005
0.91 A.
303.20
183.24
115
138
105
122
100
102
104
1497.18

710

D.D.
(60)

MON.
379
379