



SEE 6-20

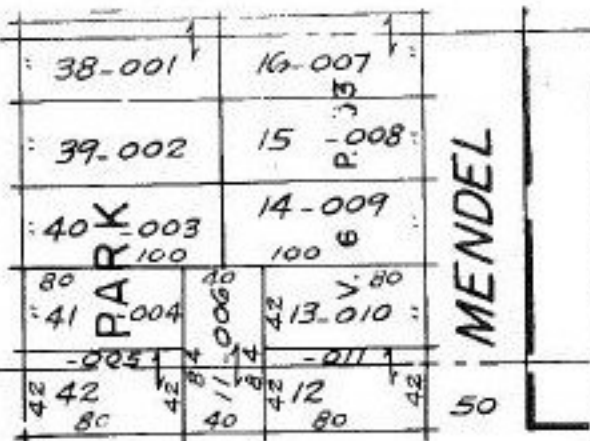

MENDEL

HILLSDALE

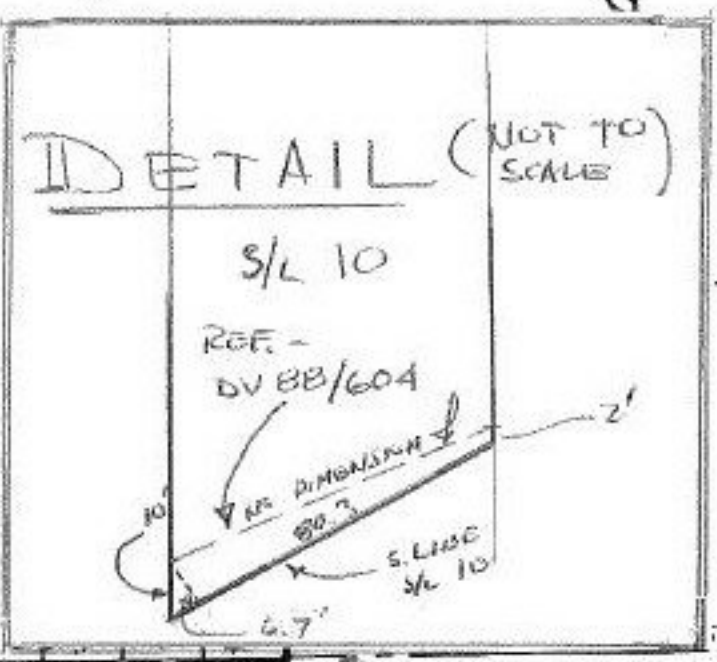


J. E. GRAY'S ADDN.

P.P. 100  
06-24-158-000-015  
DV: 1225/483

GLENDALE

CT.

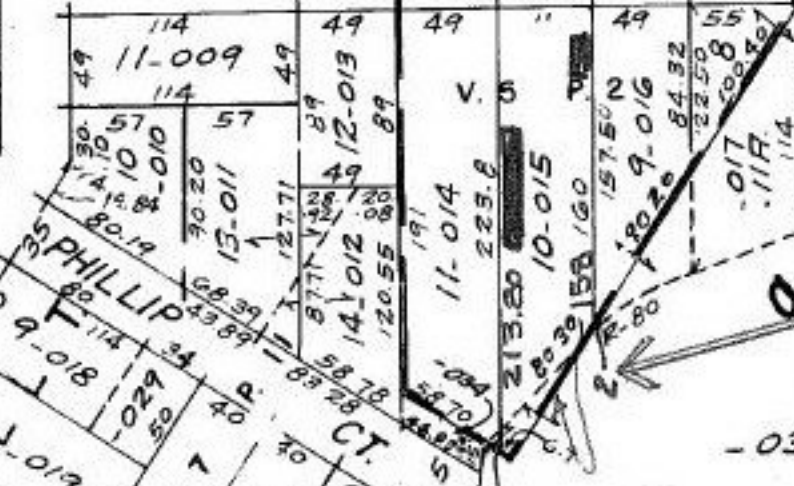

PHILLIP

CT.

158

Park

CHECK

CK 8/25/94  
# 20771-D

APPROVED  
LORAIN CO.  
MAP DEPT.  
DATE 5-12-94  
PAGE 6 of 10  
CAROLYN  
FRANCIS  
WORD  
METER # 20771

MAP CORR.