


SF 9-00-087-B

OBERLIN RD

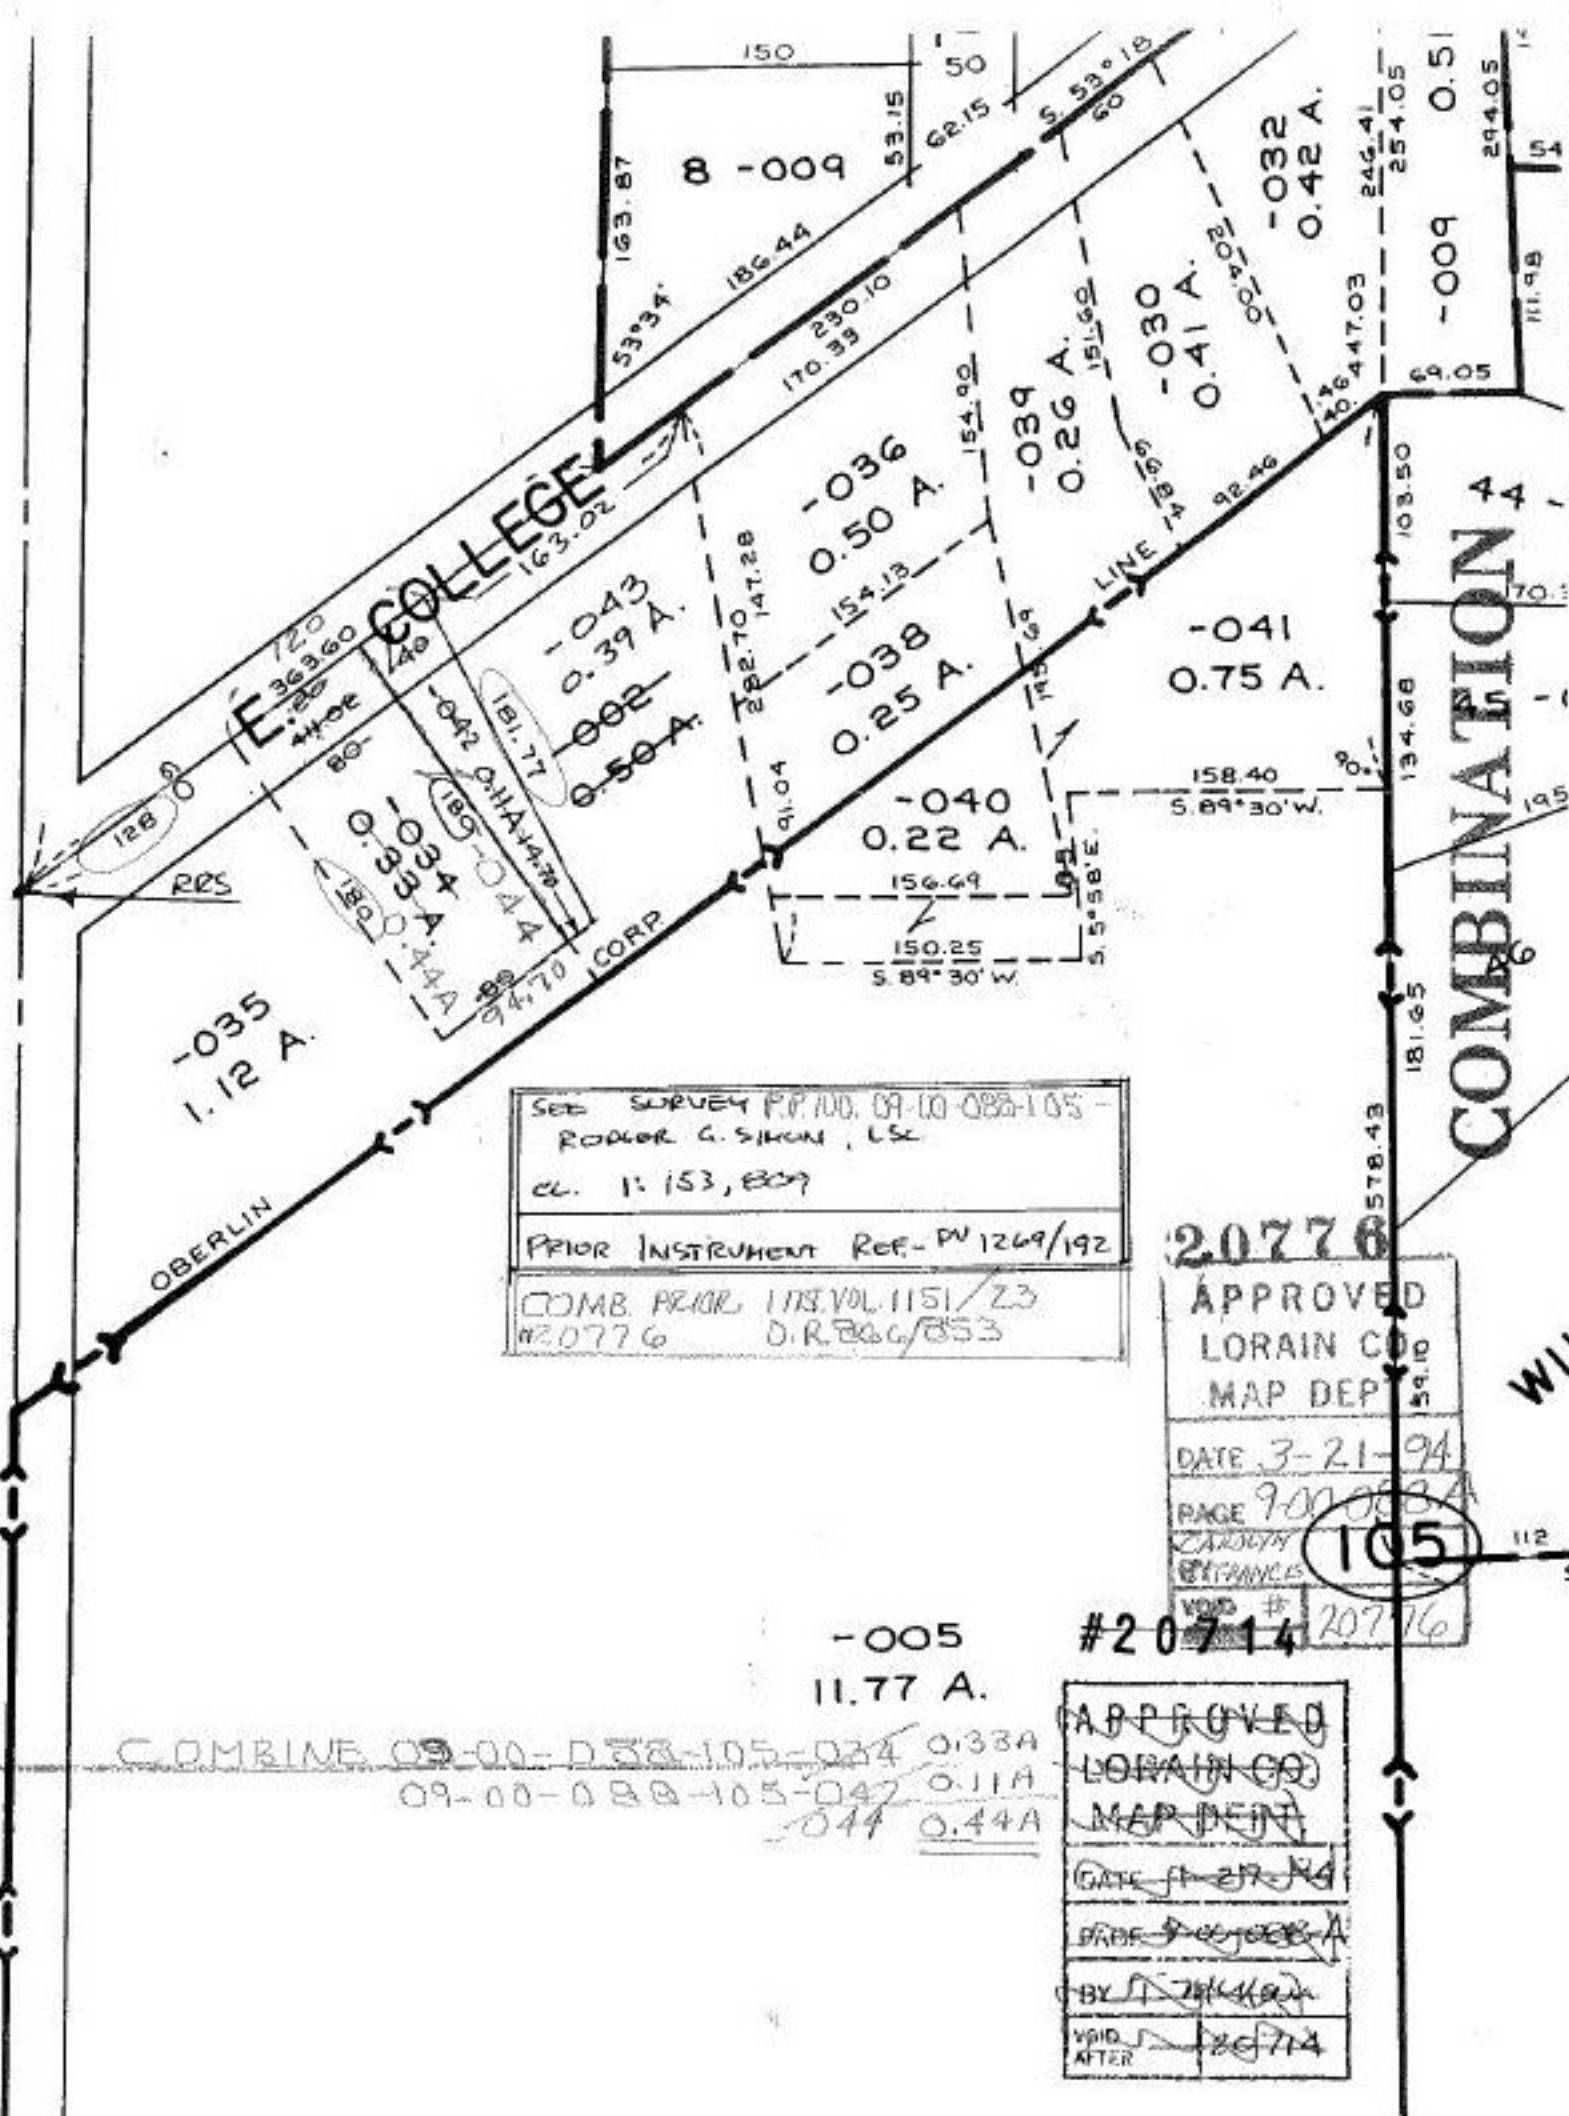

SEE SURVEY P.P. 100, 09-10-088-105 -
 RODGER G. SIMON, L.S.
 CL. 1: 153, 809

PRIOR INSTRUMENT REF. - PV 1269/192

COMB. PRIOR 173, VOL. 1151/23
 #20776 D.R. 886/853

20776

APPROVED
 LORAIN CO
 MAP DEPT

DATE 3-21-94

PAGE 901083A

BY CAROLYN
 BECKMAN

VOID # 105

VOID # 20776

APPROVED
 LORAIN CO
 MAP DEPT

GATE # 27-14

DATE 3-21-94

BY CAROLYN
 BECKMAN

VOID AFTER 20776

COMBINE 09-00-D38-105-034 0.33A
 09-00-088-105-047 0.11A
 044 0.44A

COMBINATION 4

W1

112