


20480

9.84 A
.29 A
9.55 A
.29 A
9.26 A

TWP. VILLAGE

2496.69

④

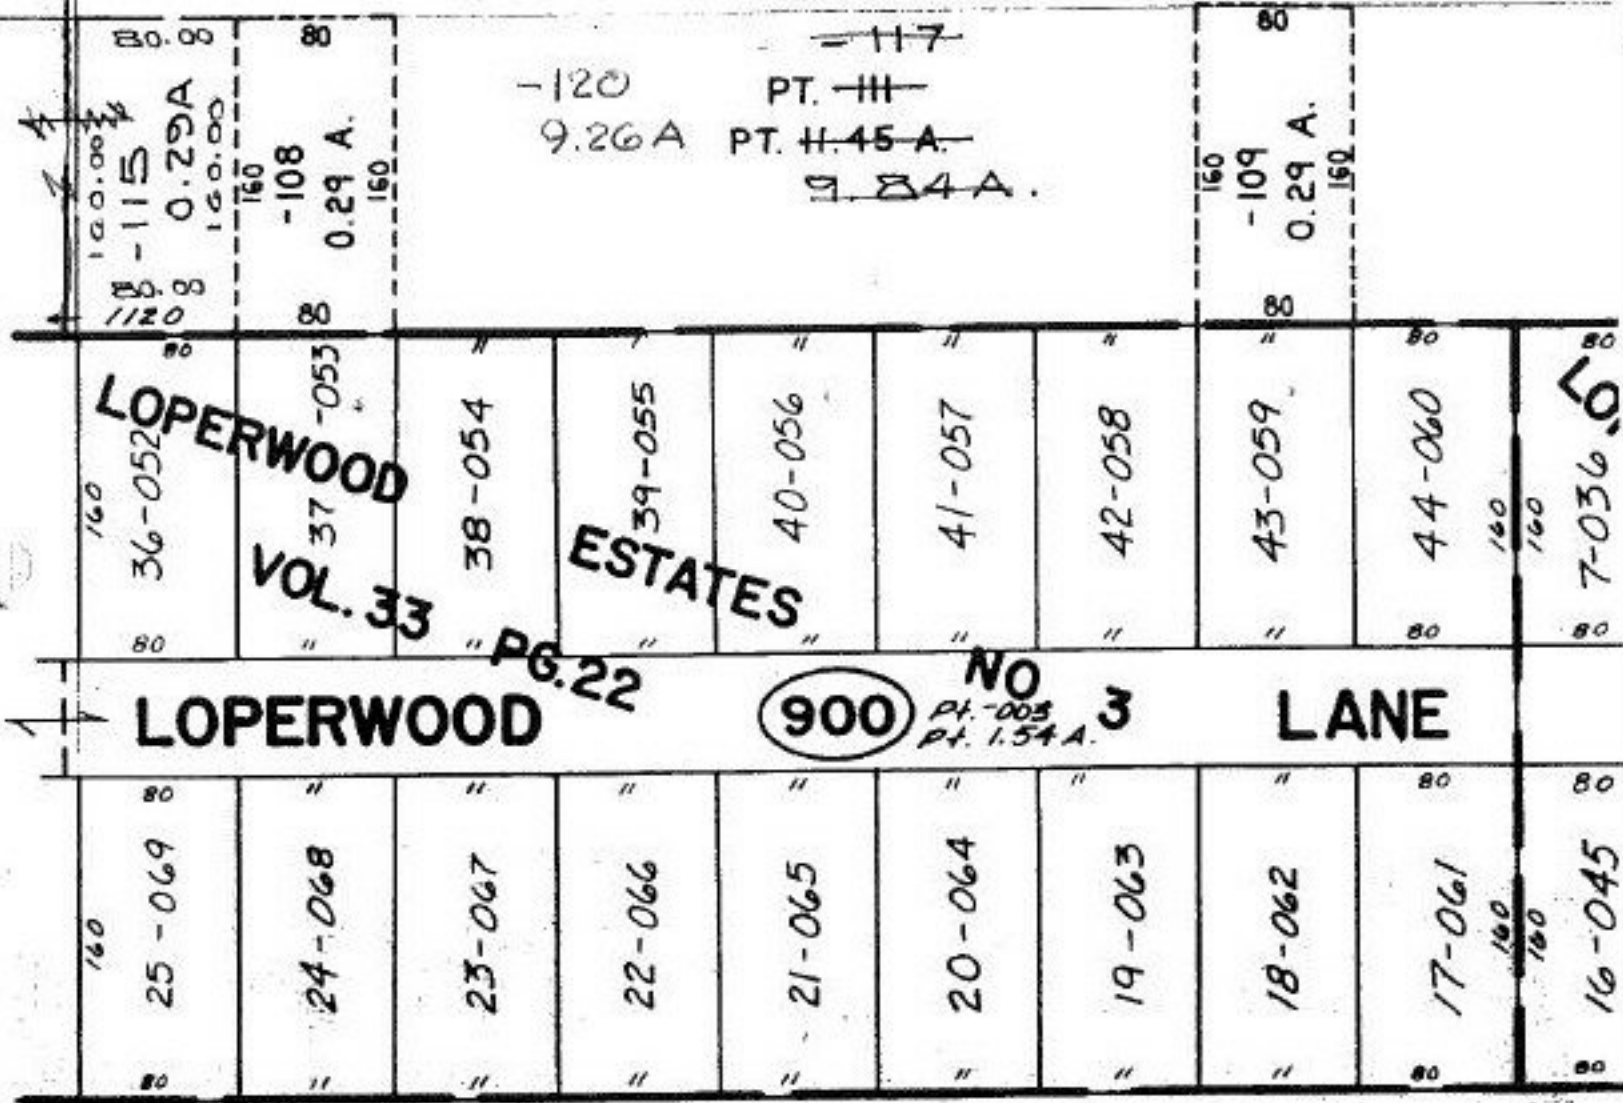

-117  
-120  
9.26 A PT. H. 45 A.  
9.84 A.

**LOPERWOOD**  
VOL. 33

**ESTATES**


**LOPERWOOD**

**900**

NO 3  
Pt. 003  
Pt. 1.54 A.

**LANE**

P.P. NO. 15-00-036-000-  
PRIOR INST: DV. 1177/742

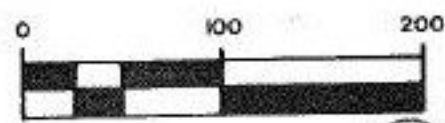

NIG 2 1994

SEE 15-00-045

20777

20480

APPROVED  
LORAIN CO.  
MAP DEPT.  
DATE 3-22-94  
PAGE 15-00-036 B  
BY CAROLYN FRANCIS  
# 20777

APPROVED  
LORAIN CO.  
MAP DEPT.  
DATE 8-18-93  
PAGE 15-00-036 B  
BY CAROLYN FRANCIS  
VOID AFTER # 20480

2/2