


10.30 AC.
5.44 AC.
4.86 AC.

-019
4.63 A.

200

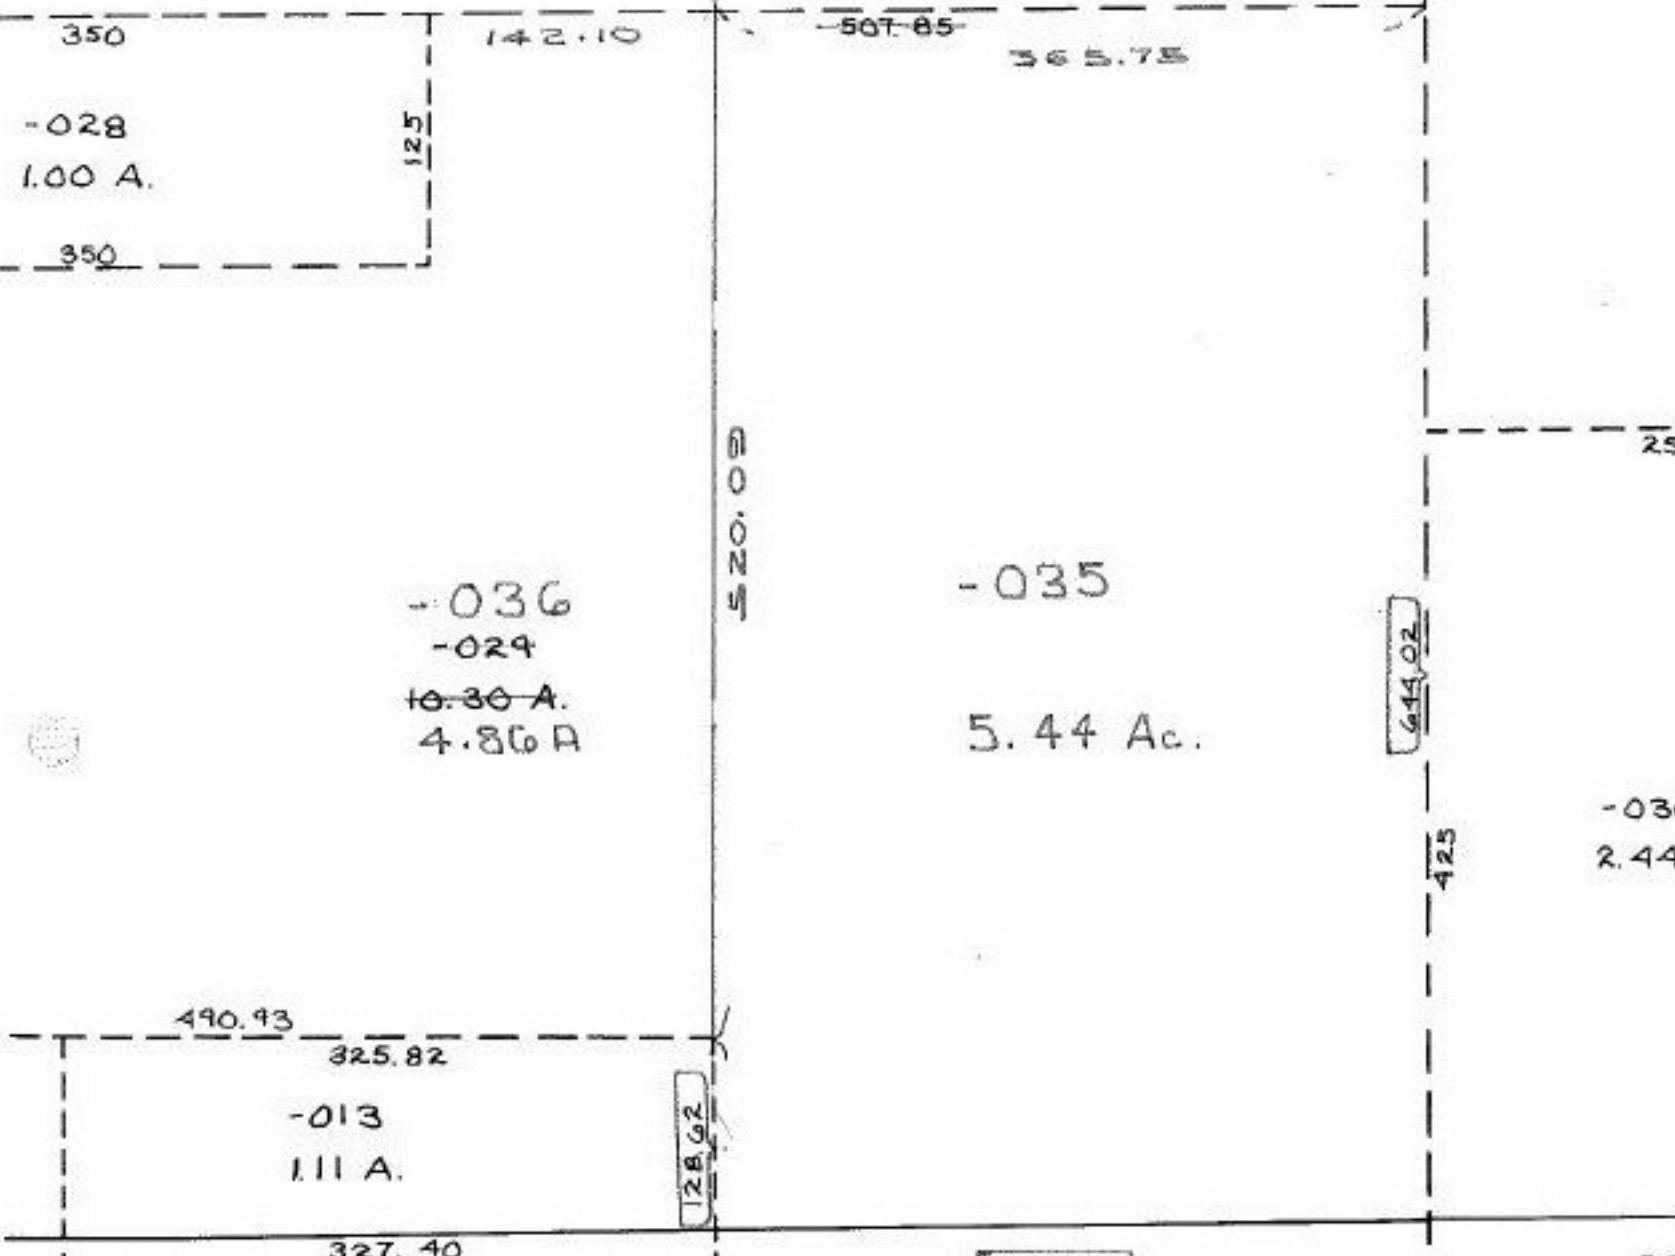

GRAFTON - EASTERN

492.40' FROM INTERSECTION CENTERLINES OF WOOSTER - AYON-LAKE RD AND GRAFTON EASTERN RD

P.P. NO. 16-00-015-000-
 PRIOR INST: O.R. 563/793
 CLOSURE: C=1:874,723
 SURVEYED BY: JOHN POZYWAK
 REG. SURVEYOR

SEE 16-00-026-A

AUG 3 1994

20791

APPROVED
LORAIN CO.
MAP DEPT.

DATE 4-4-94

PAGE 16-00-015A

CAROLYN
BY FRANCIS

VOID # 20791