


(LAGRAN

LAGRANGE RD.

TWP

VILLAGE

5-86-198
6-86

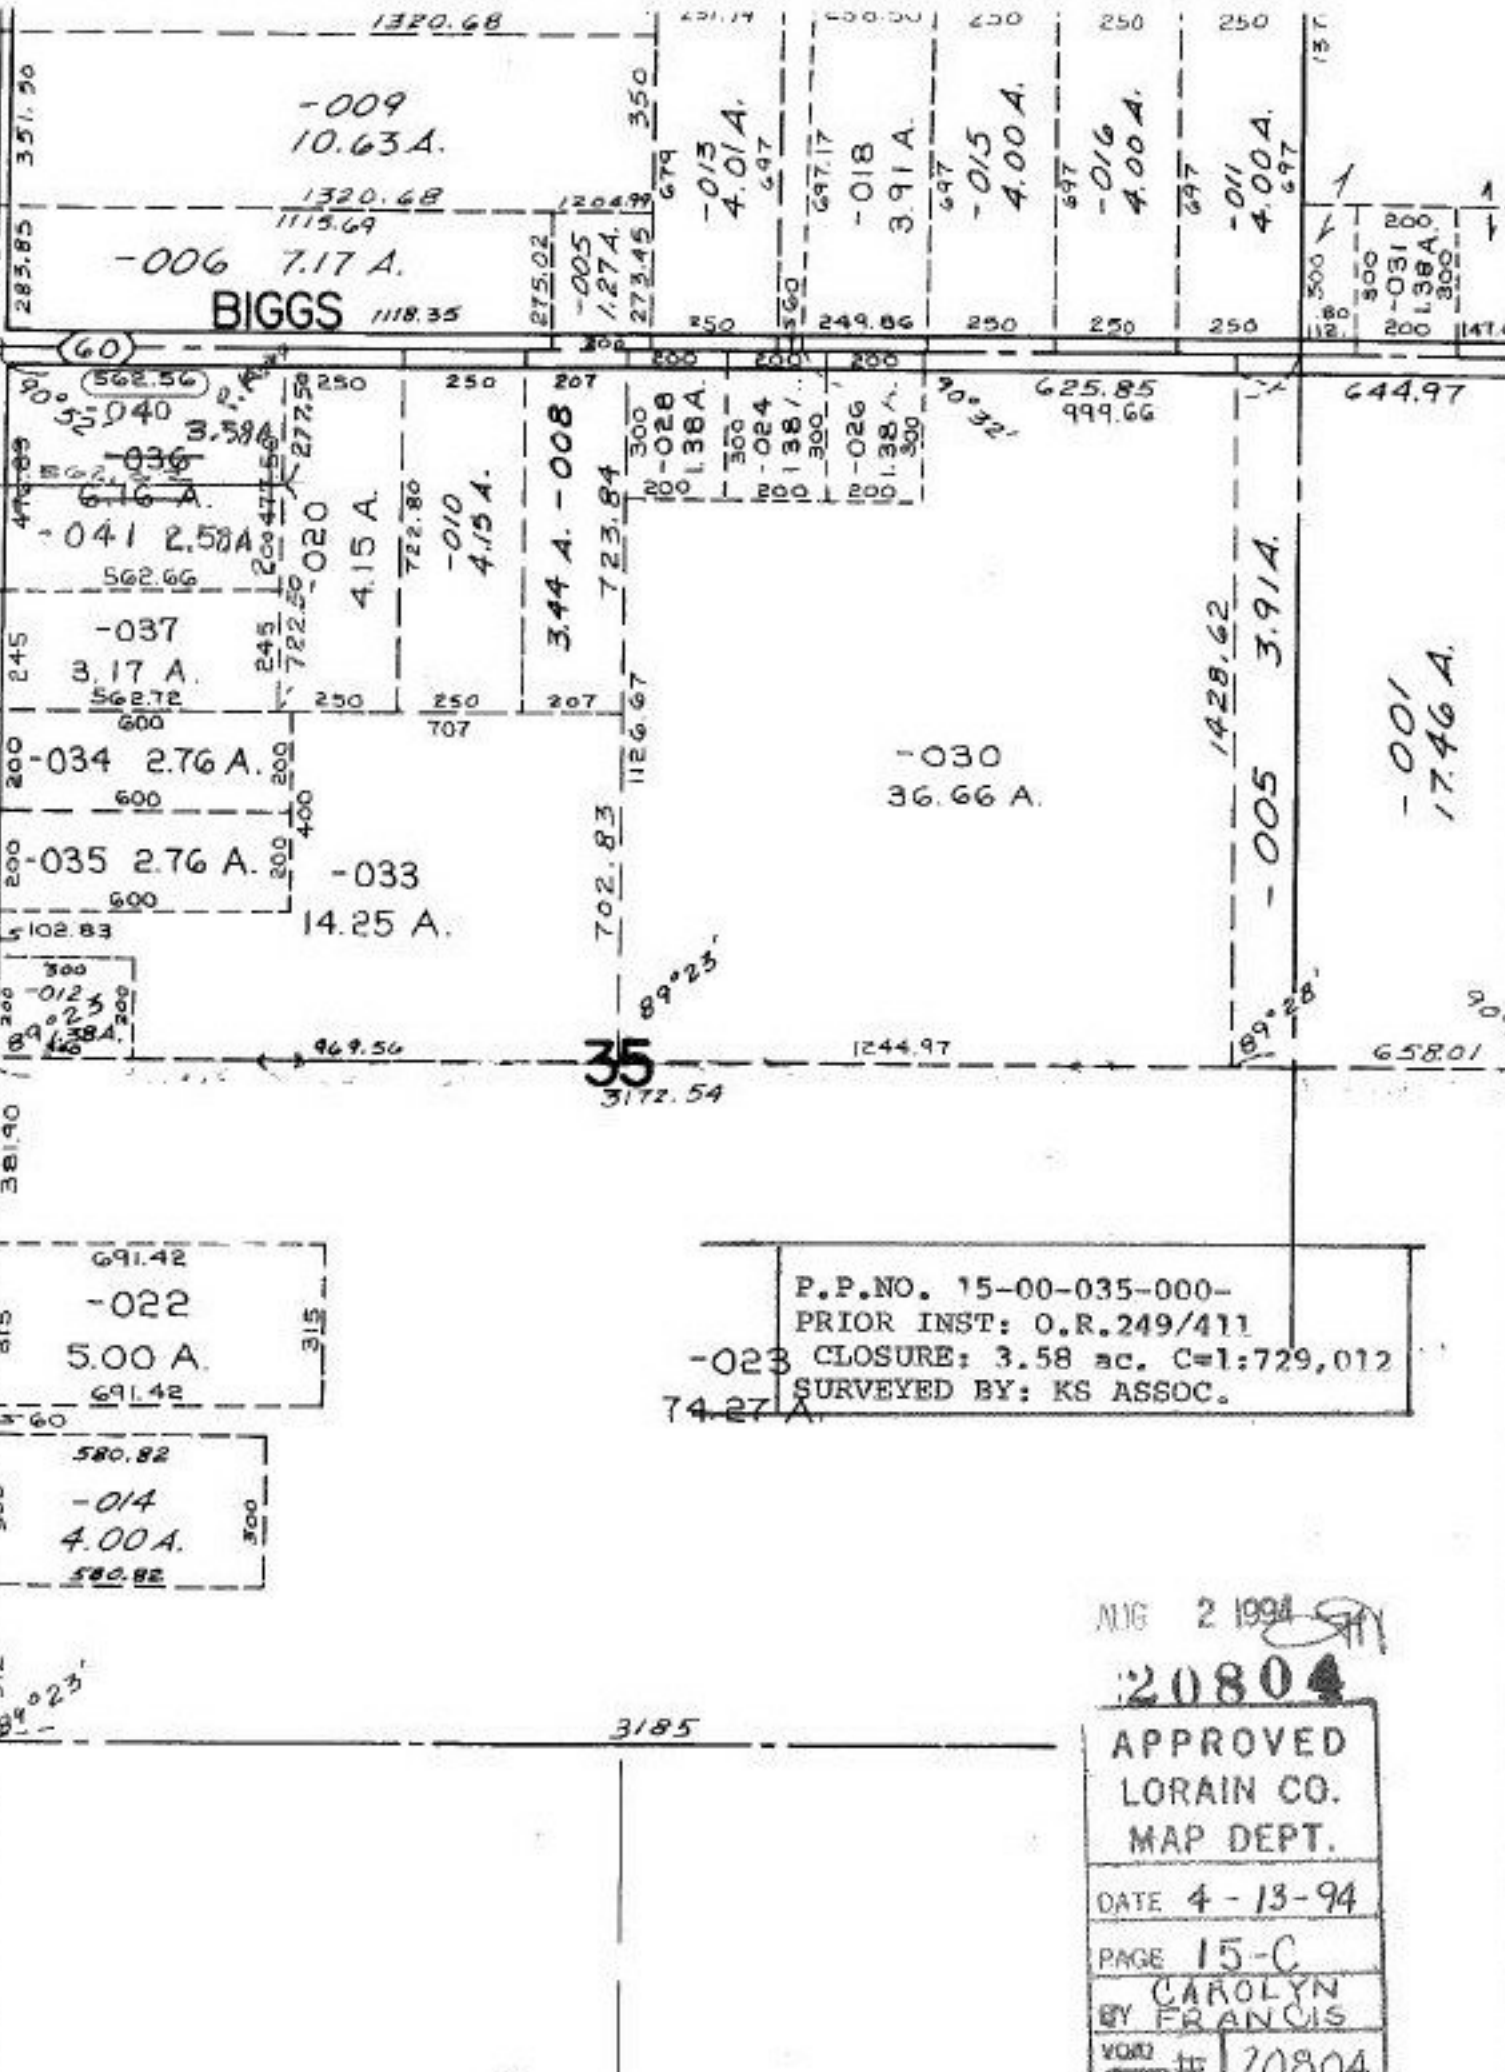

P.P.NO. 15-00-035-000-
 PRIOR INST: O.R.249/411
 -023 CLOSURE: 3.58 ac. C=1:729,012
 SURVEYED BY: KS ASSOC.
 74.27 A.

AUG 2 1994
 20804
 APPROVED
 LORAIN CO.
 MAP DEPT.
 DATE 4-13-94
 PAGE 15-C
 BY CAROLYN
 FRANCIS
 VOID # 20804