


# DEED CHECK

APPROVED  
 LORAIN CO.  
 MAP DEPT  
 DATE 7-22-94  
 PAGE 14  
 BY C.E. FRANCIS

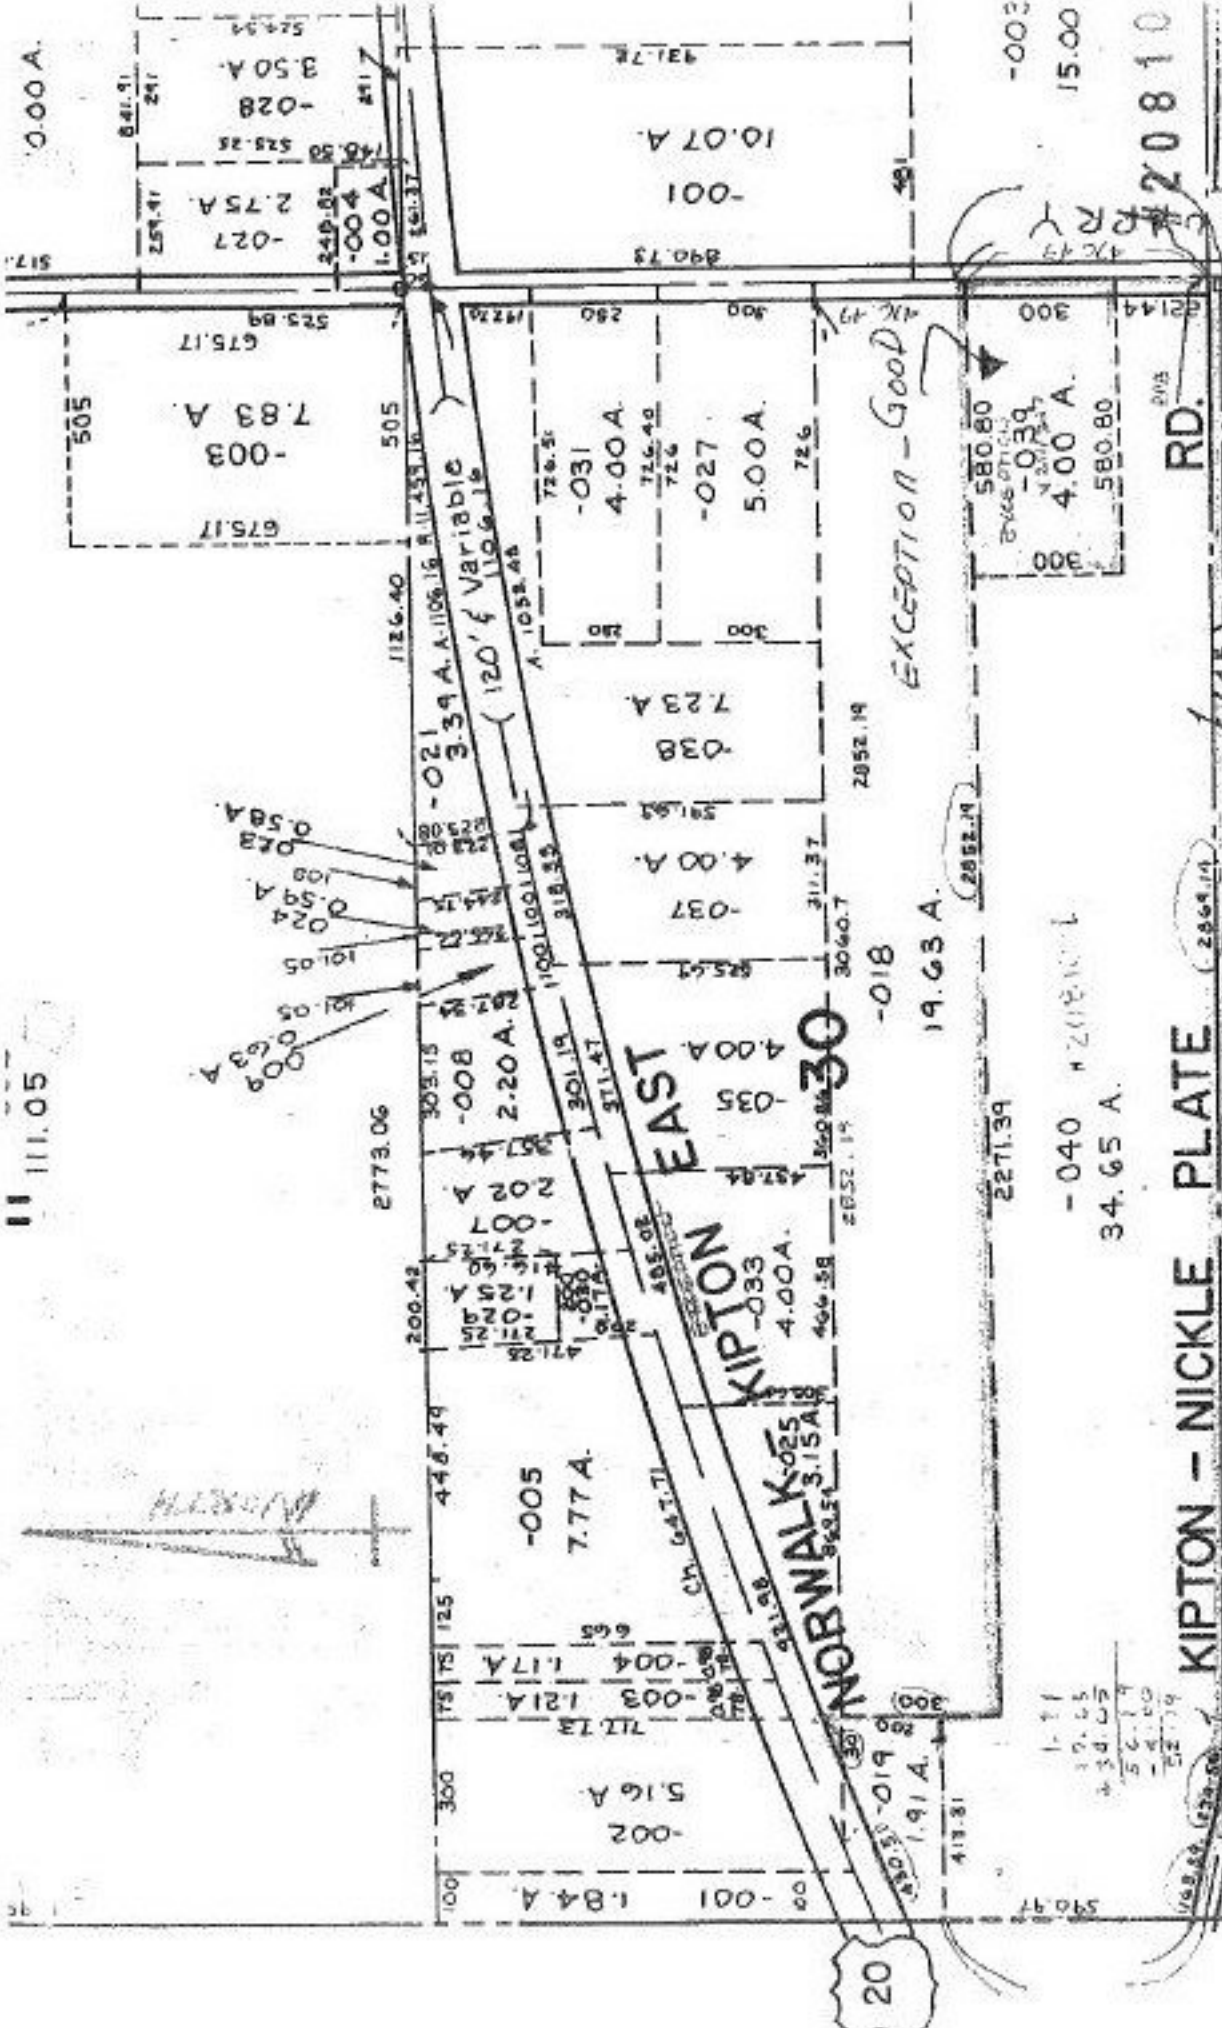

**DEED CHECK**

APPROVED  
 LORAIN CO.  
 MAP DEPT  
 DATE 7-22-94  
 PAGE 14-A  
 BY CAROLYN FRANCIS  
 # 20810-B

DEED CHECK LEGAL DESCRIPTION READS TO THE NORTH LINE OF  
 KIPTON-NICKLE PLATE ROAD. ACREAGE LISTED ON DEED  
 INCLUDES THE NORTH 1/2 VACATED KIPTON-NICKLE PLATE RD.  
 NORTH LINE OF R.N.P. RD IS THE SOUTH LINE OF O.R. NO. 10.  
 LEGAL NEEDS TO INCLUDE NORTH 1/2 VACATED  
 NICKLE-PLATE RD.  
 VAC. ST. IS LOCATED IN O.L. 31 ADD TO LEGAL.

14-00-0350-000-019, 040

#20810

RD.

KIPTON - NICKLE PLATE

VAC COMM. RES. 77-11

-040 + 20810  
 34.65 A.

EXCEPTION - GOOD

-018

19.63 A.

30

2271.39

2852.19

3060.7

311.47

318.33

326.51

330.19

335.14

580.80

0.39

4.00 A.

30

580.80

30

30

11 111.05

0.00A.

517.

505

675.17

7.83 A

-003

675.17

525.89

257.41

841.51

241

525.25

-028

3.50A

525.25

2.75A

-027

249.02

-004

1.00A

46.50

525.25

241

525.25

241

525.25

241

525.25

241

241