


2082

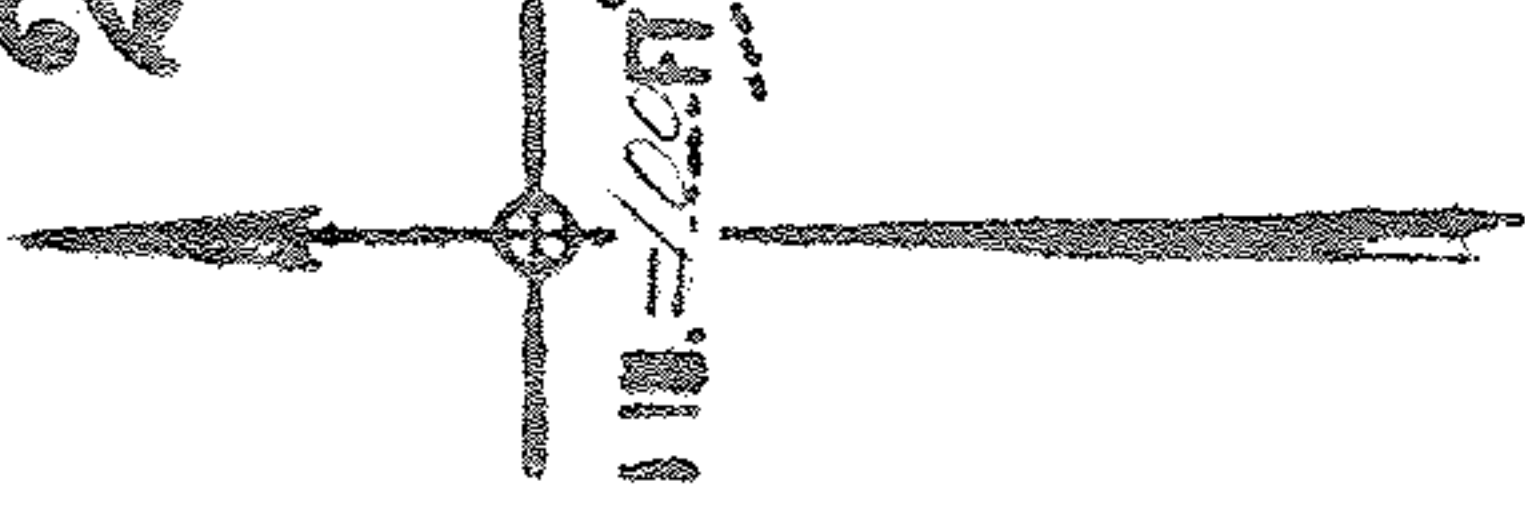

APPROVED
LORAIN CO.
MAP DEPT.
DATE 9-6-68
10-00-008A
BY <i>[Signature]</i>

[Signature] R.K. 11/7/68

100 91.57 83.25 83 0

AVE. 166.25 0

SEE 10-00-008-D

- 001
5.06A

1331.86
~~-004~~
~~-002~~
2.56A
~~2.022~~

~~5.06A~~
~~-025~~
~~003~~
2.56A

1331.19
1342.7

- 004
2.87A

- 005
3.09A

83.25 164.84 83

94.82

100

006