


SEE 4-00-004-F

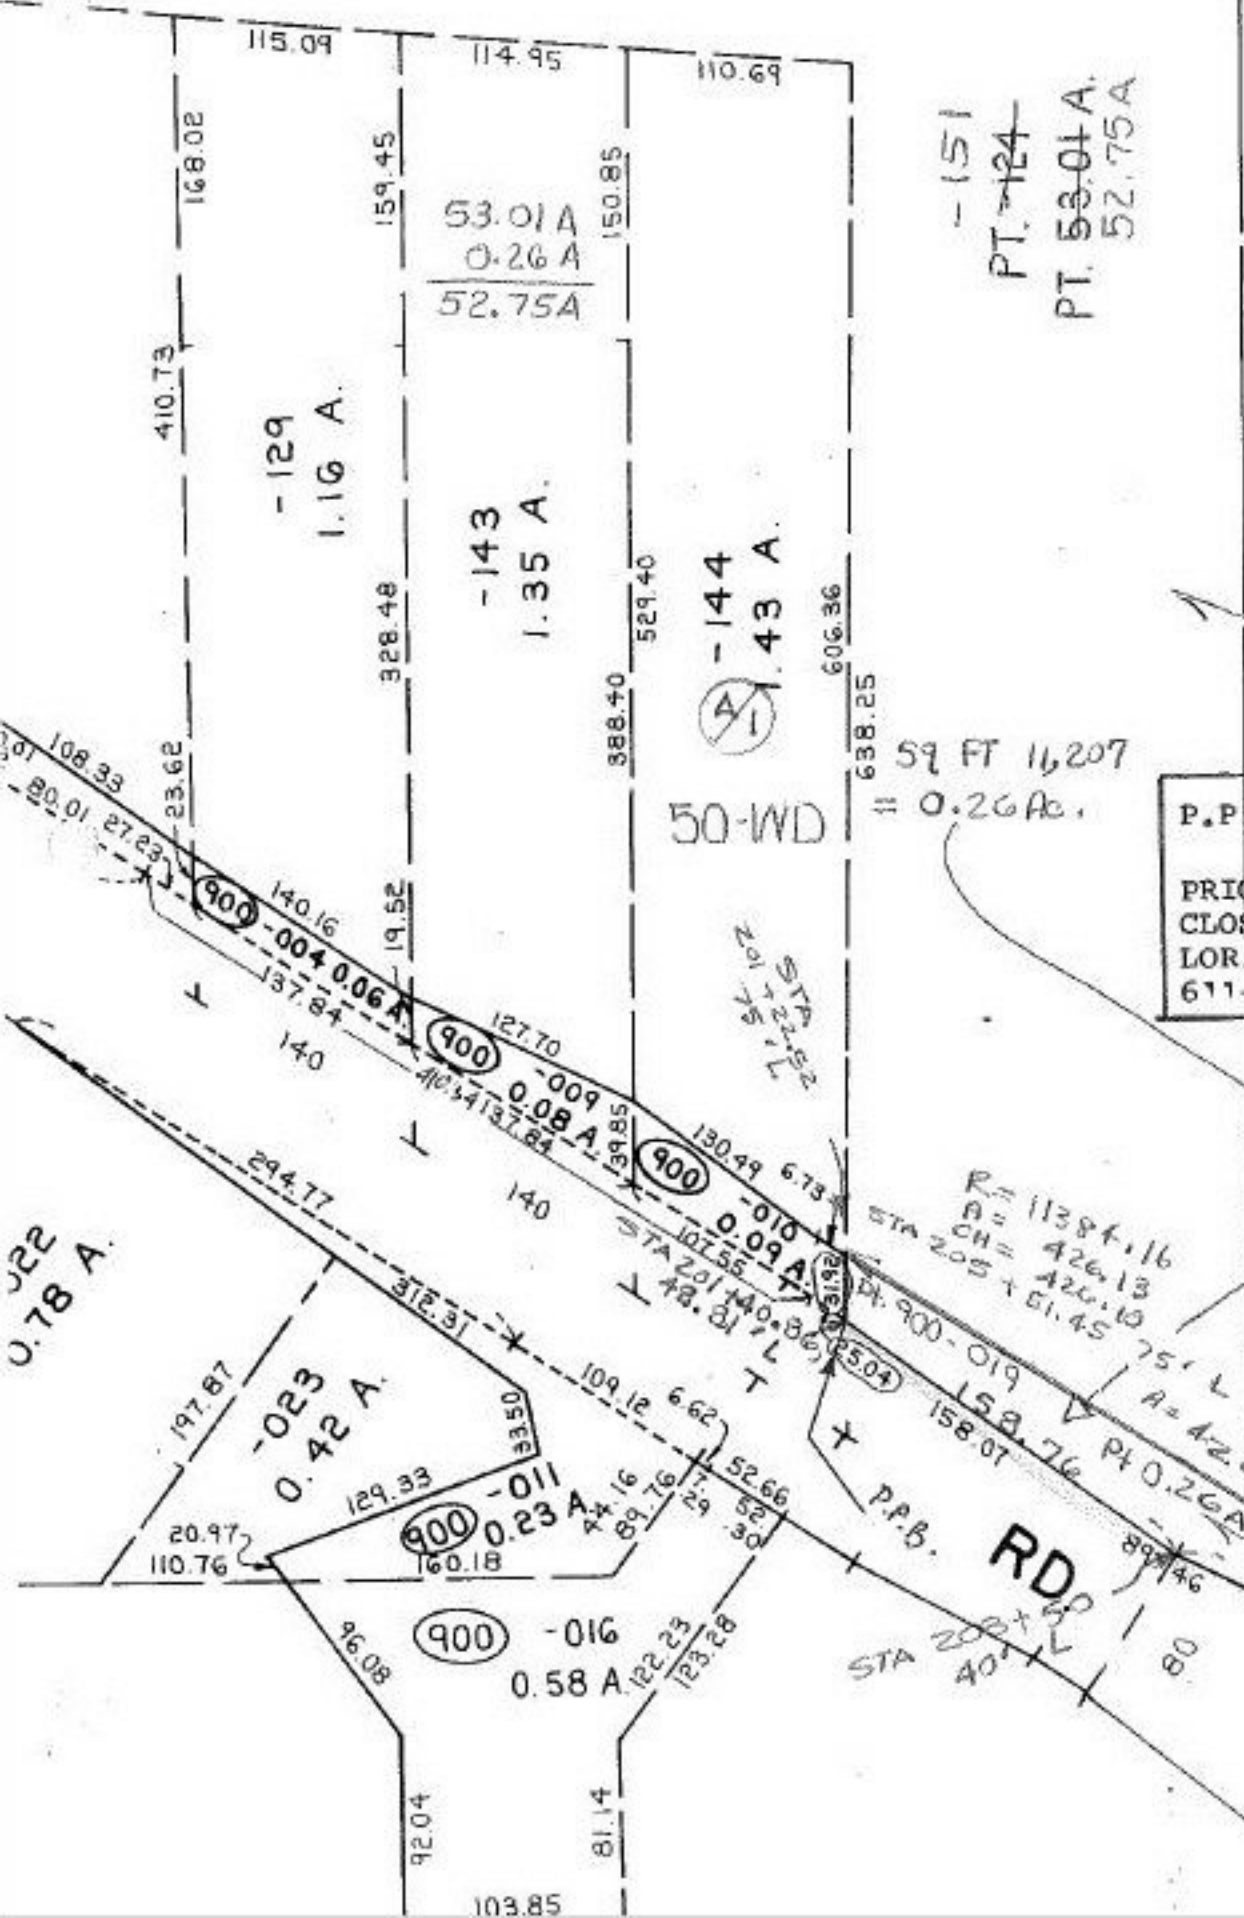

-151  
 PT. 124  
 PT. 53.01 A.  
 52.75 A

50-WD

59 FT 16,207  
 = 0.26 Ac.

P.P. NO. 04-00-004-900-  
 04-00-004-102-  
 PRIOR INST: DV.934/316  
 CLOSURE: C=1,160,000  
 LOR. CO. R/W PLANS  
 611-8.66 50-WD!

9-9-94  
 20826

APPROVED  
 LORAIN CO.  
 MAP DEPT.

DATE 5-4-94

PAGE 4-00-004-E

BY CAROLYN  
 FRANCIS

YOUR # 20826

R = 11384.16  
 A = 426.13  
 CH = 426.13  
 STA 205 + 51.45

P.P.B.  
 RD

STA 202 + 40