


SL 10-00-004-D

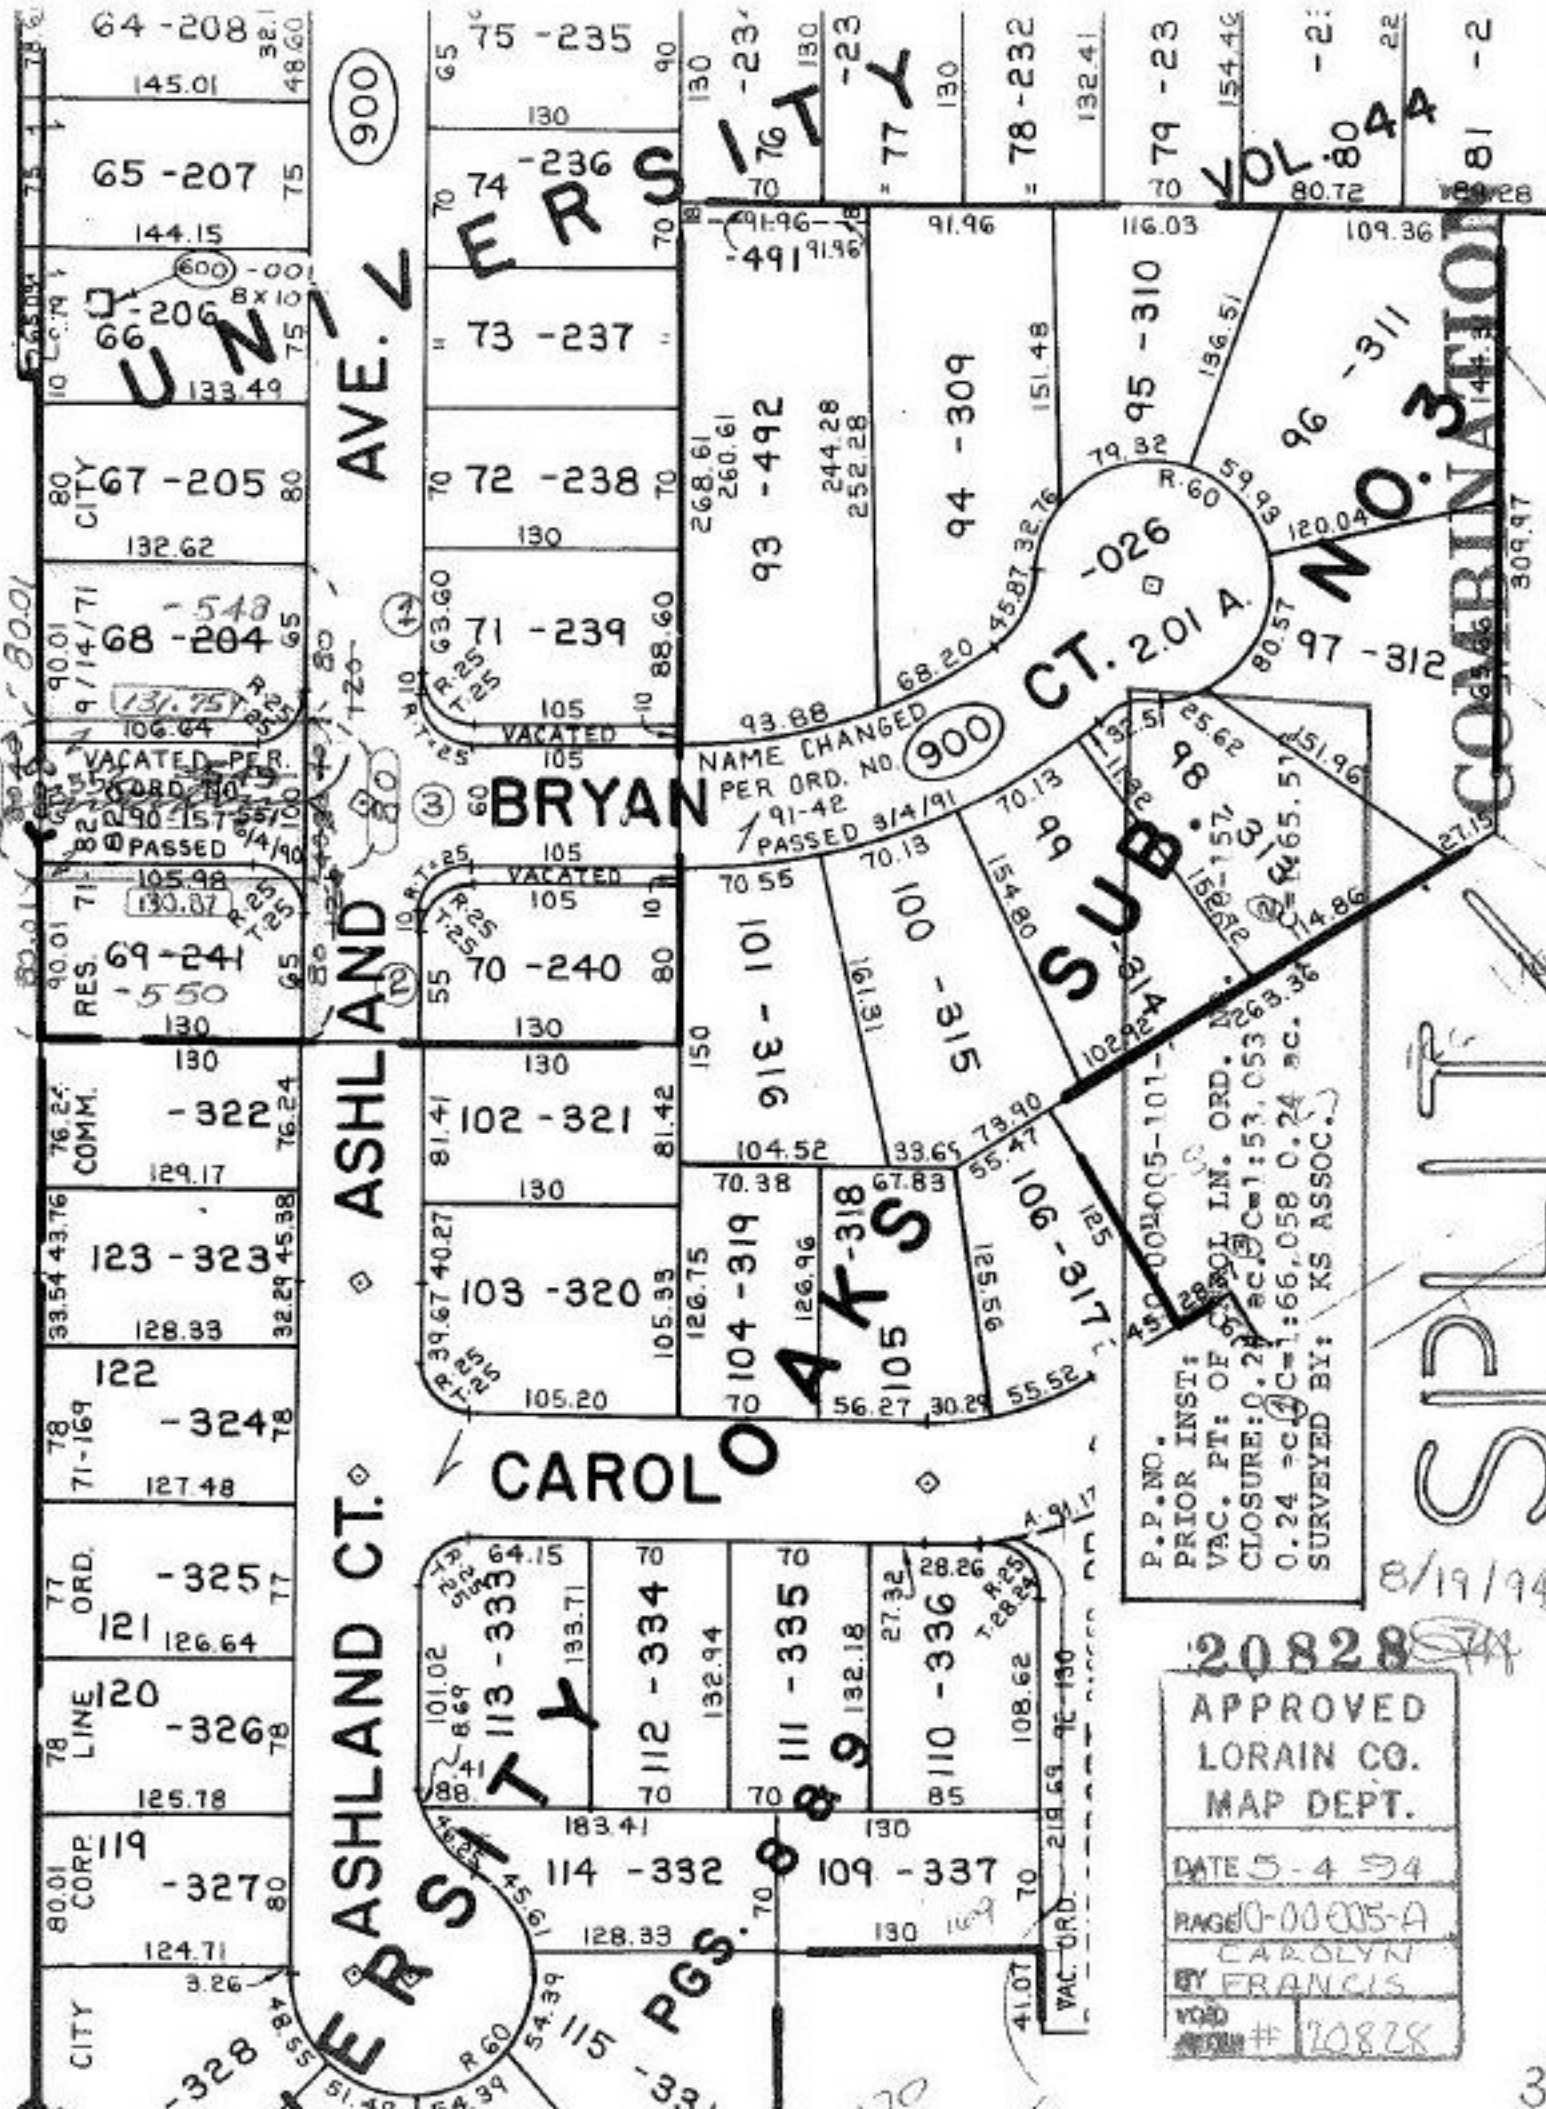

20828

APPROVED
LORAIN CO.
MAP DEPT.

DATE 5-4-54

PAGE 10-00-005-A

CAROLYN
BY FRANCIS

VOL # 20828

8/19/94