


1619.55  
**58**  
**OBERLIN - NORTH**

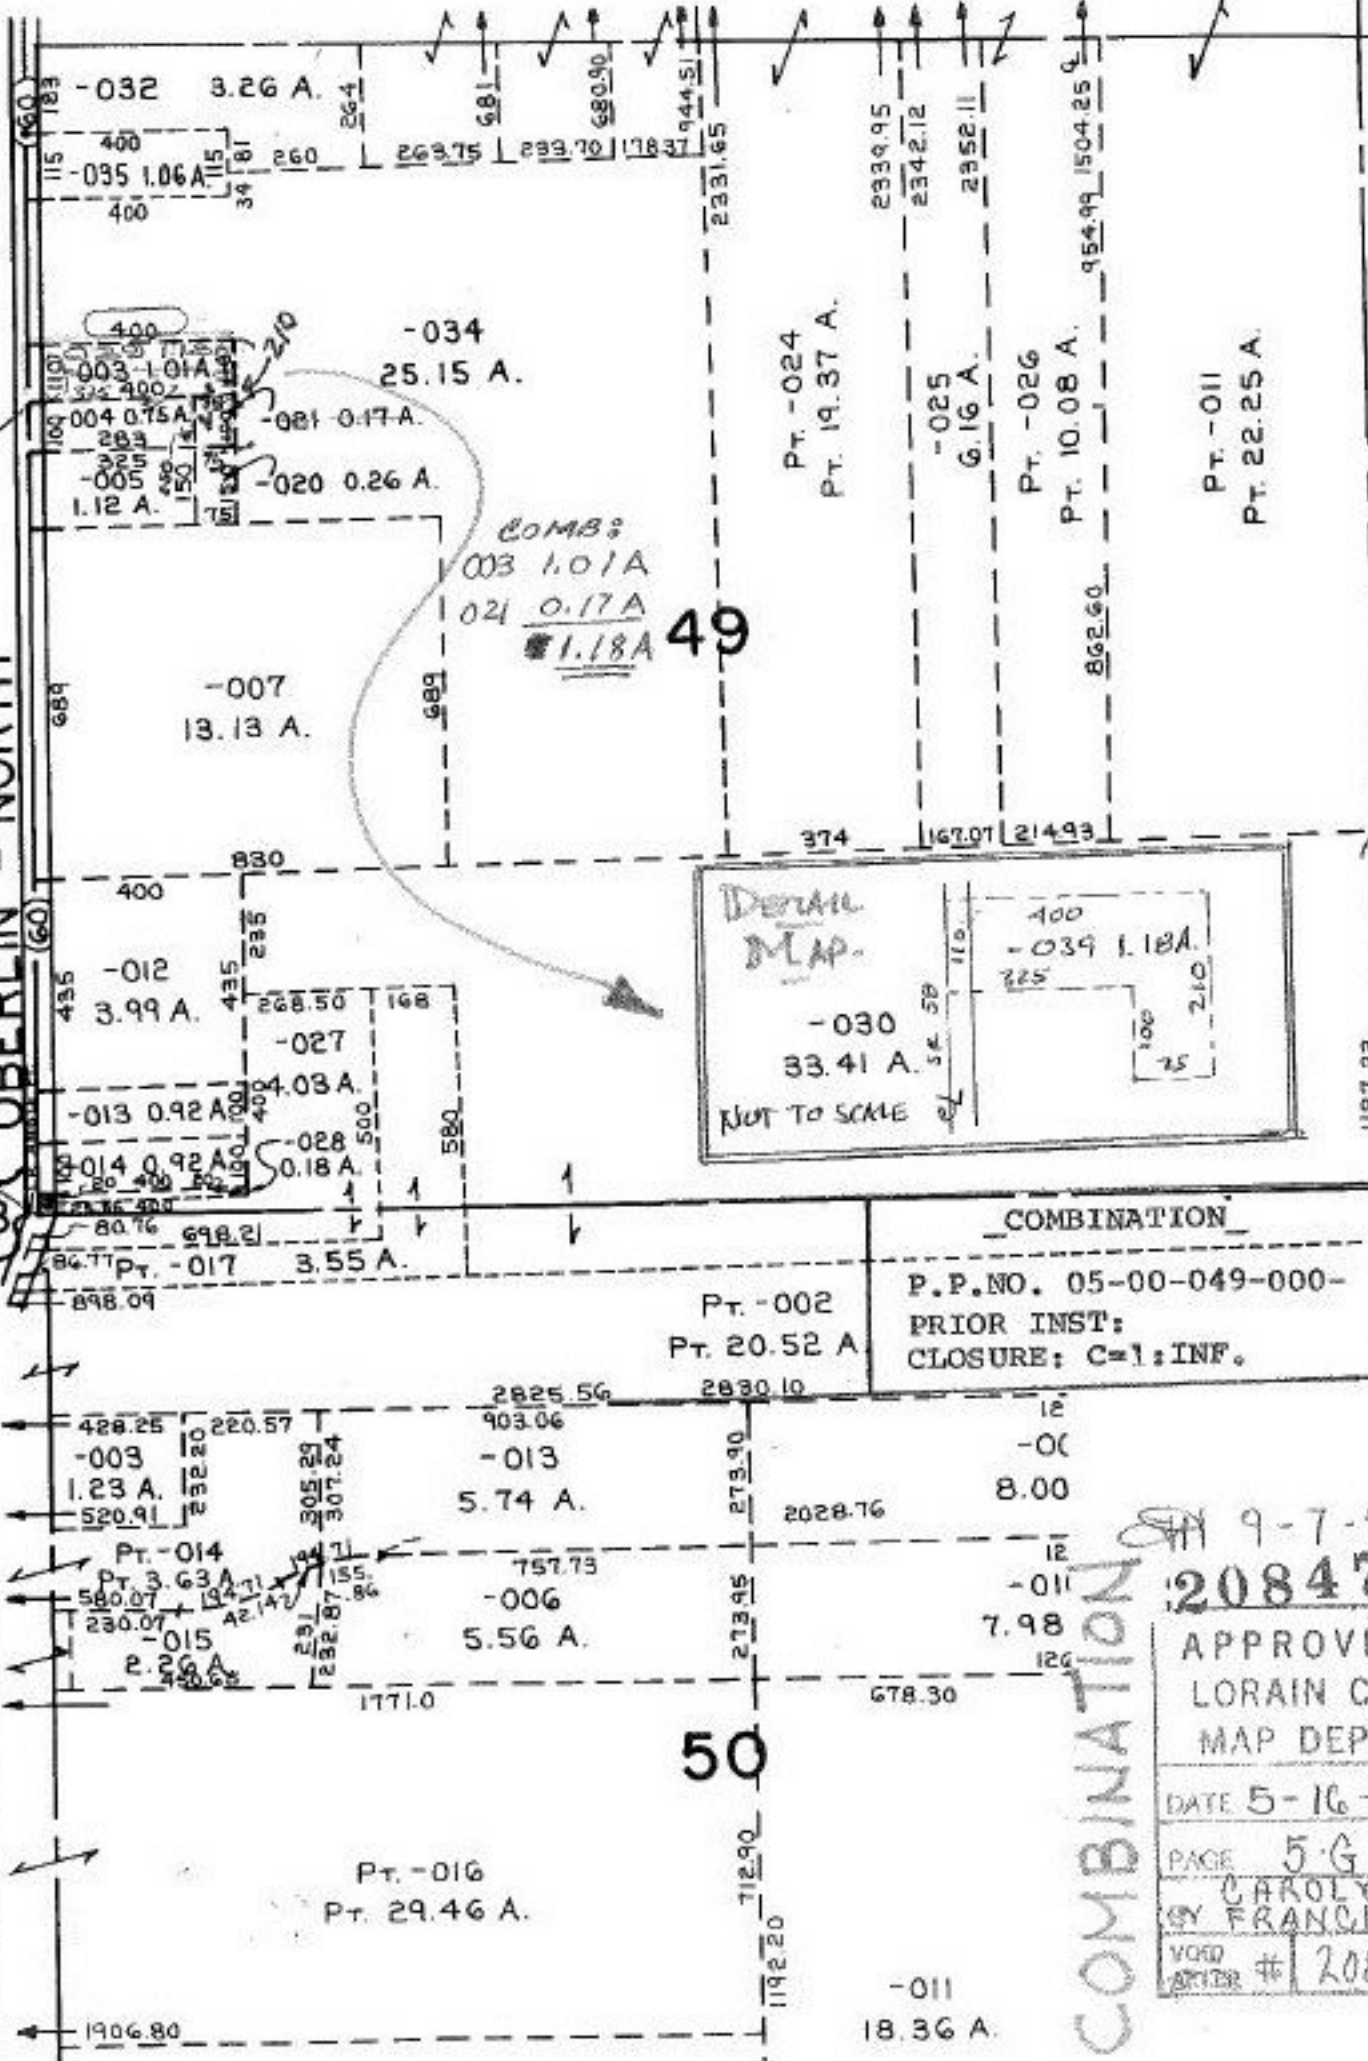

COMB:  
 003 1.01A  
 024 0.17A  
 #1.18A **49**

**DETAIL MAP**  
 -030  
 33.41 A.  
 NOT TO SCALE

**COMBINATION**  
 P.P. NO. 05-00-049-000-  
 PRIOR INST:  
 CLOSURE: C=1:INF.

(SEE DETAIL PAGE 5-00-031-B)

9-7-94  
**20847**  
 APPROVED  
 LORAIN CO.  
 MAP DEPT.  
 DATE 5-16-94  
 PAGE 5-G  
 BY CAROLYN FRANCIS  
 V060 # 20847

**50**

**COMBINATION**