


20858

Copyright 1963  
REV. 4/4/88

4-00-024-H

E 1/2 SE 1/4 SEC. 24

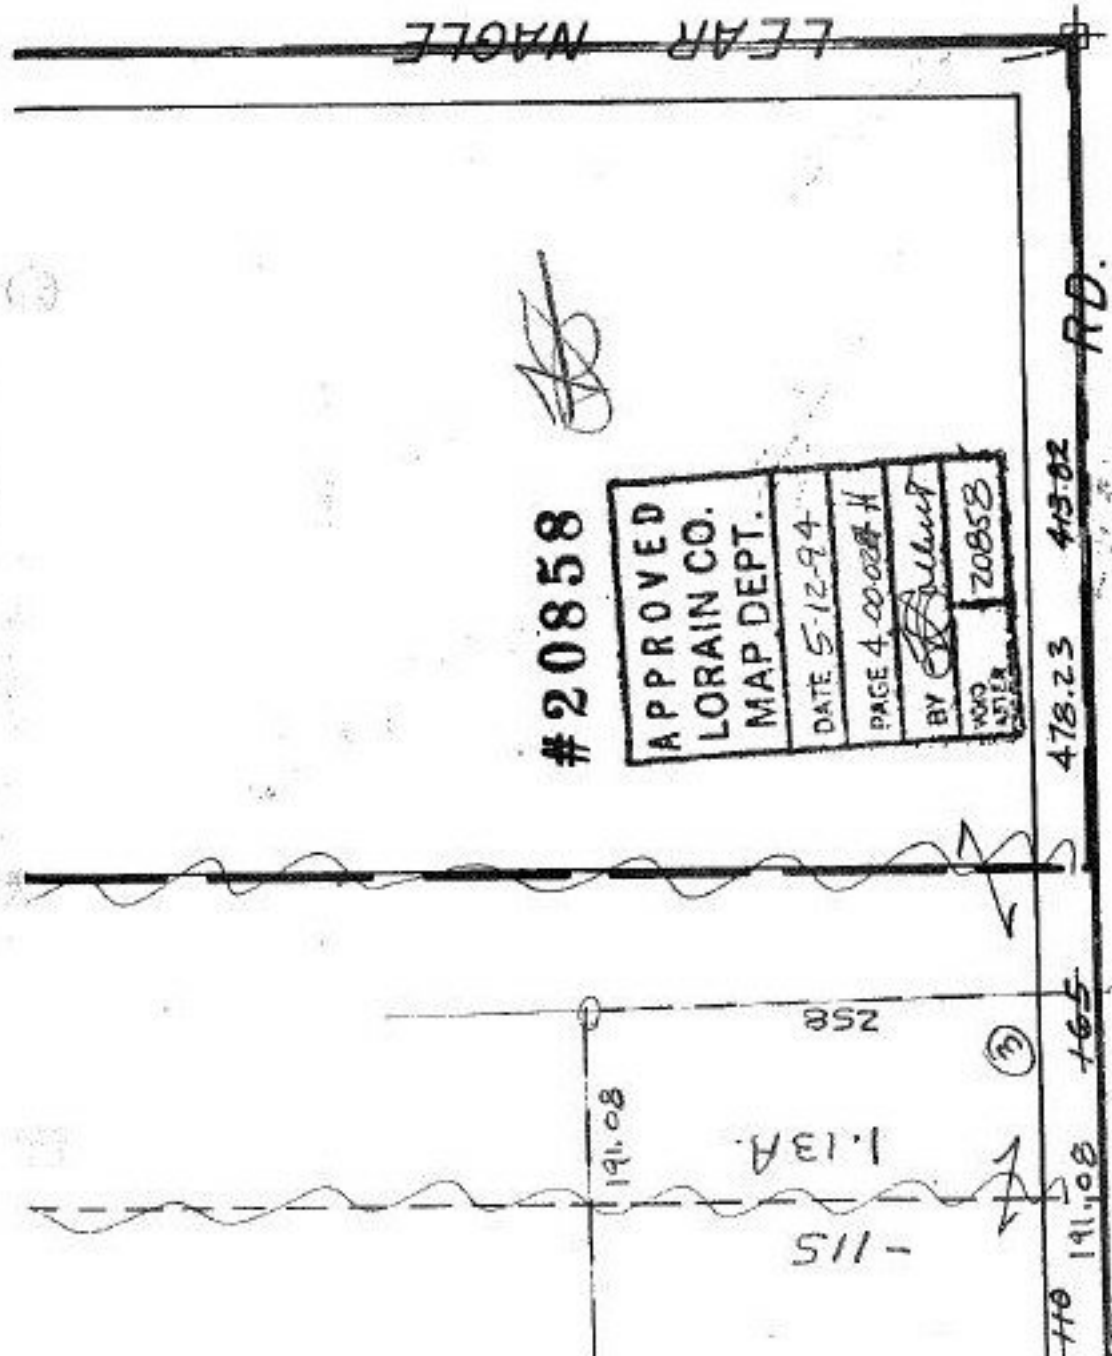

#20858

APPROVED  
LORAIN CO.  
MAP DEPT.

DATE 5-12-94

PAGE 4-00-024-H

BY *[Signature]*

NOO  
AFTER  
20858

*[Handwritten scribble]*