


2086

2087

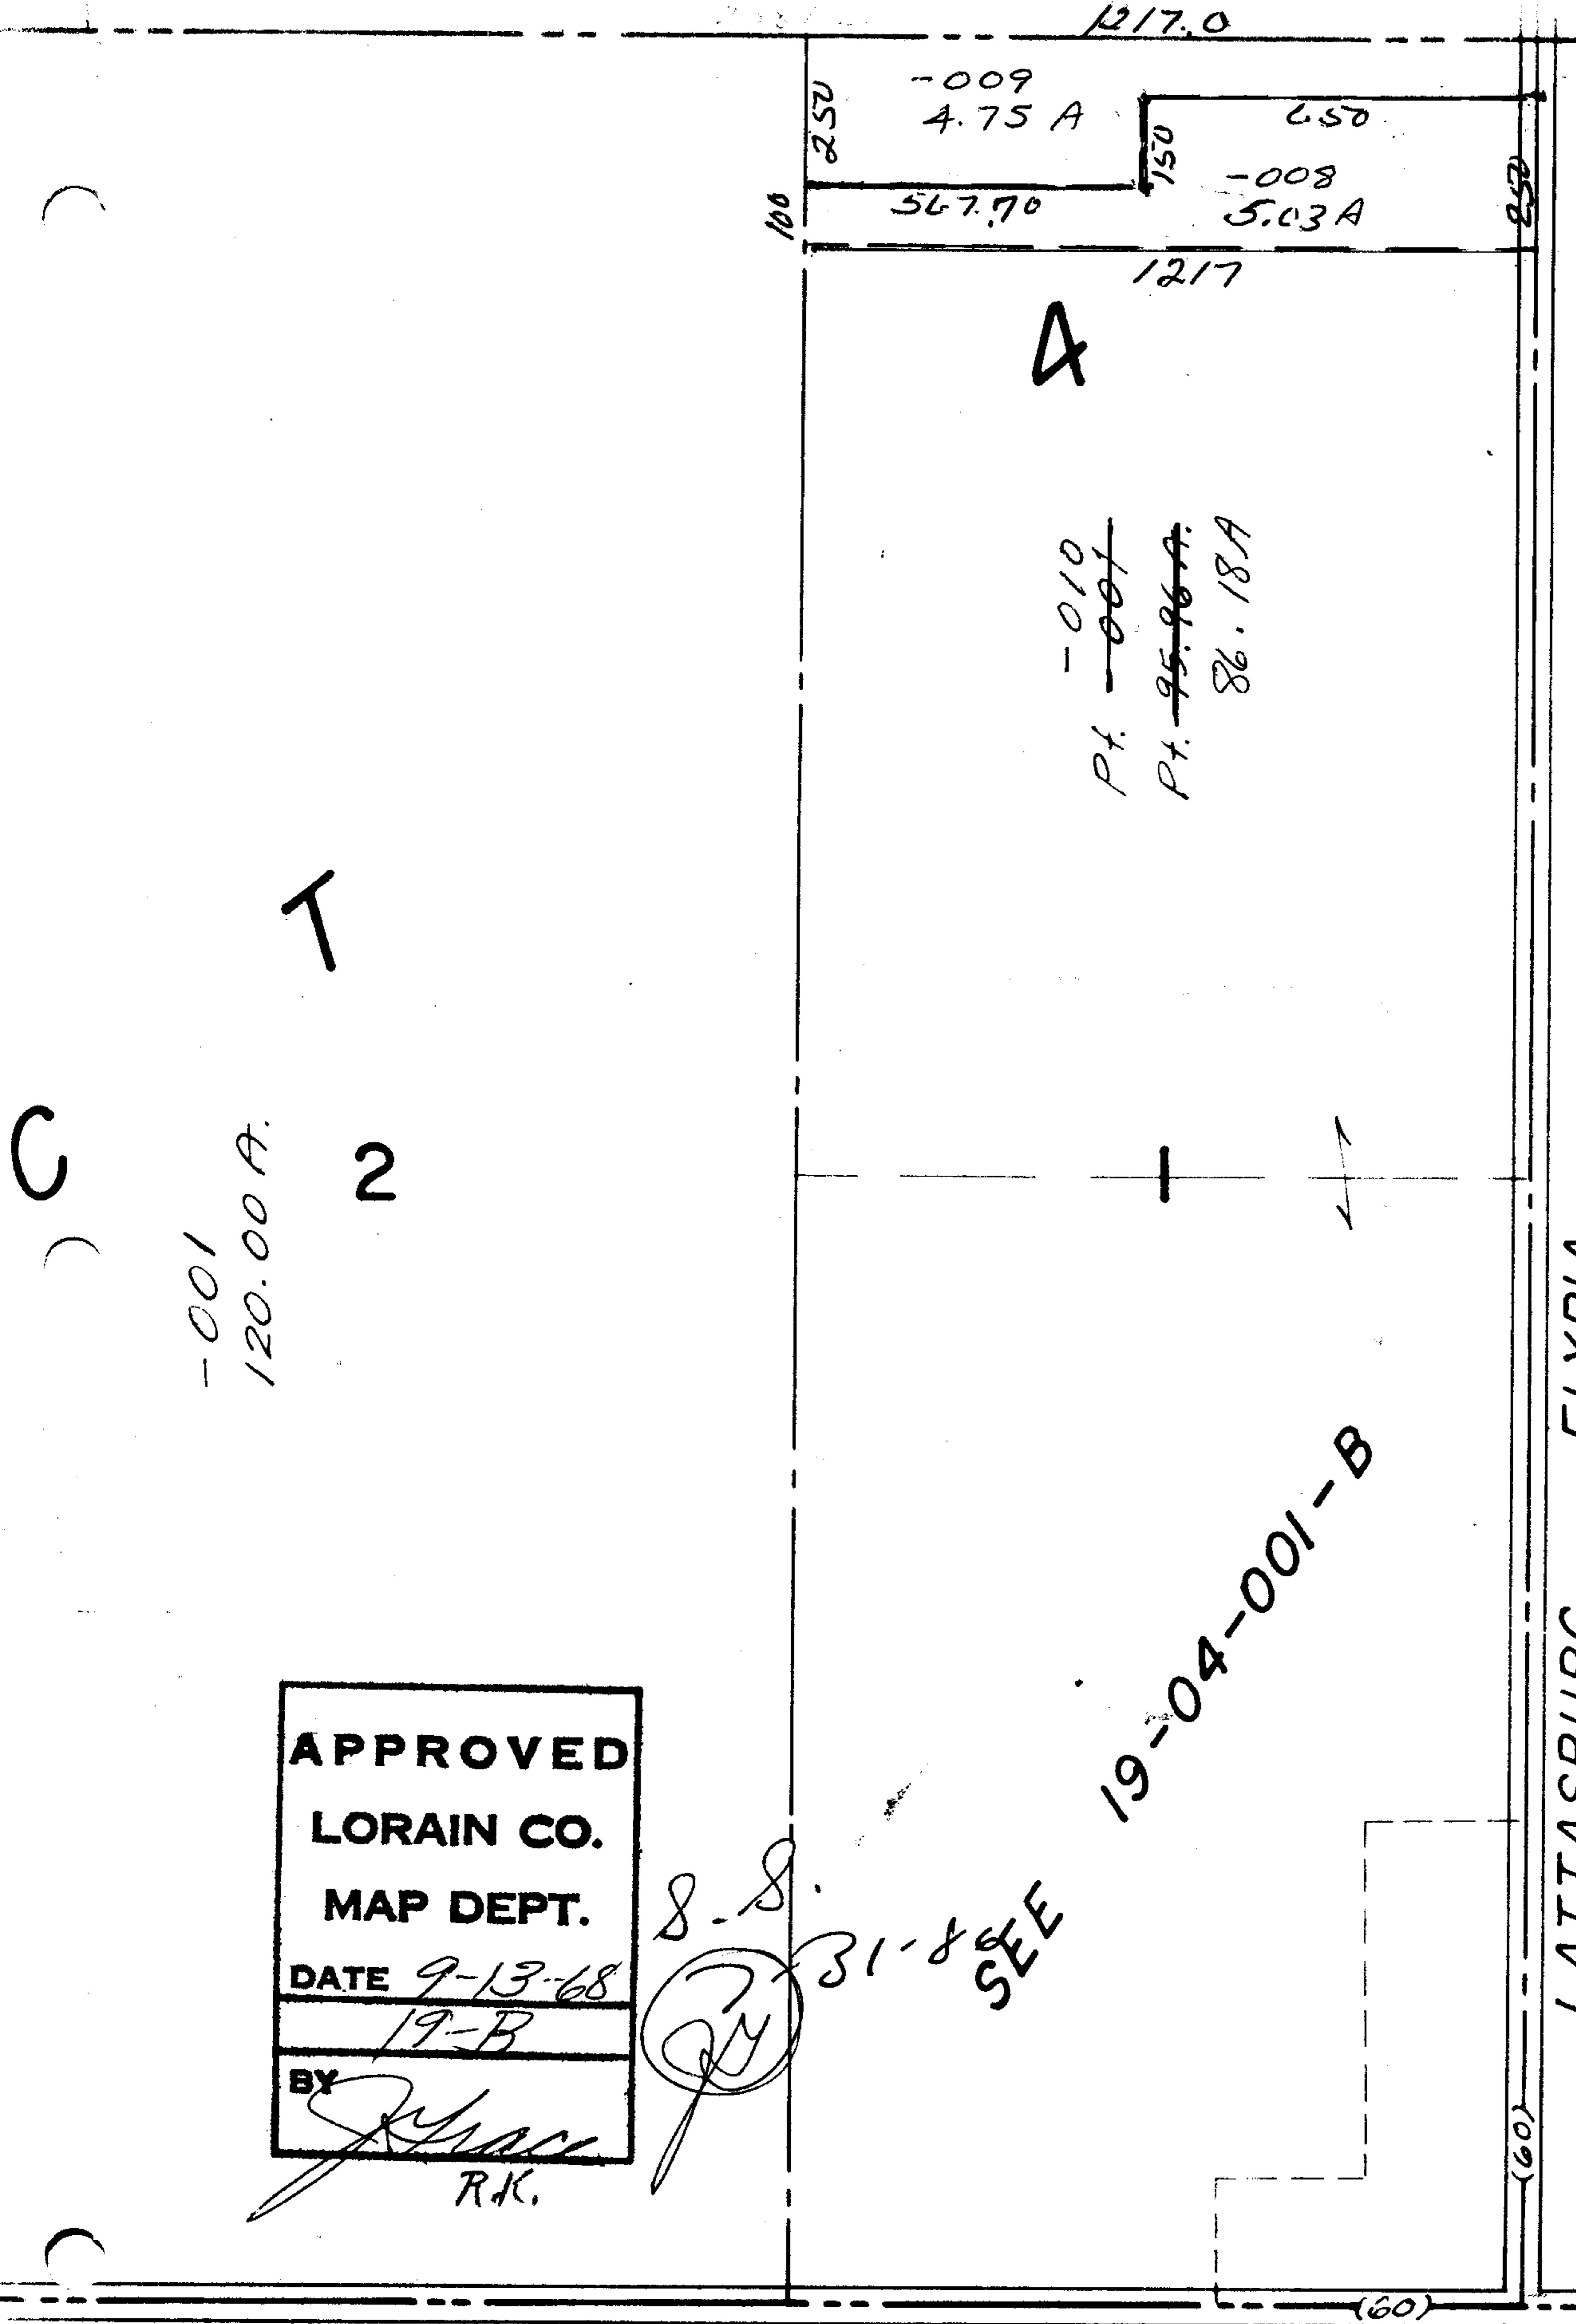

APPROVED  
 LORAIN CO.  
 MAP DEPT.  
 DATE 9-13-68  
 19-B  
 BY *R.K.*  
 R.K.

*S.S.*  
 31-8  
 SEE

19-04-001-B

4

T

2

-001  
 120.00 A.

-009  
 4.75 A

567.70

-008  
 5.03 A

-010  
 Pt. ~~001~~

Pt. 95.96 A.  
 86.18 A

1217.0

1217

RD.

LATTASBURG - ELYRIA

301

18

CT 4 LOTS 1, 2, ELY. PT. 3  
 5 " 9 THRU 12

19-B