


BURSLEY

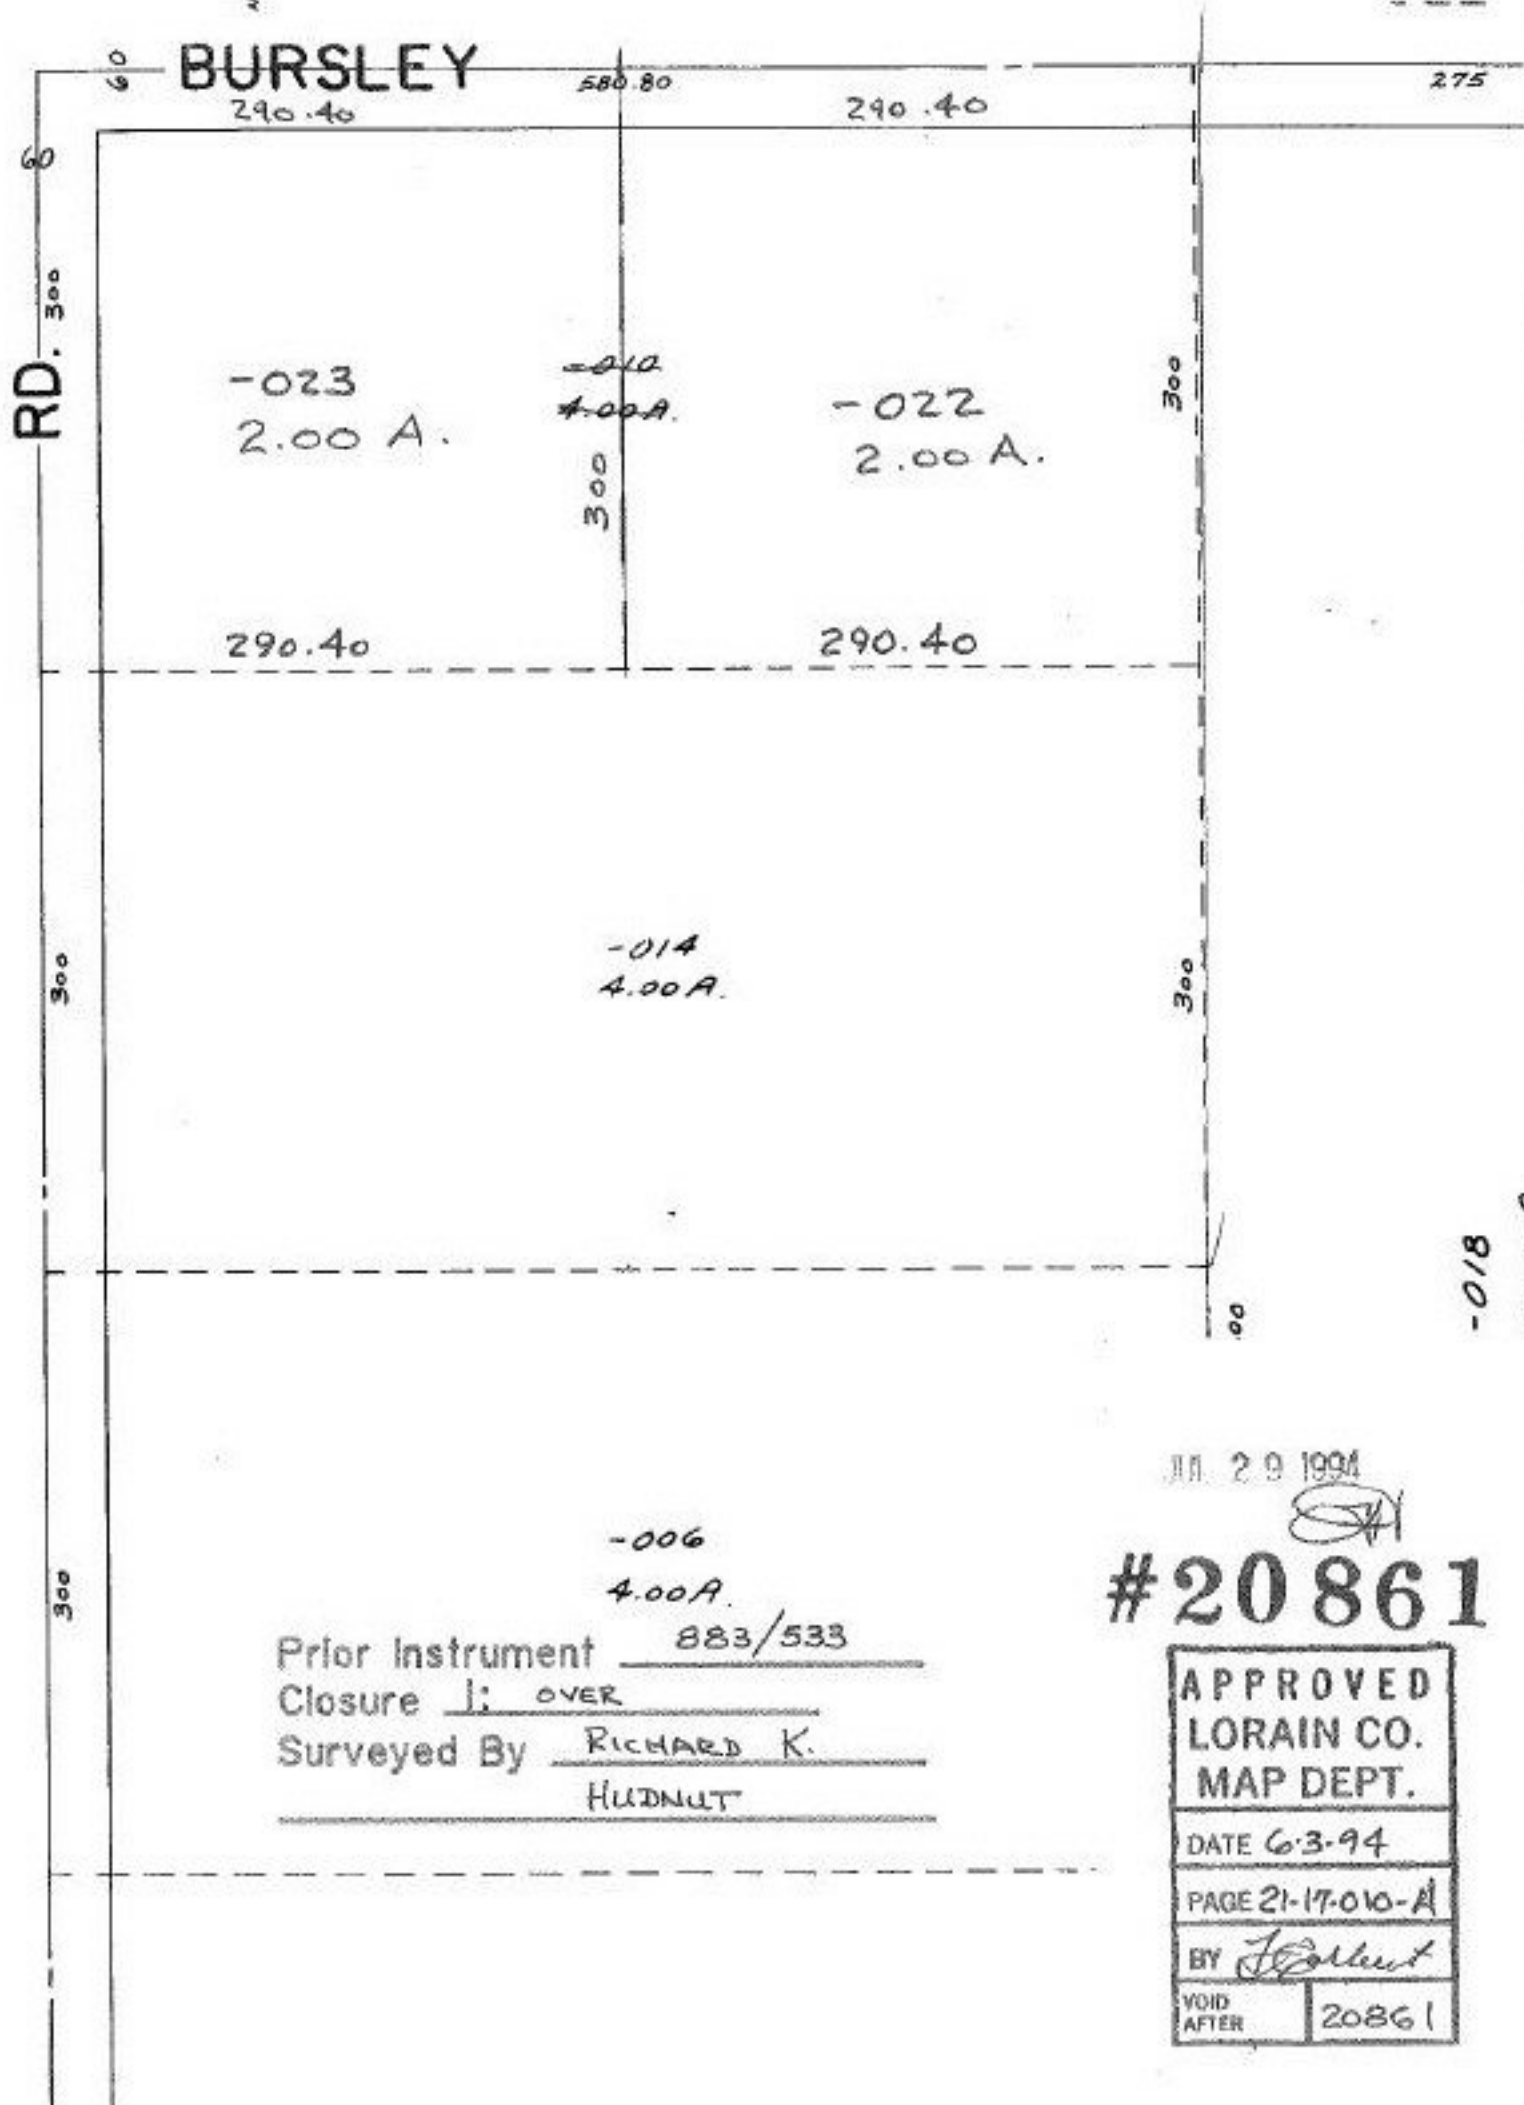

-018
7.54 A

JUL 29 1994

#20861

-006
4.00 A.
Prior Instrument 883/533
Closure 1: OVER
Surveyed By RICHARD K. HUDNUT

APPROVED LORAIN CO. MAP DEPT.	
DATE 6-3-94	
PAGE 21-17-010-A	
BY <i>J. Collett</i>	
VOID AFTER	20861