
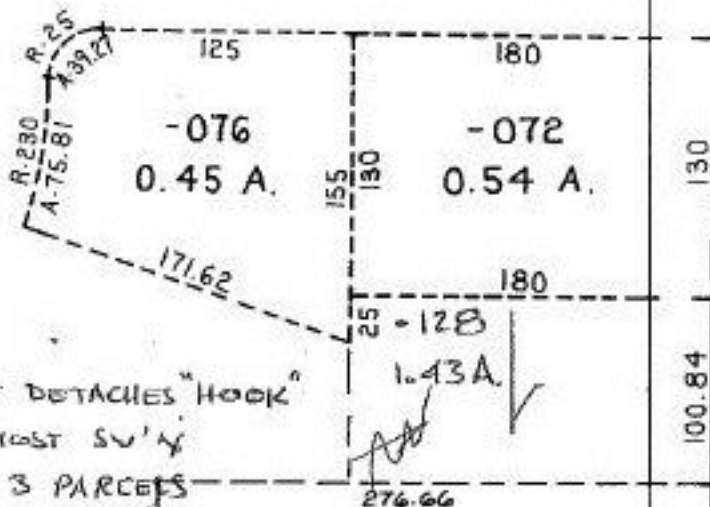


421 22 PLAT


SURVEYED BY -
 NORMAN R. HURA, BS 4712
 MICHAEL G.
 CL. 1: 2E, 289
 PRIOR INST. OR 479/72B

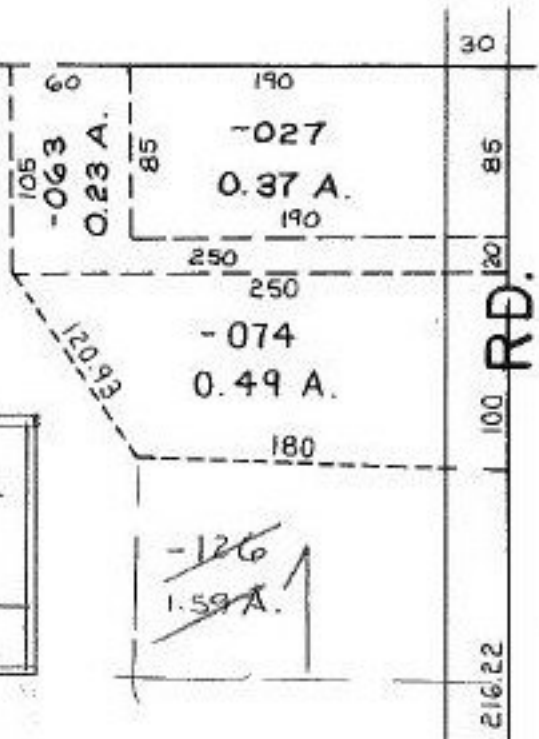

* THIS SPLIT DETACHES "HOOK"
 FROM THE MOST SW'LY
 PORTION OF 3 PARCELS
 CONNECTED TOGETHER
 THAT FORM THE
 REMAINDER OF
 P.V. 53/14
 149.65

ARC
 R = 322.57
 Ch = 20.44
 A = 20.44

-127 0.16 A.
 150.00
 FRONTAGE = E. R/W LINE
 OF WHEATON DR. PER
 P.V. 53/14
 COLLEGE HEIGHTS SUB. No. 1

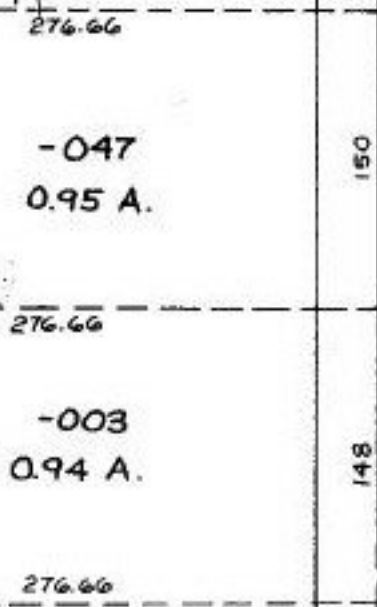

9-14-94
 #20869

APPROVED
 LORAIN CO.
 MAP DEPT.
 DATE 6-6-94
 PAGE 3-00-012-B
 BY T. McHain
 VOID AFTER 20869