

Prior Instrument DV 1341/B 3  
 Closure I: 797,228  
 Surveyed By DONALD WOIKE # 5547  
 H.G. RENTZ ENG. CO., JULY 1993

399.1

104

-055  
 9.05 Ac.

~~-052~~  
~~18.44 Ac.~~

935.67

~~-052~~  
~~18.44 A.~~


-054  
 9.39 Ac.

SPY 9-1-94  
 #20874

APPROVED	
LORAIN CO. MAP DEPT.	
DATE	6/6/94
PAGE	12-00 078-B
BY	T. McMain
WORD AFTER	20874

SEE COL CORNER  
 I.P. Fol. of Used

781.14

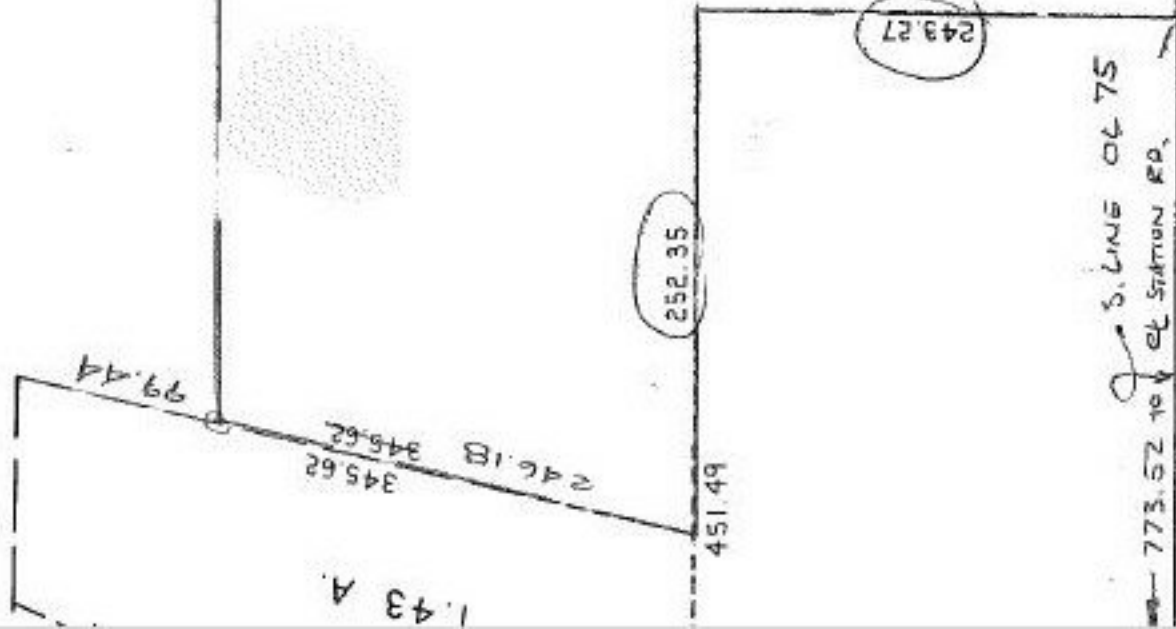

SEE 12-E