

2088

410.50

-004  
23.40R.

-008  
3.60R.

369.69

2232


Pt. 5.32R.  
Pt. 4.91R.  
SEE  
12.F  
Pt. 10.00R.  
631.50

-011  
31.70R.

-005  
10.00R.

Pt. -005  
Pt. 55.21R.


363

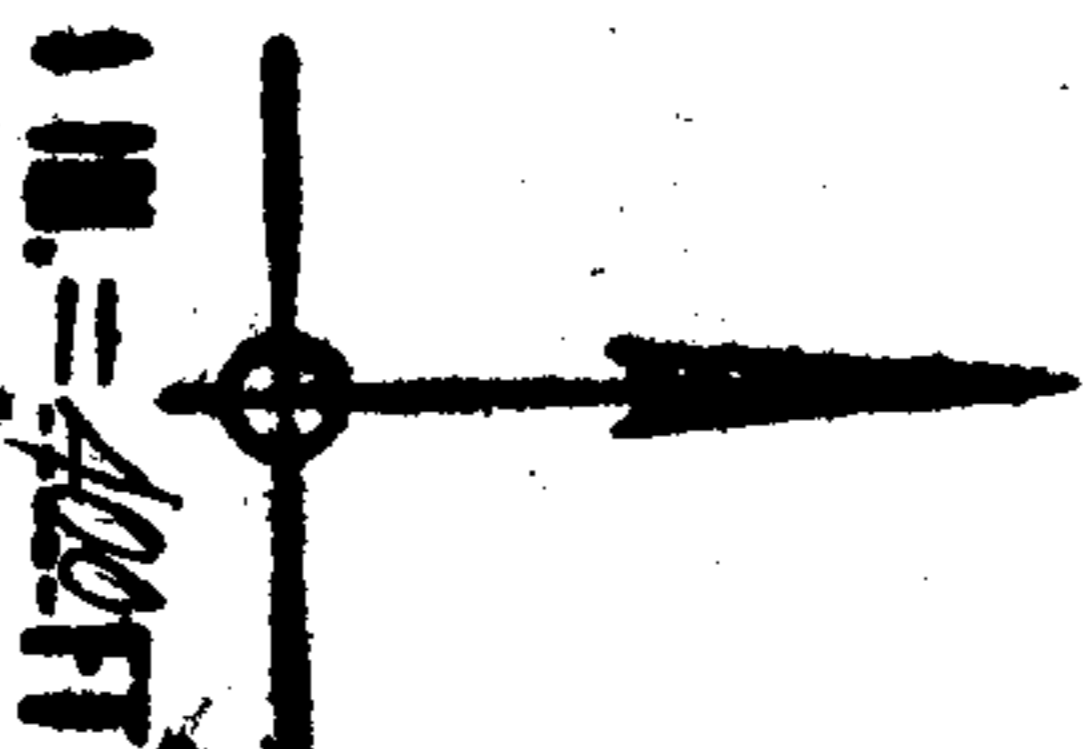

JAN 22 1969

APPROVED  
LORAIN CO.  
MAP DEPT.  
DATE 9-11-68  
BY [Signature]

Pt. -010  
Pt. 37.69R.

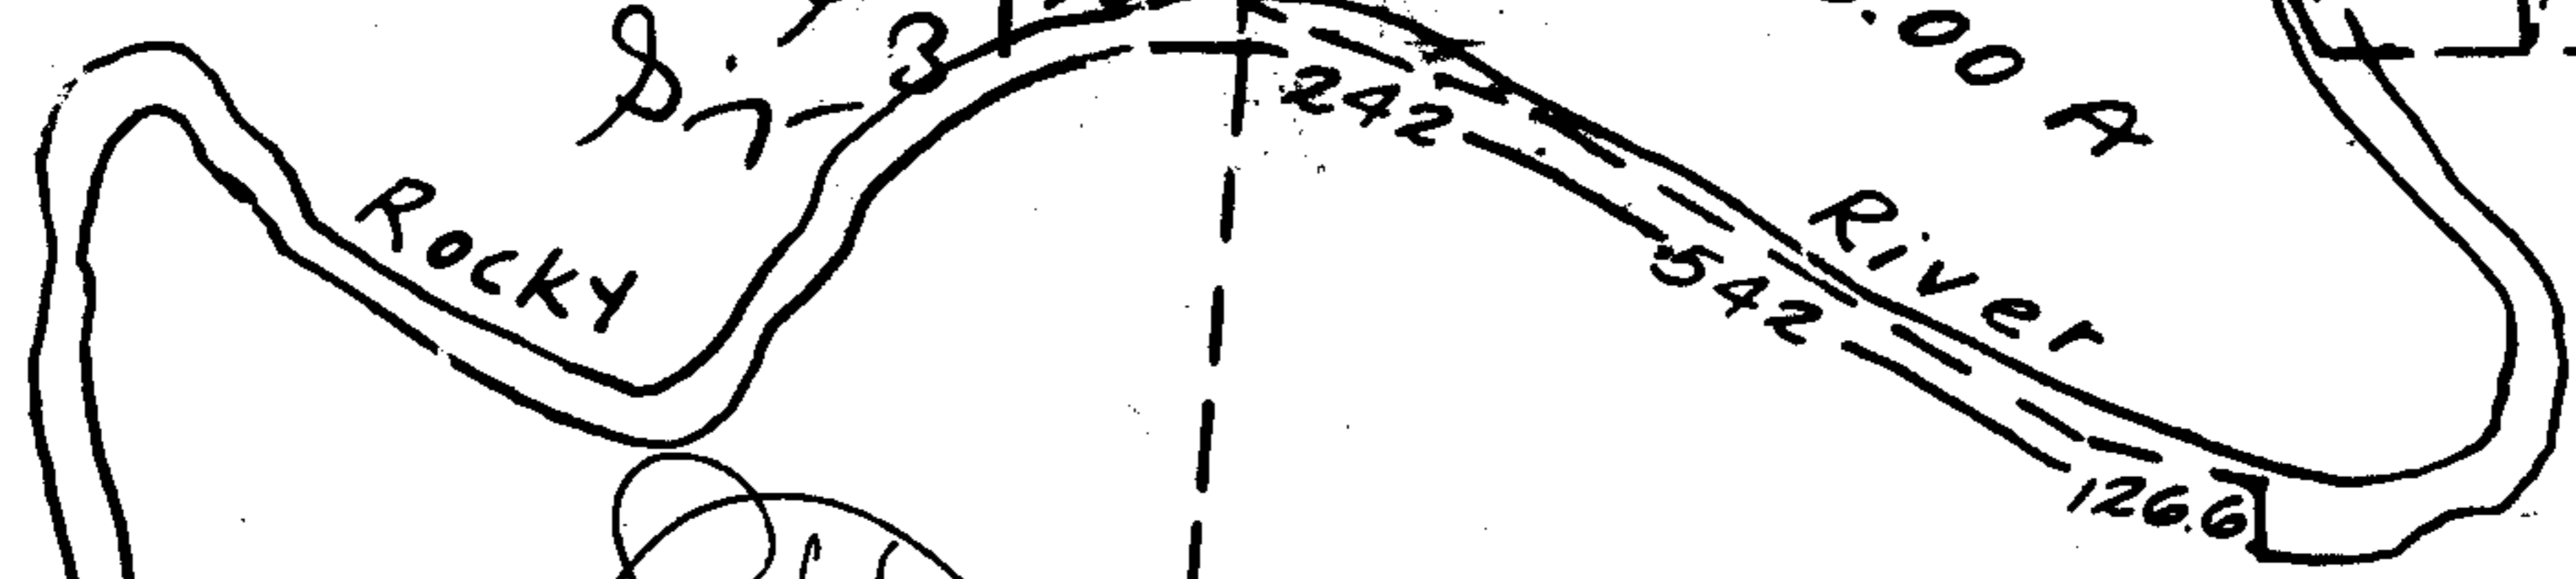

6.00 A  
River

50

~~37.15R.~~  
~~31.38R.~~  
~~32.94~~

32.89

-003  
50.29R.

33.33.42

Don't Cross out

7.90R.  
7.80  
6.95.08

-011  
4.10A

-003  
9.87R.

MALLET CREEK

BAY VILLAGE

Copyright 1962  
Revised 8-6-68

12-G

COLUMBIA TWP.

252

SCALE