


65.05 A.

Pt. 10-00-022
Pt. 11.65

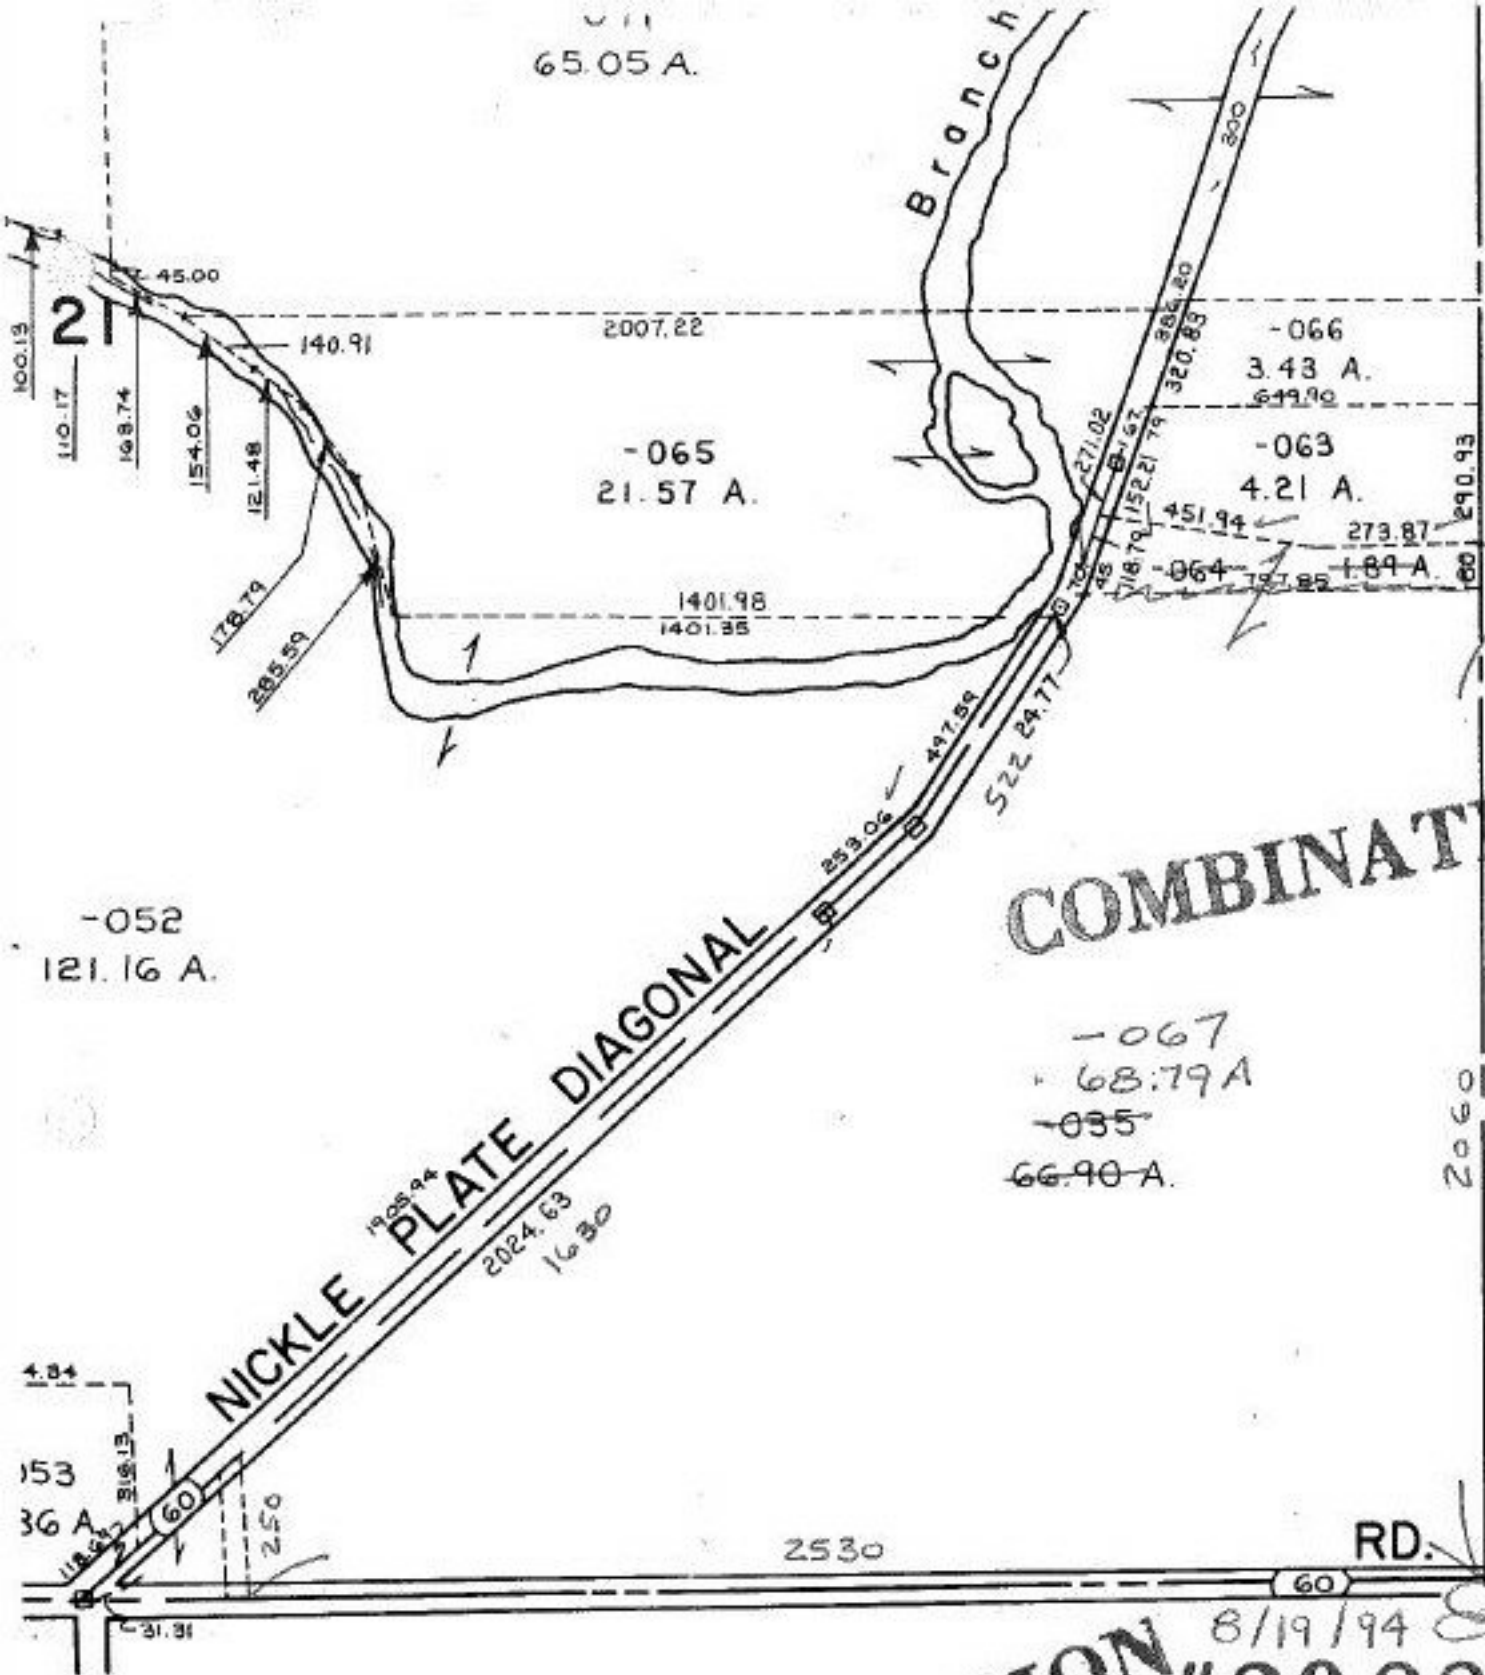

COMBINATION

COMBINATION #20884

8/19/94

APPROVED LORAIN CO. MAP DEPT.	
DATE 6-15-94	
PAGE 10-E	
BY <i>[Signature]</i>	
VOID L/FR	20884