


1415.

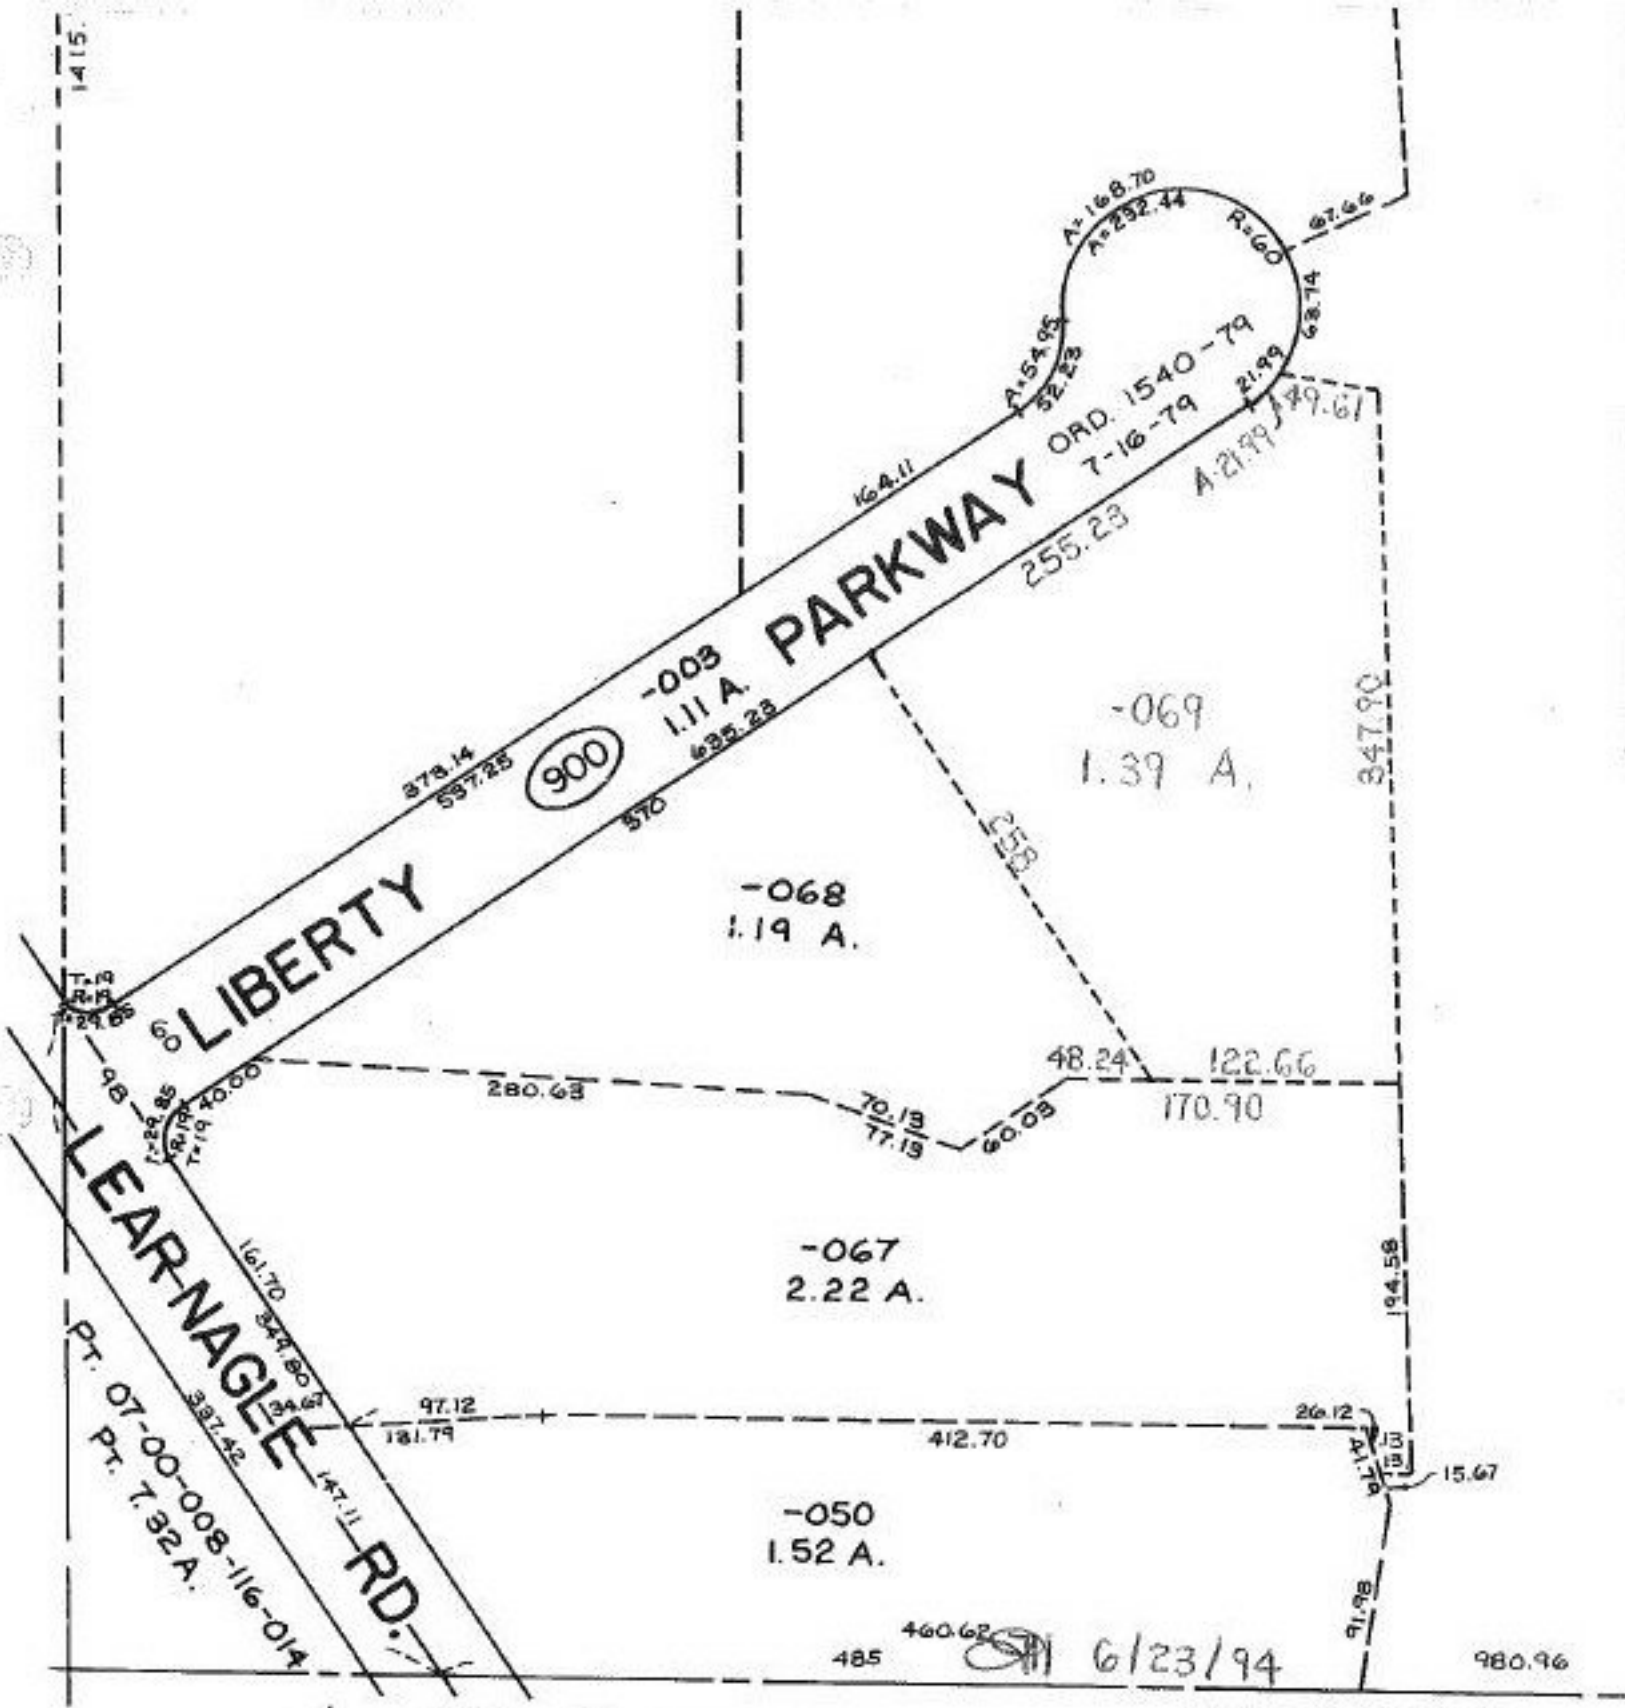

ADD TO DUPLICATE

#20885-X SEE

PARCEL ADDED TO DUPLICATE PER CONDO. VACATION - SEE TICKET NO. #20698-V.

| |
|-----------------|
| APPROVED |
| LORAIN CO. |
| MAP DEPT. |
| DATE 6/2/94 |
| PAGE 7-00-008-D |
| BY T. HOLLIS |
| VOID AFTER |
| 20885-X |