


DEED CHECK

20894-D

LORAIN

ST. O

Prospect

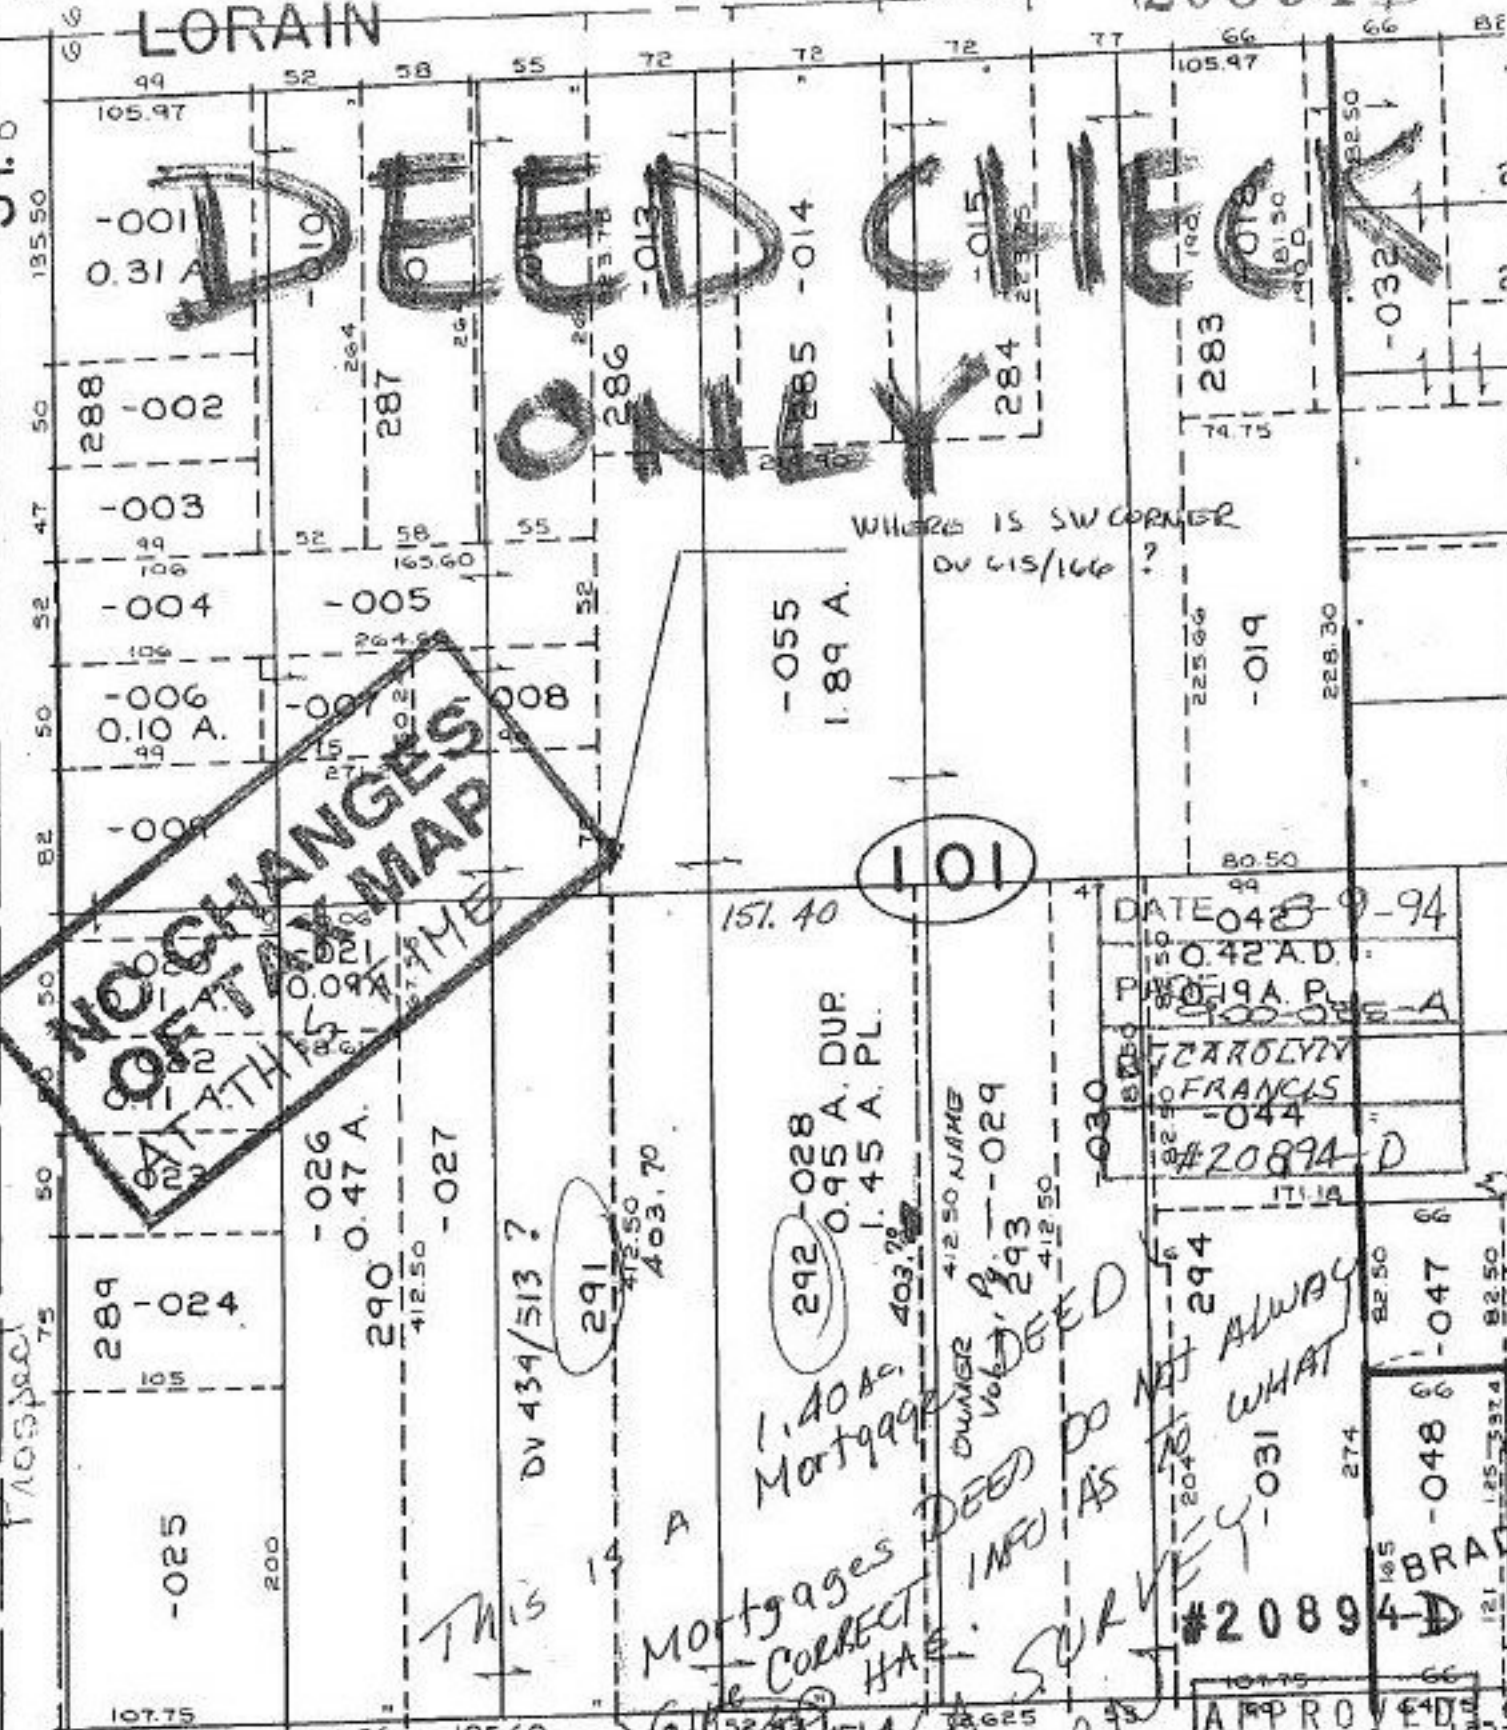

NO CHANGES OF TAX MAPS AT THIS TIME

DEED ONLY

WHERE IS SW CORNER DV 415/166?

101

DATE	04-29-94
PAGE	042 A.D.
OWNER	FRANCIS CAROLYN
	FRANCIS
	#20894-D

Mortgages COLLECT HAVE SURVEY
 OWNER Voted 293
 DEED INFO AS DO NOT ALWAYS WHAT

COLLEGE

APPROVED	
LORAIN CO.	
DATE	8/9/94
PAGE	
BY	E. FRANCIS
VOID	#20894-D

This is not a correct description

1000 N.