

175.65

345.84


353.76

352.70

PT. 11.36A.

NO CLAIMS
OR TAX MAP

PT. -046
PT. 30.15A.

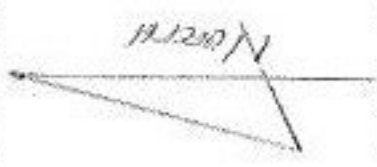

SCALE 2 1/2" = 100'
Reduced

1180.26

REF - DV 117/253 parcel #2

-016
9.62A. Ac. PER DV. 551/104

ACCORR TO DUP.
& REG ONLY

DEED
CHECK

20896-D

APPROVED LORAIN CO. MAP DEPT
DATE 12-19-94
PAGE 000-001-A/1
BY CAROLYN FRANKS
20896-D

DV. 117/253,4

SEE 10-00-001-E

COMPLETING PAPER WORK FOR AC. CORRECTION
DONE. 9-26-72 info. was not put in REG.
REG. COMPLETED 6-20-94. PAPER WORK COMPLETED
12-19-94. TAX MAP OK. PAPER WORK DONE PER
CORRECTION SHEET DATED 9-26-72 SPLIT NO. 6349
dv. 551/104 - 018 WAS CORRECTED ONLY



10-00-001-A

CARLISLE TOWN

SH 6/18/95