

SEE 10-00-008-B

301


THESE LINES REVICATED (SHIFTED SOUTH) PER JOHN ROZYNAK Certificate of correction FILED in ~~1988~~ OR 8/11/131

NEW LINES REVICATED PER REFINED DESCRIPTION FOR -052 SO ADJUTANT OWNER ON 1.91 AC. PARCEL IS PROPERLY REFERENCED CHISEL DESCRIPTION WITH RECORD DV 1400/400

~~PT -053~~
~~PT 61.77 A.~~

F4. -057
Pt. 59.85 A.

SEE SURVEY - JOHN ROZYNAK MAP REF. cert. of CORR ^{OR} 8/11/131 DV 1400/400 CC. I-11NF. PRIOR INST REF. DV 479/225

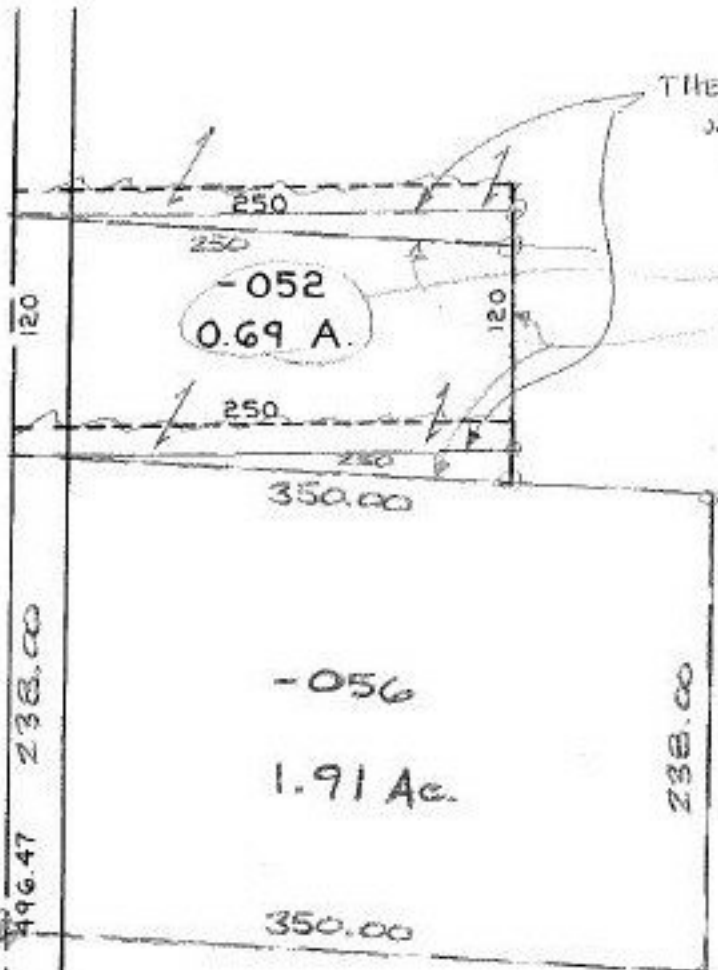

582.00

89°14'

30	159.53	50	"	"	"	"	"	"	"
68.51	1-007	68.50	50	"	"	"	"	"	"
160.45		136	3-009	4-010	5-049	6	7-013	8-014	9-015
67.50	2-008	67.50	50	"	"	"	"	"	"
161.35		100	"	"	"	"	"	"	"

CARLISLE

30	162.15	50	"	"	"	"	"	"	"
67.50	84-001	67.50	50	"	"	"	"	"	"
163.05		135.39	83-003	82-004	81-005	80-006S	79-007	78-008M	77-009
67.82	85-002	67.89	50	"	"	"	"	"	"
163.46		135.41	"	"	"	"	"	"	"

8/19/94
#20896

APPROVED. LORAIN CO. MAP DEPT. DATE 7-7-99 PAGE 10-00-008C BY T. McMain WHO AFTER 20896