

AL. BOARD OF EDUC. W. W. W. W.
AL. PUBLIC LIBRARY (2) (5)

ELECTRIC

SEE SURVEY -
K.S. ASSOC. P. ROSEBCK

(2)

① 1: 41, 84 ④ 1: 48, 207
 ② 1: 167, 058 ⑤ 1: 42, 961
 ③ 1: 326, 882 ⑥ 1: 27, 872

PRIOR INST REF.
DU 4800/252

-048
4.57 Ac.

144

NOTE -
ANGLE ON THIS LINE IS
BEING DISREGARDED IN
PREFERENCE TO S/L CALL


-049
2.93 Ac
3.38 Ac

482.47 DEED
482.5

#2089

APPROVED	LORAIN CO. MAP DEPT.
DATE	6-28-9
PAGE	400-018
BY	J. Mc...
VOID AFTER	2089

04-00-018-
VACATED DRUMMOND
PARNO CREATED AS ADD TO DUPLICATE

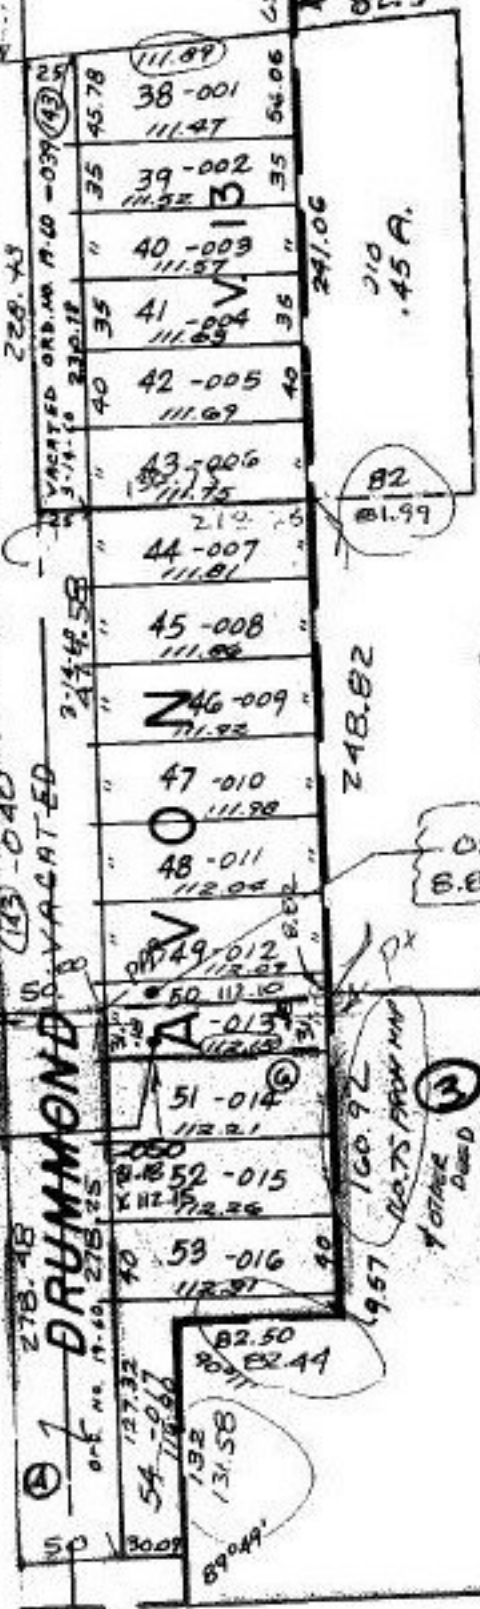

63.75
126.47
-021 .05
127.24
-019
1.25 A
420.91
-020
1.24 A

429.81
-022
1.22 A
122.71

