


ADD DISTANCES TO TAX MAP ONLY

20912-D
APPROVED LORAIN CO. MAP DEPT
DATE 1-1-95
PAGE 1-00-043A
BY T.M.C.F.
20912-D

-058
15.77 A.

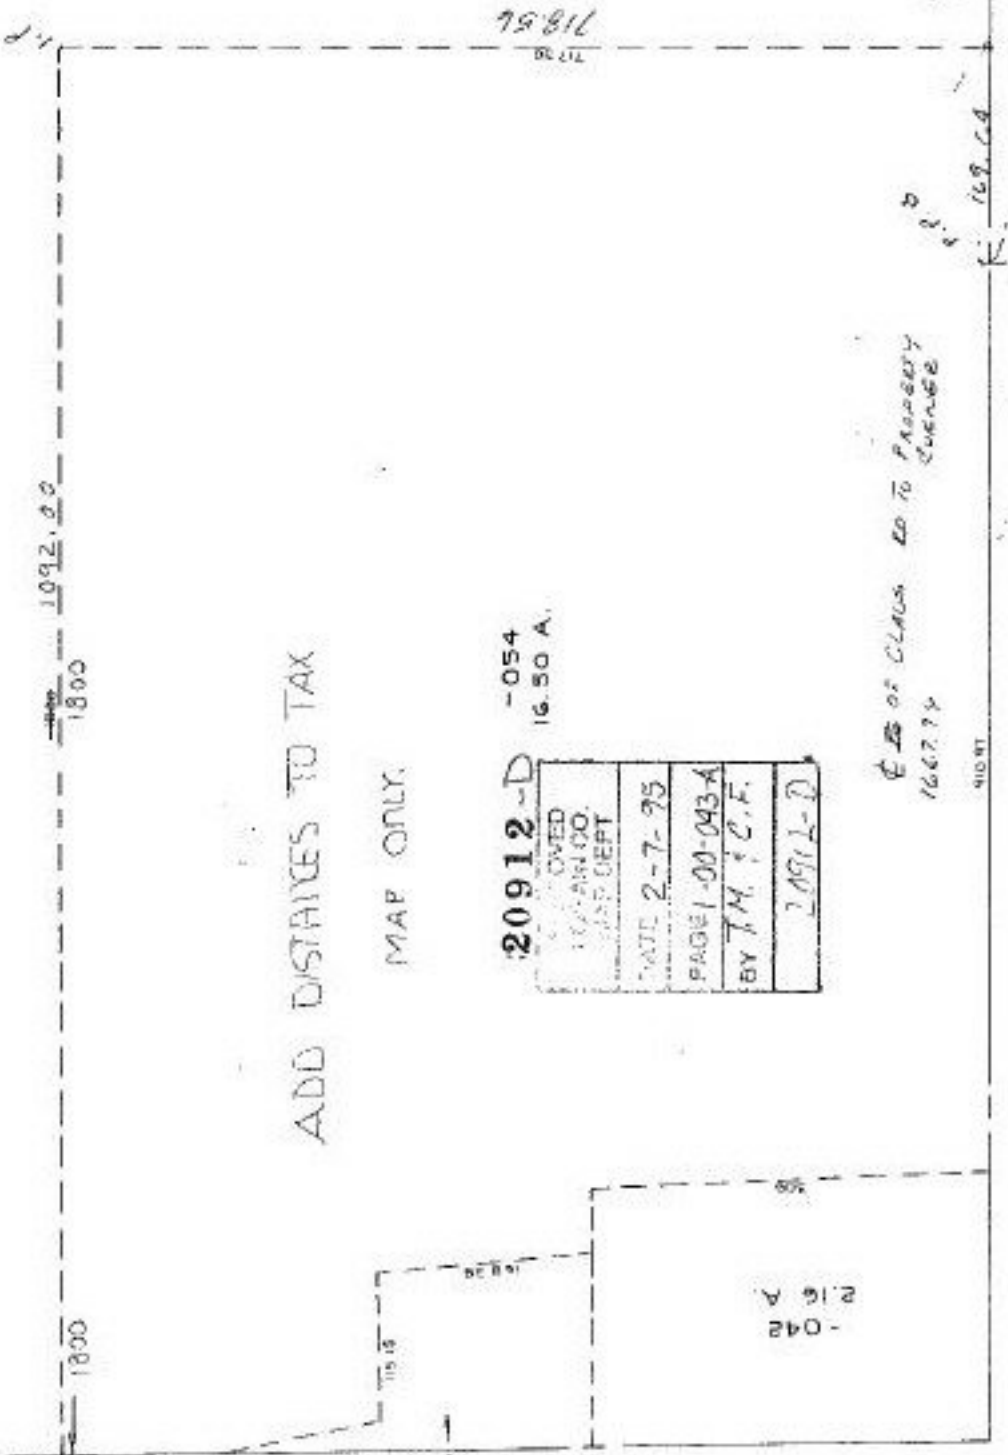

ADD DISTANCES TO TAX

MAP ONLY

-054
16.50 A.

20912-D
APPROVED LORAIN CO. MAP DEPT
DATE 2-7-95
PAGE 1-00-043A
BY T.M.C.F.
20912-D

E of CLAW. 10 to PROPERTY QUENBE
1667.74

169.64

343.39

-042
216.2