


20912-D

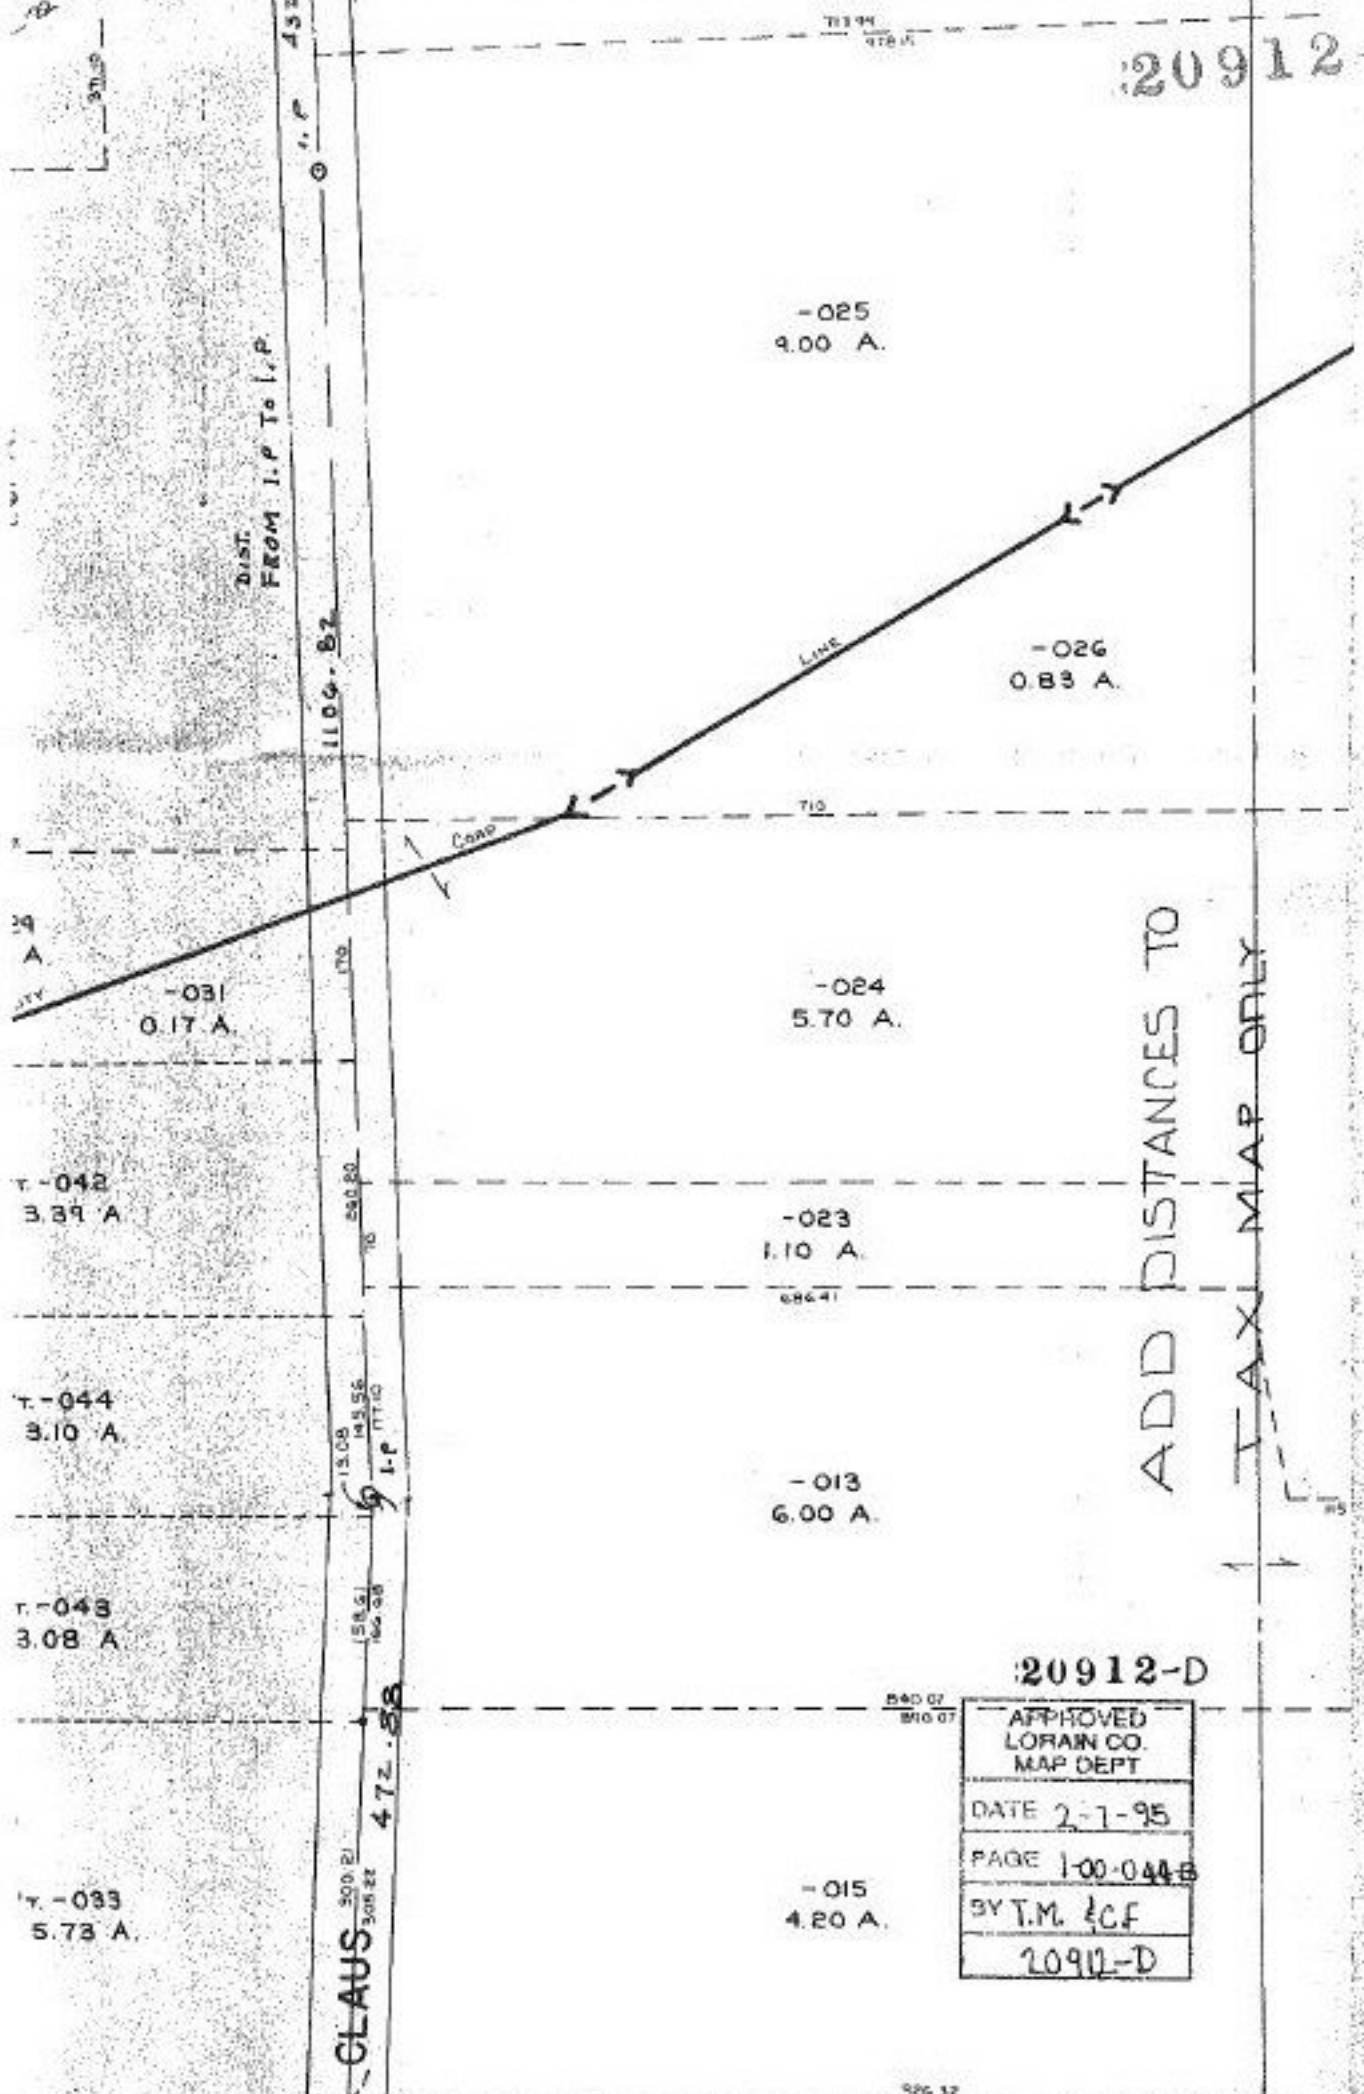

20912-D

APPROVED LORAIN CO. MAP DEPT
DATE 2-7-95
PAGE 100-044-B
BY T.M. ECF
20912-D